


PROPOSED ACOUSTIC ENCLOSURE DETAILS:

JAKOUSTIC ABSORPTIVE FENCING

LENGTH: 1300mm
WIDTH: 560mm
HEIGHT: 1500mm

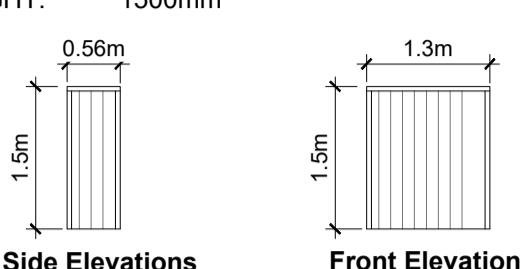

Absorptive Fencing
External Appearance

