






**NORTH ELEVATION**  
Scale 1:100

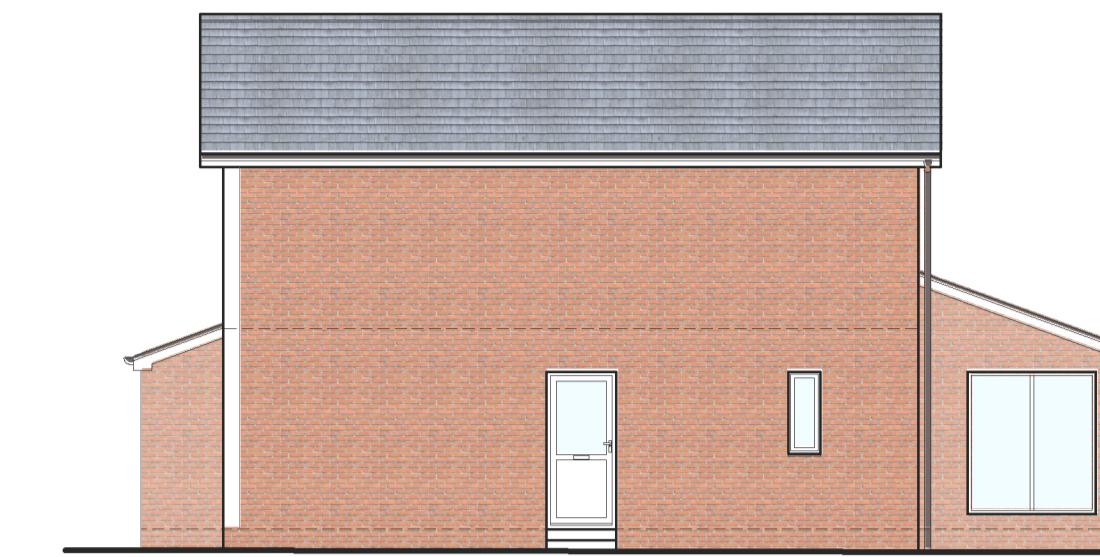


**WEST ELEVATION**  
Scale 1:100

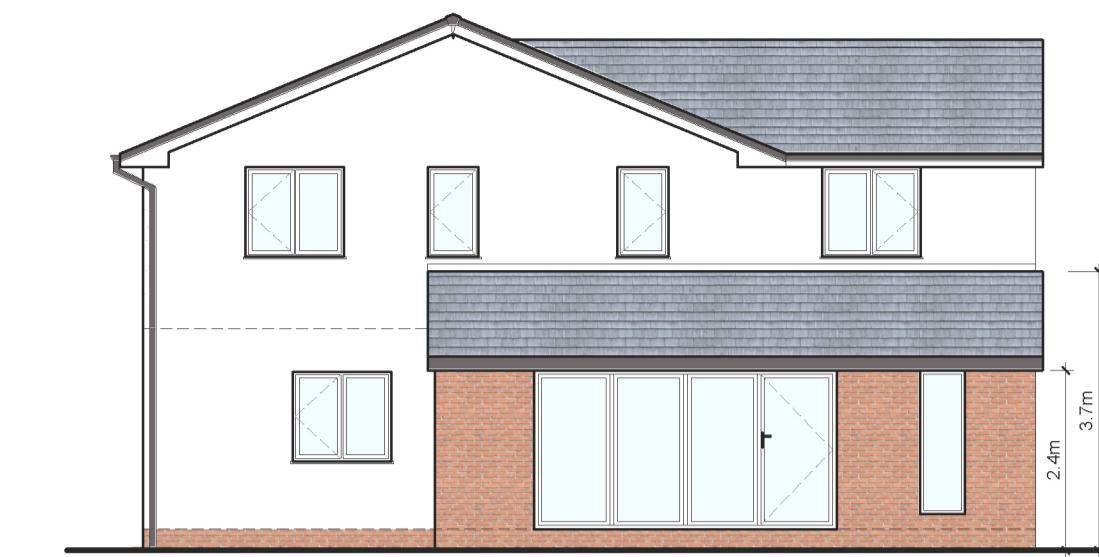

**SOUTH ELEVATION**  
Scale 1:100

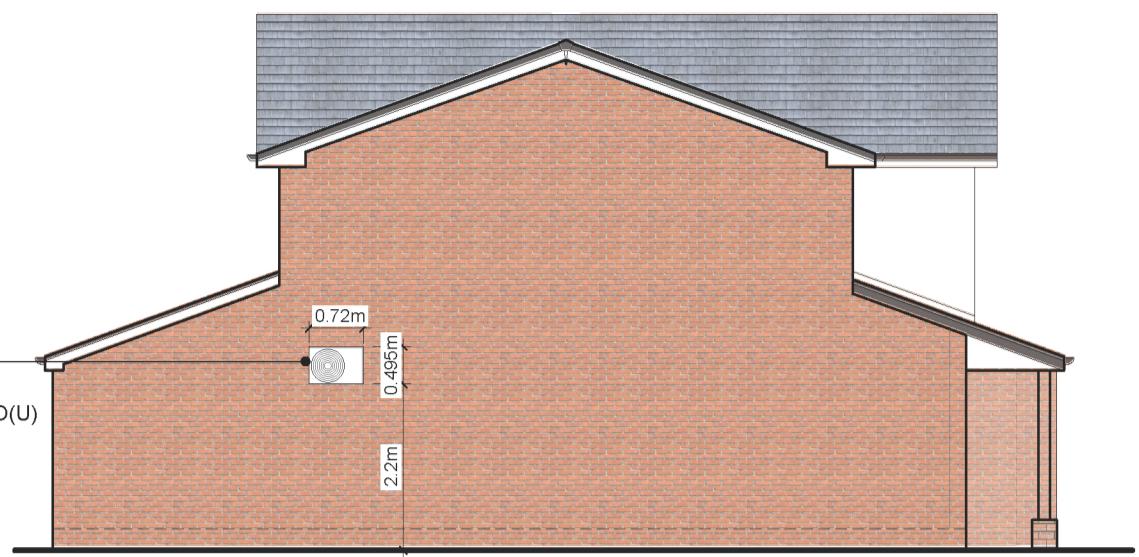


**EAST ELEVATION**  
Scale 1:100

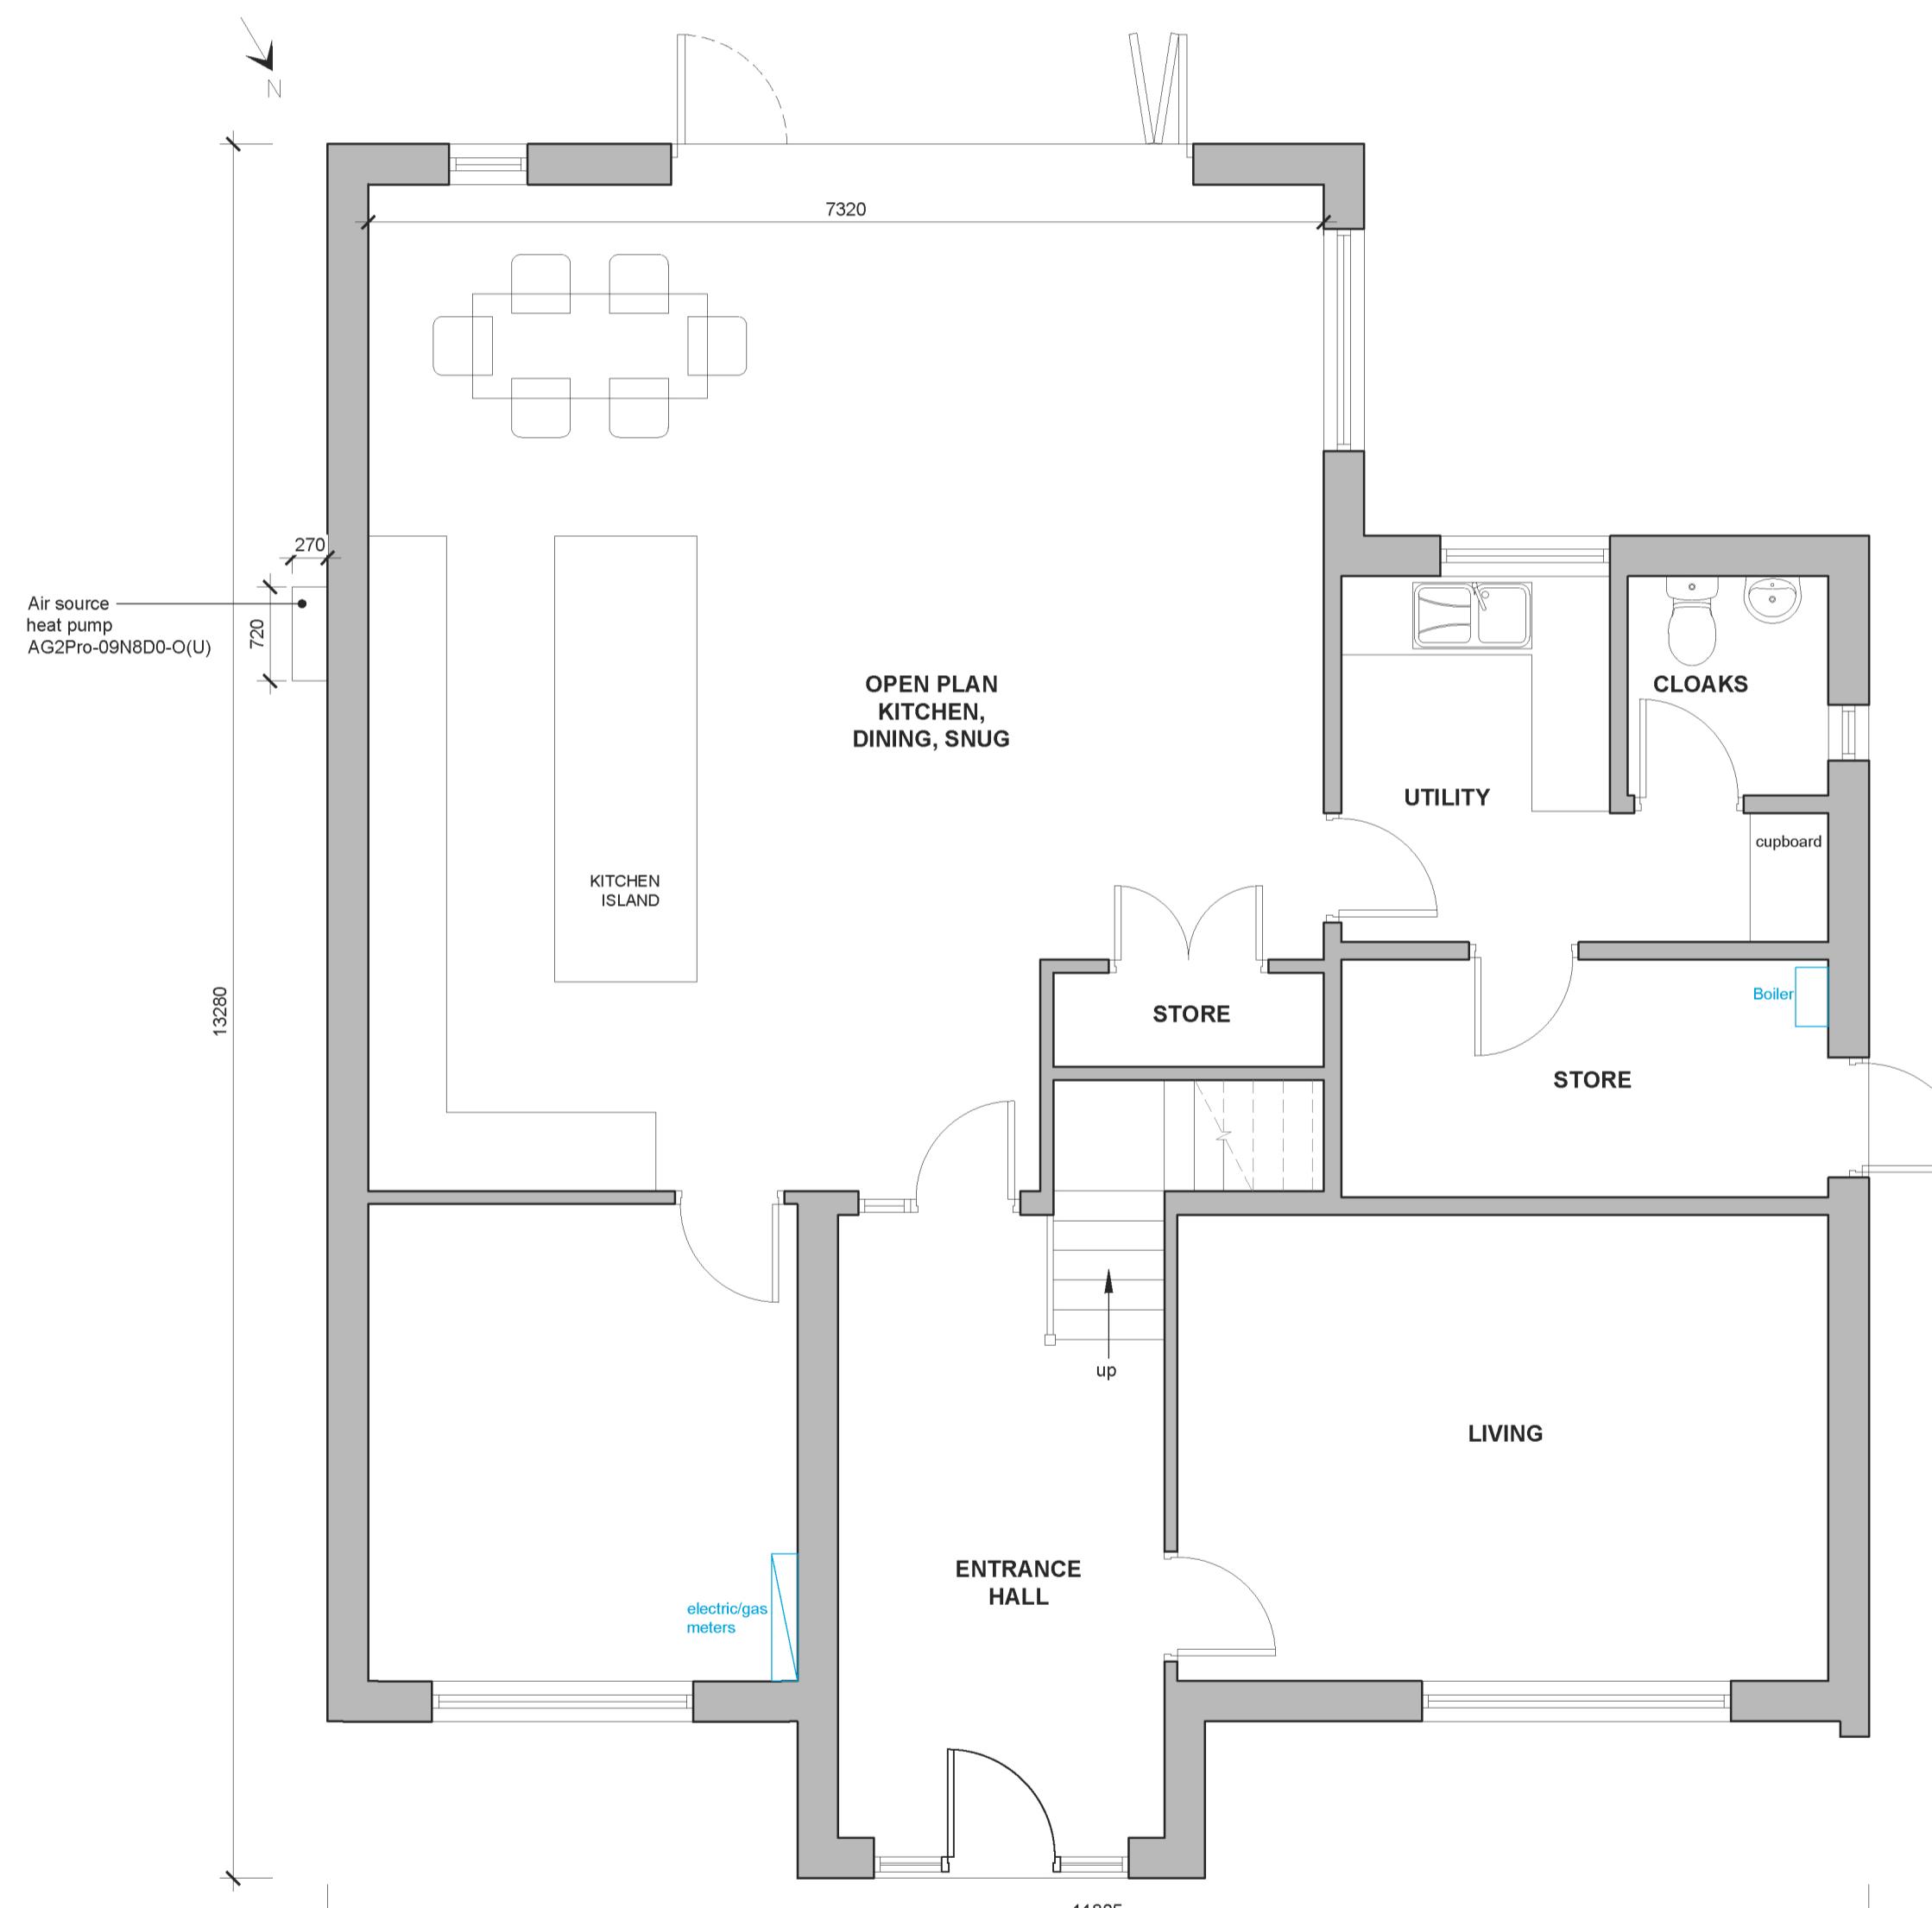

**GROUND FLOOR PLAN**  
Scale 1:50



**FIRST FLOOR PLAN**  
Scale 1:50

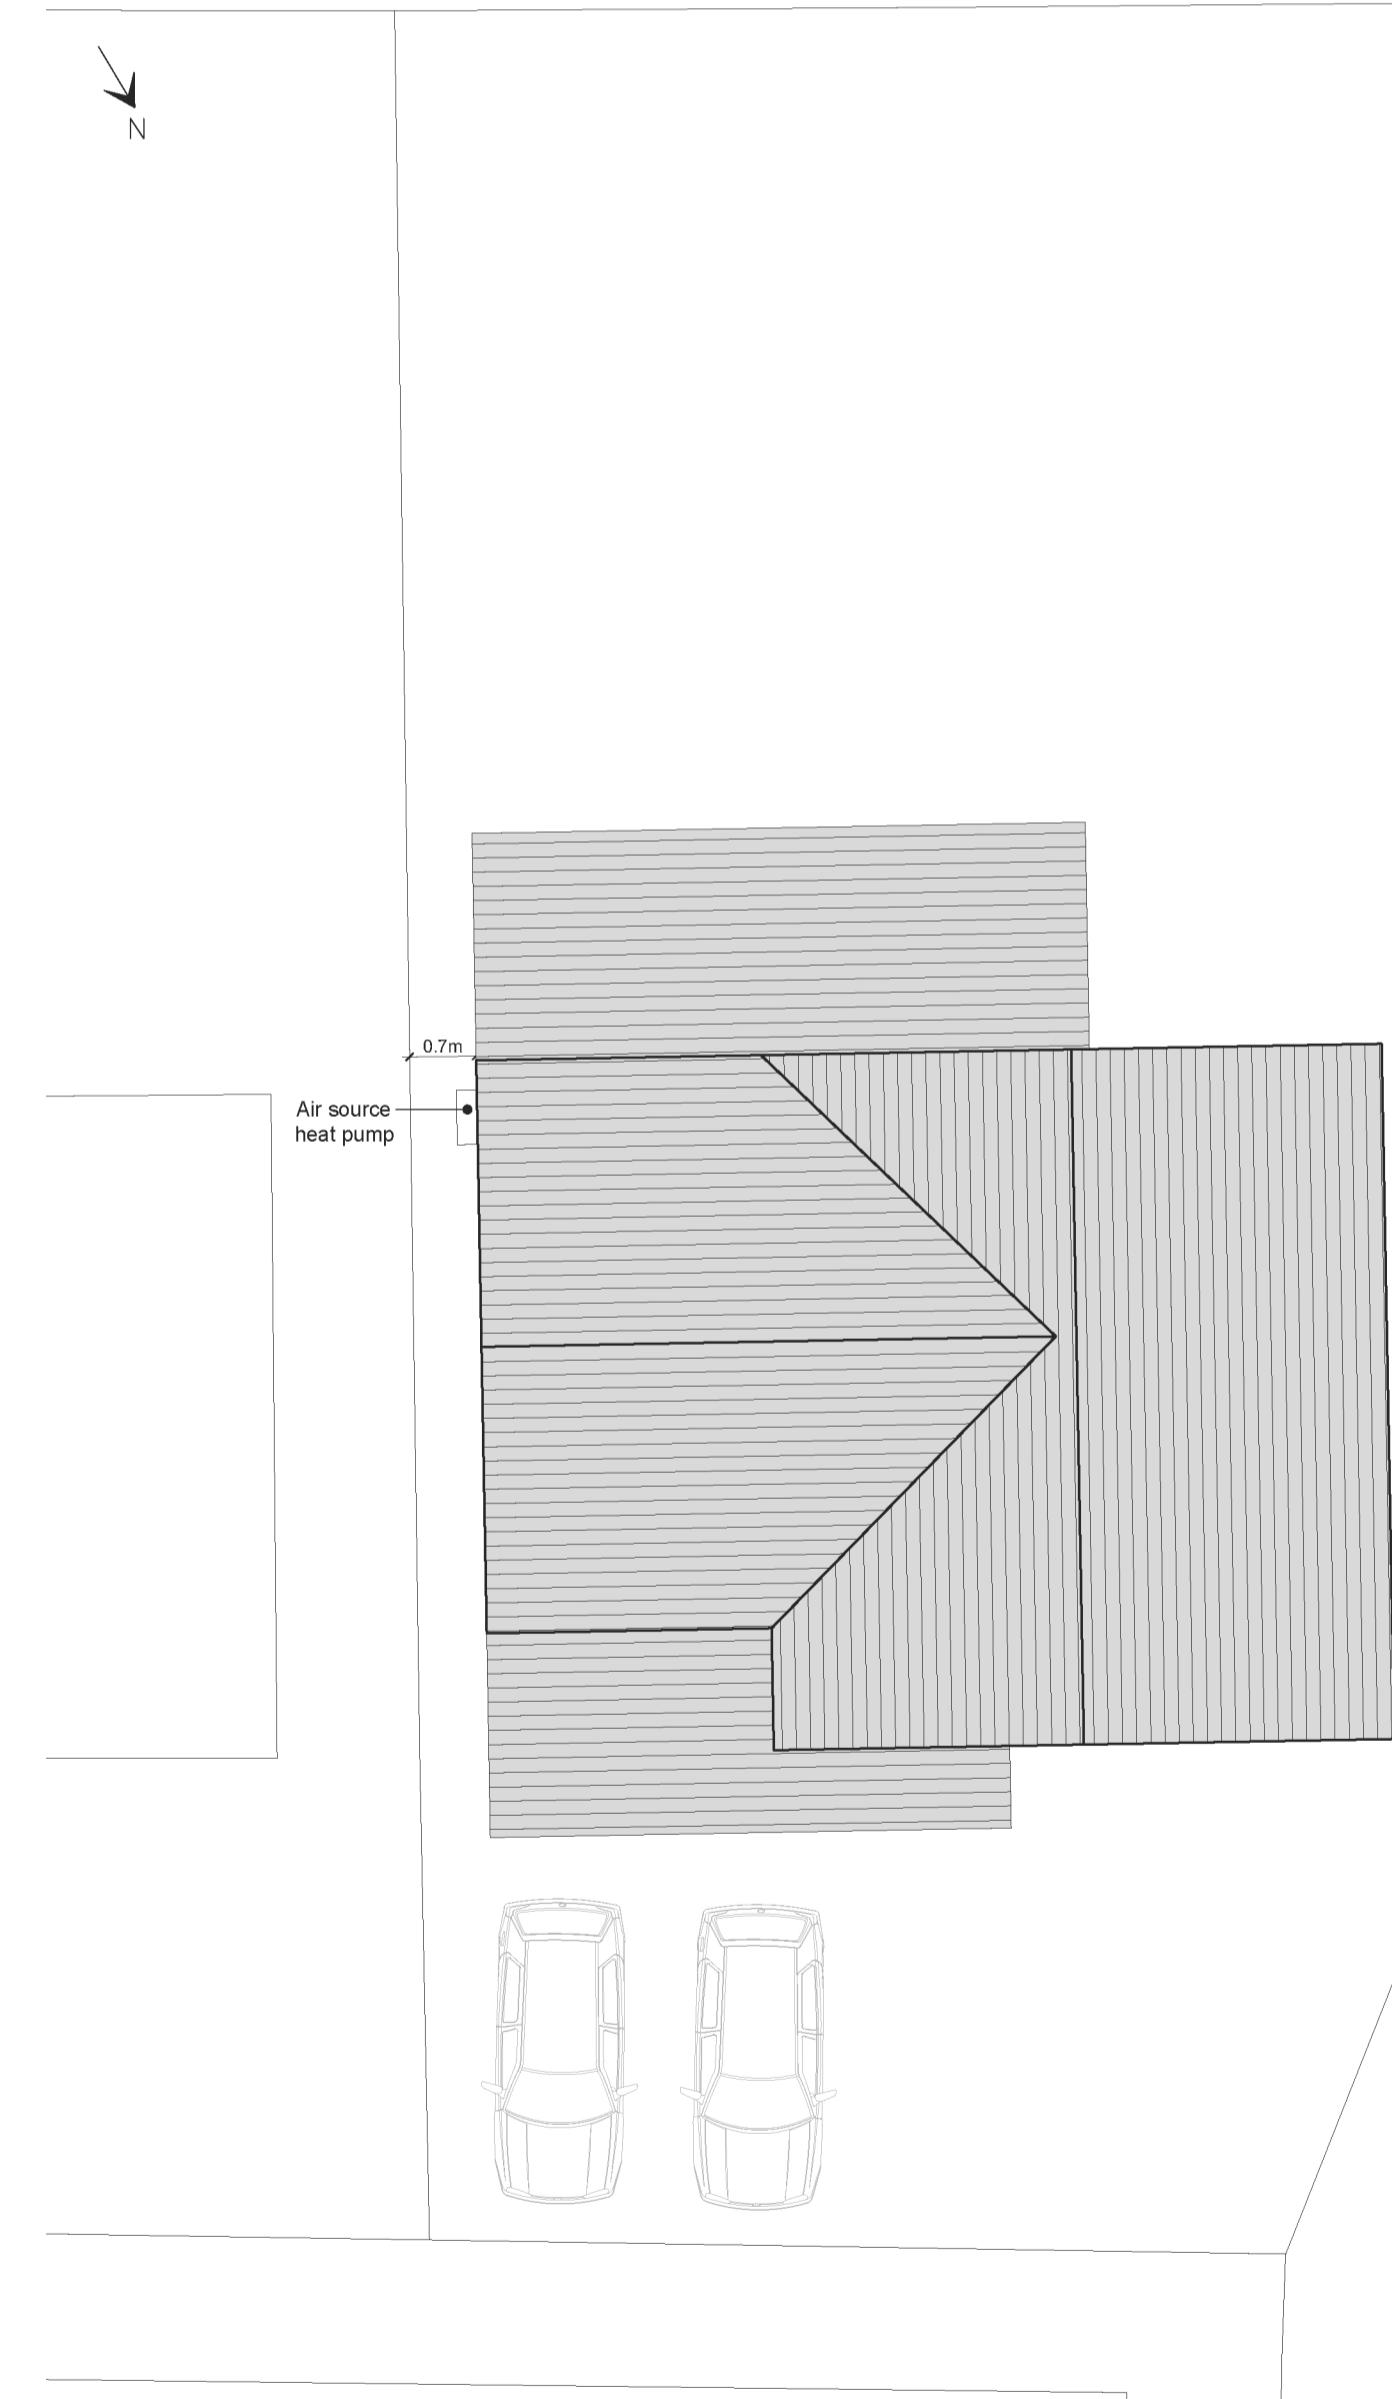

**SITE PLAN**  
Scale 1:100