



view from rear door of dwelling




SITE LAYOUT PLAN - scale 1:200





existing wall in relation to rear wall of dwelling, narrow path through

625mm

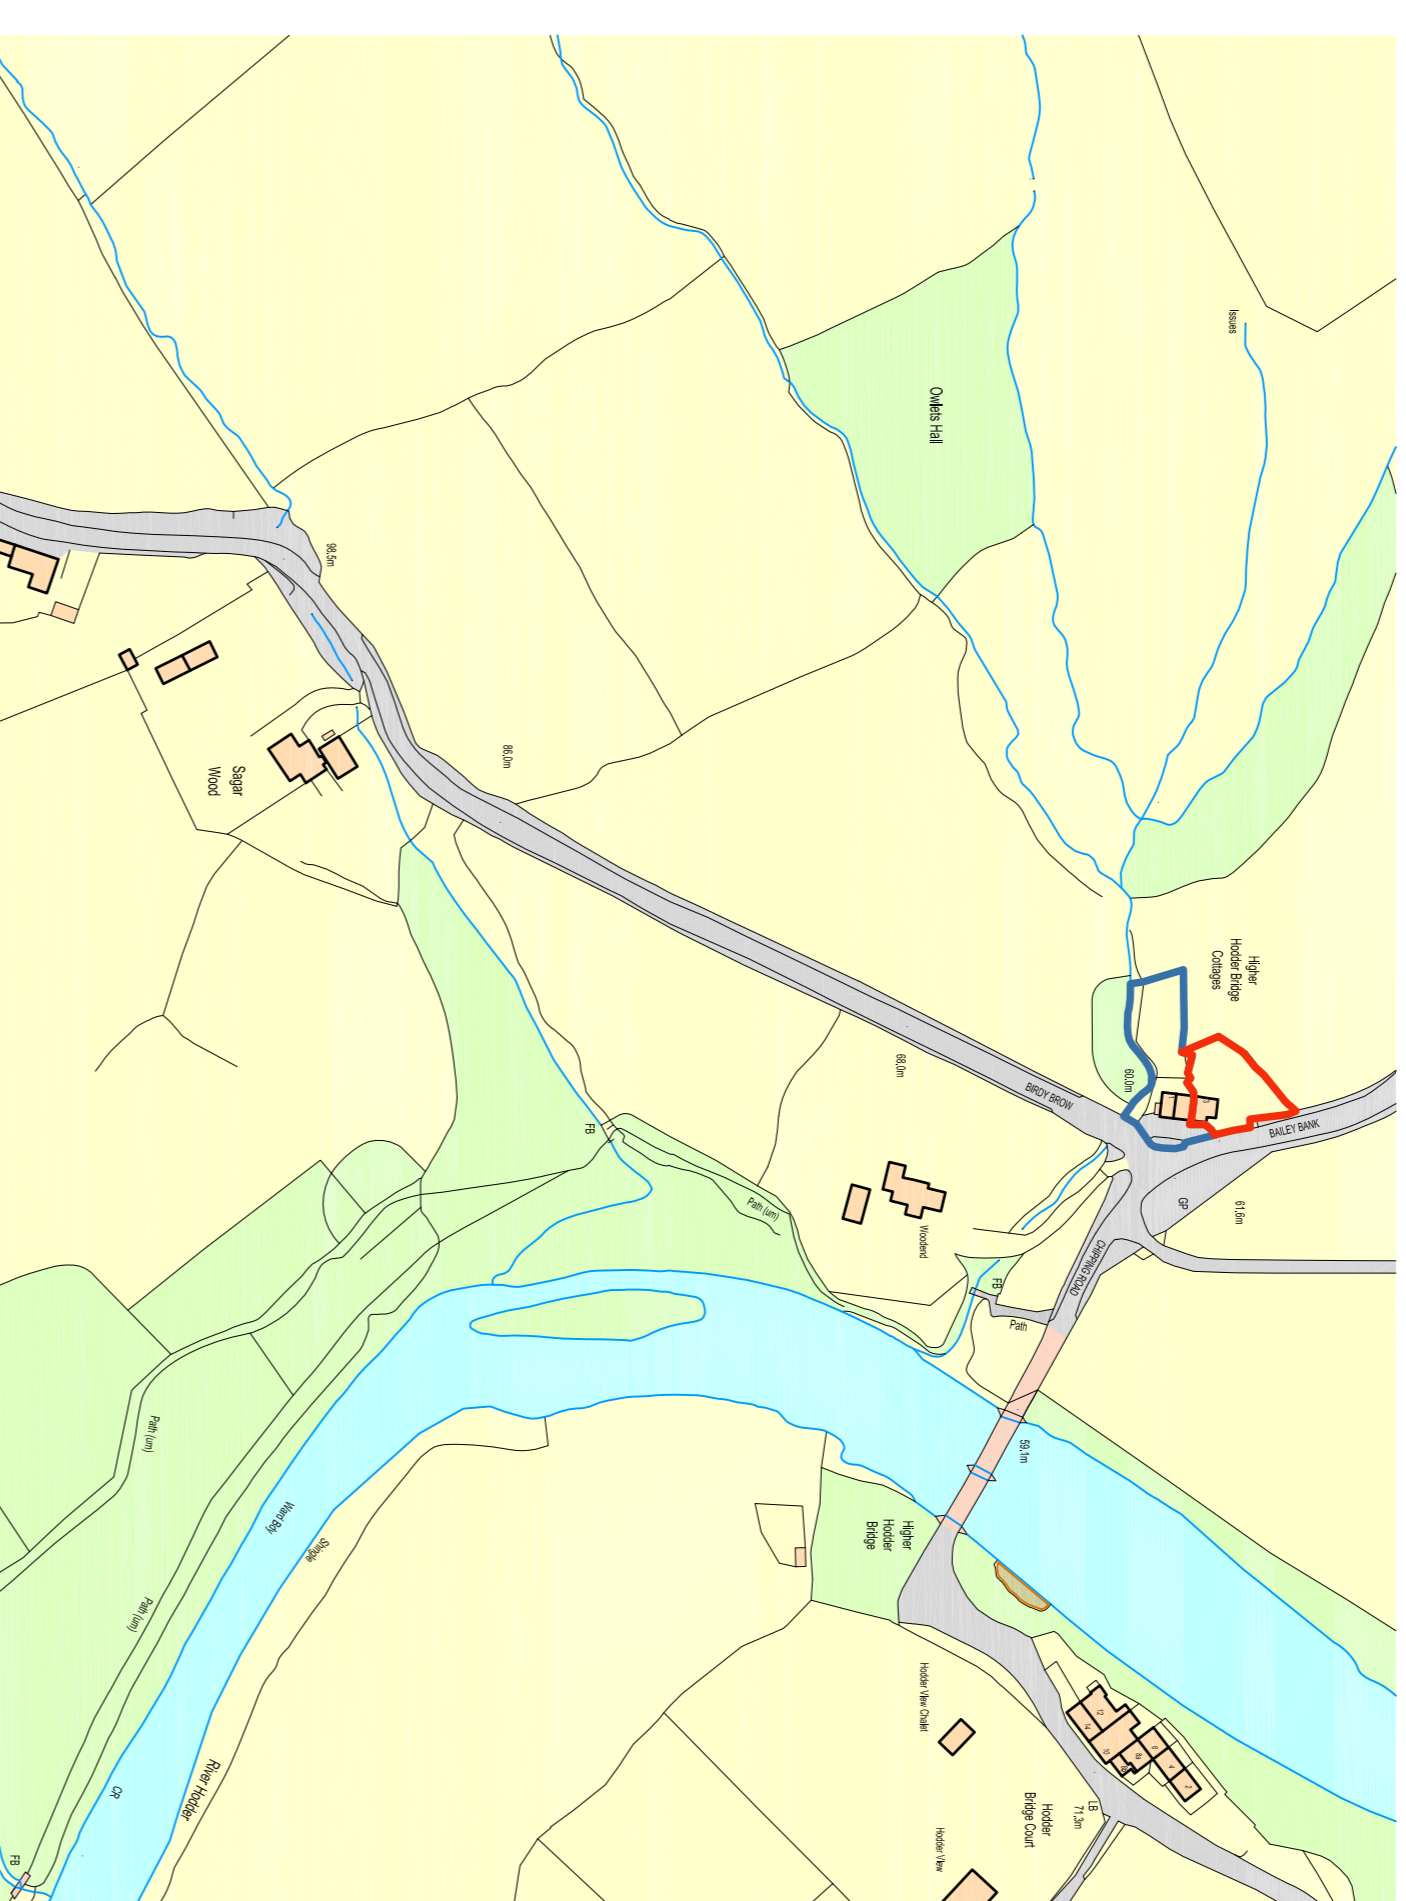


SITE LOCATION PLAN - scale 1:2500

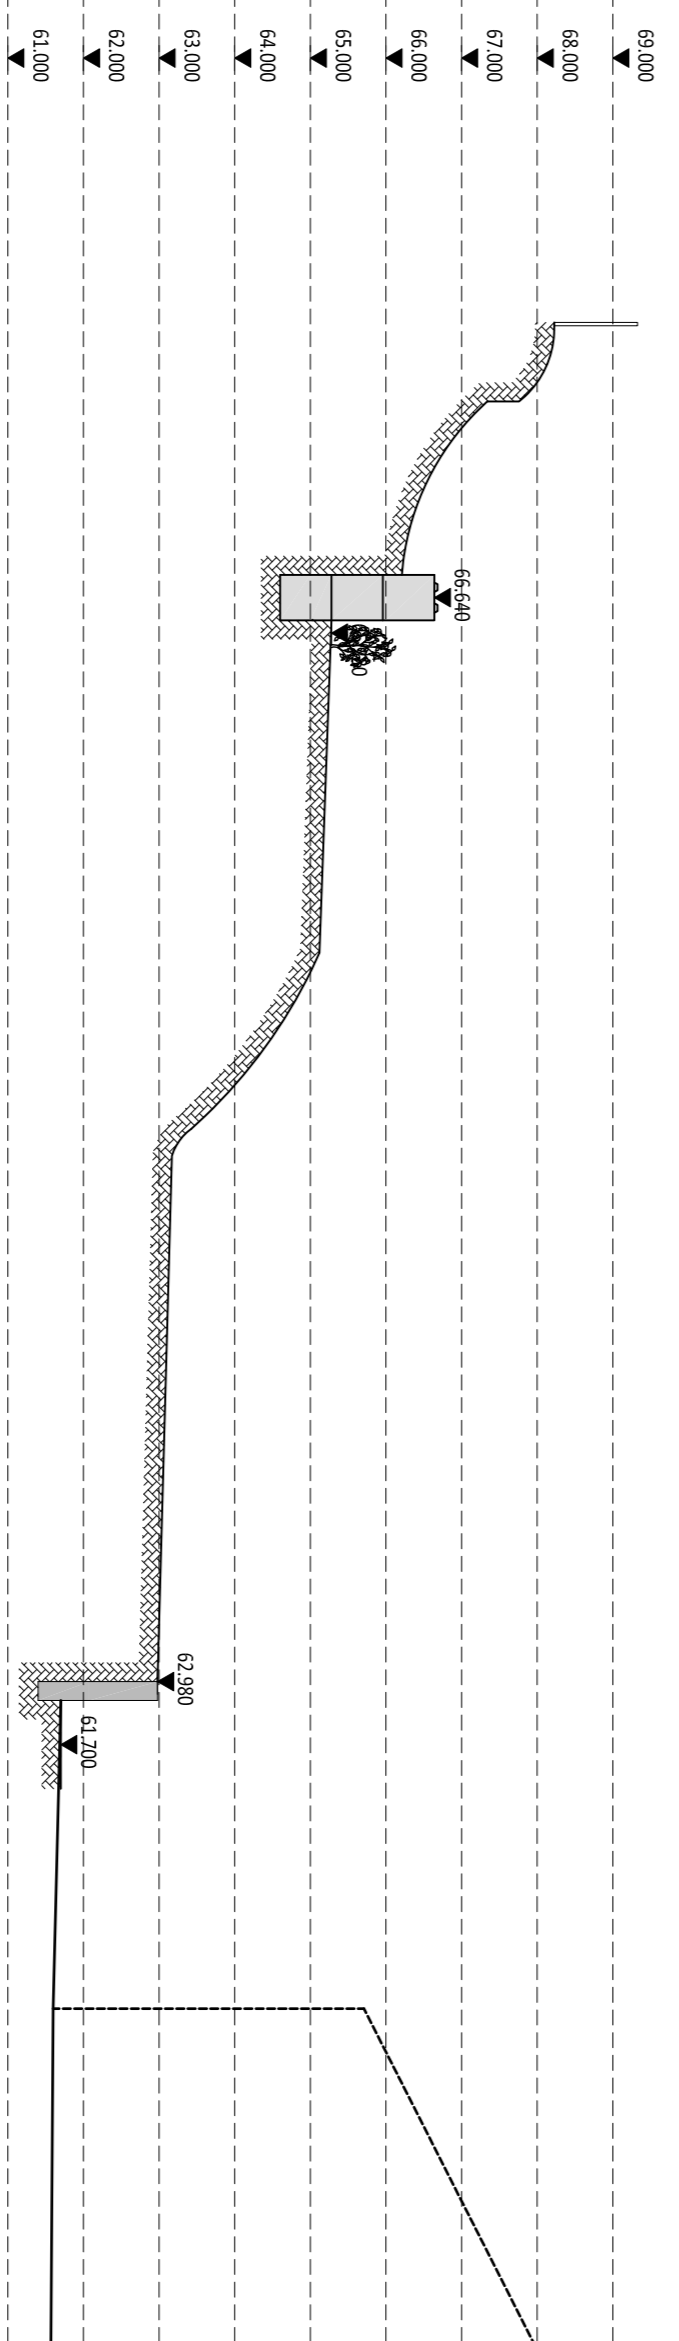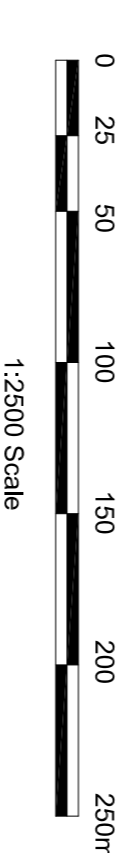


SECTION 200 - as installed

SCALE 1:100

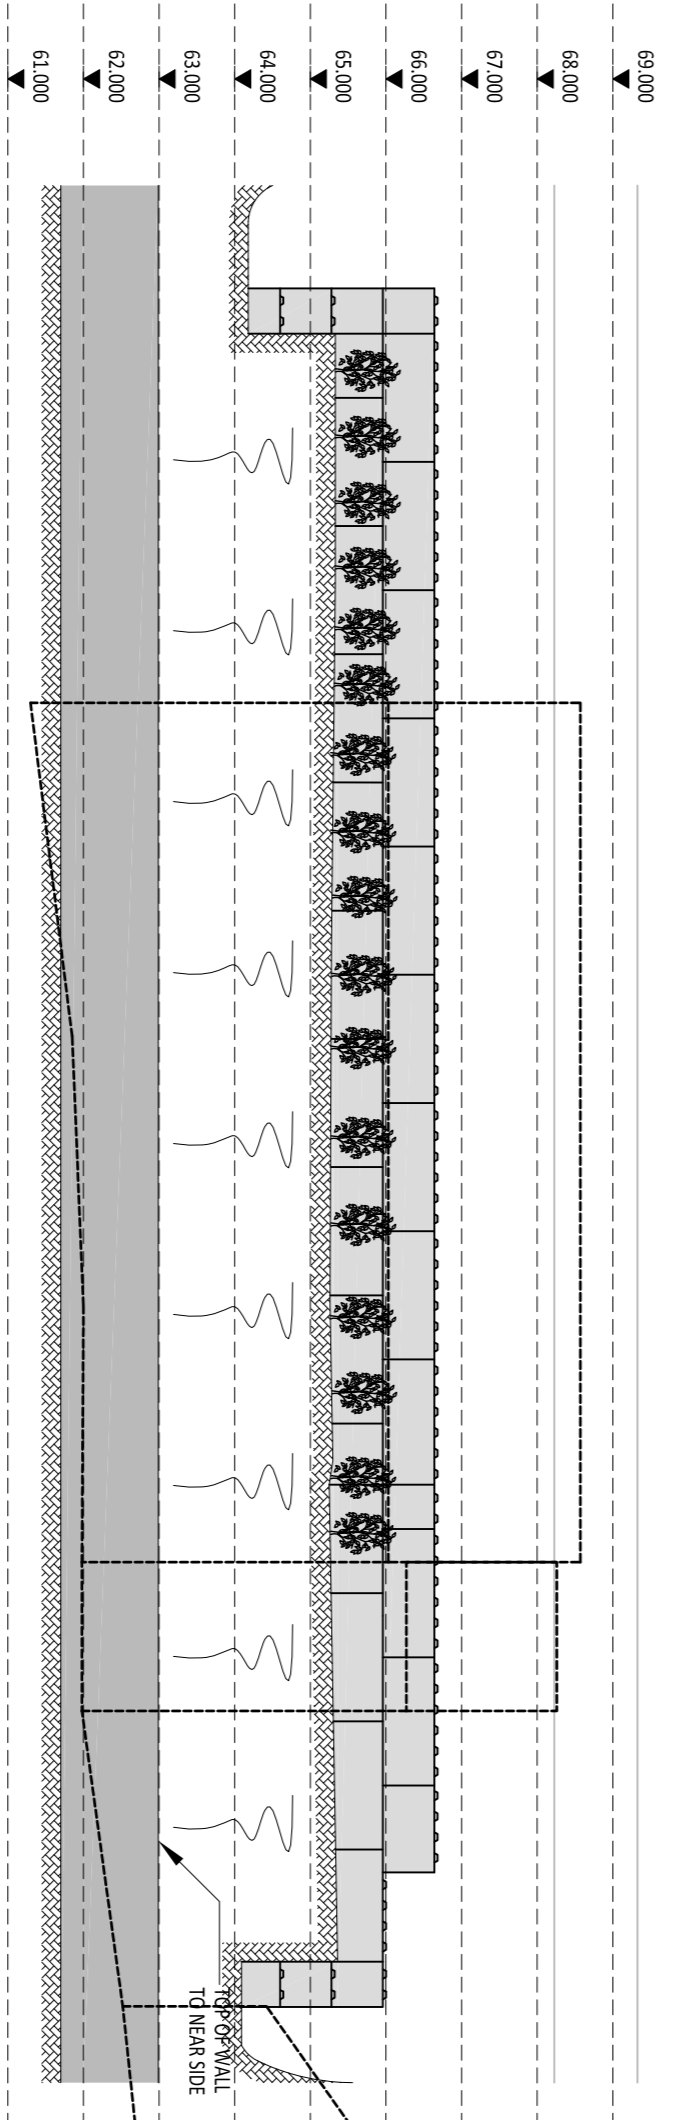


ELEVATION 201 - as installed

SCALE 1:100

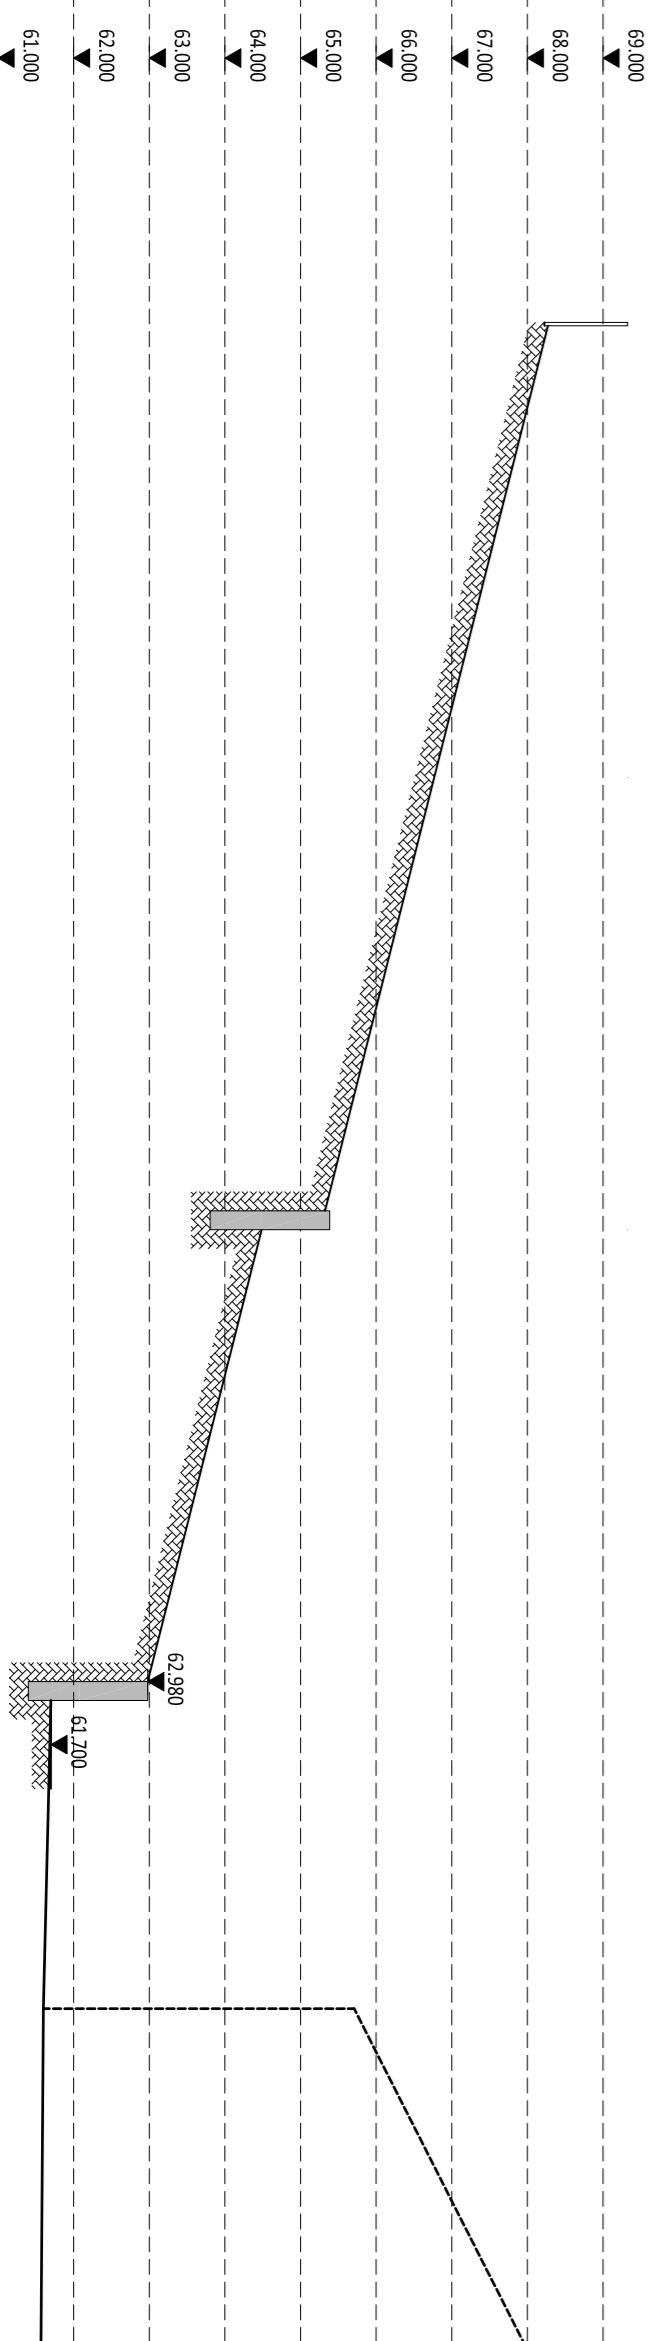


SECTION 200 - previous

SCALE 1:100

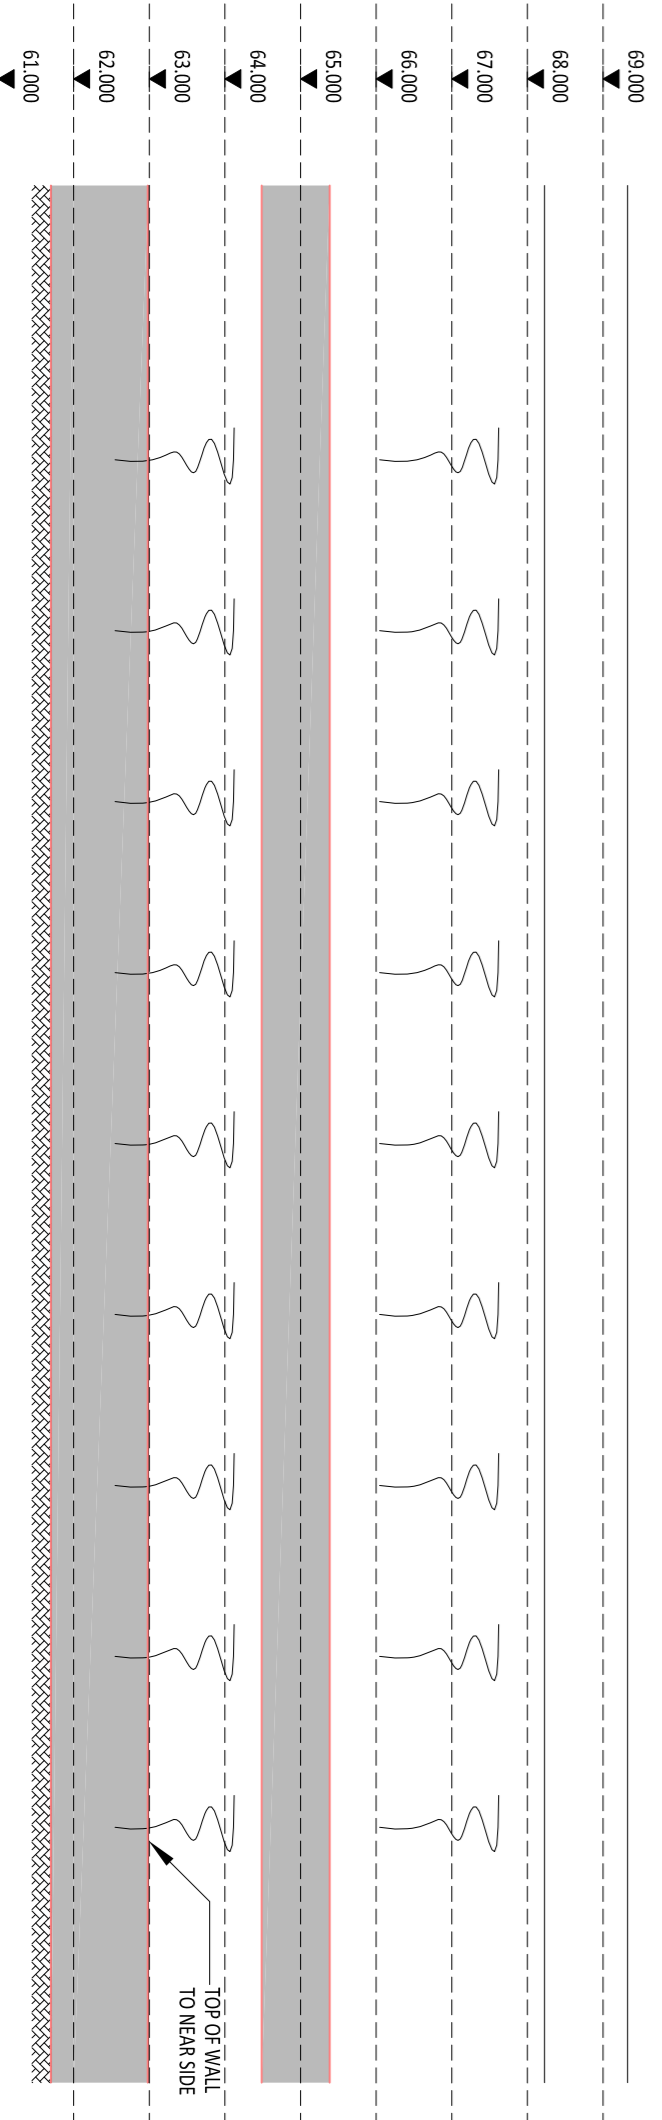

ELEVATION 201 - previous

SCALE 1:100

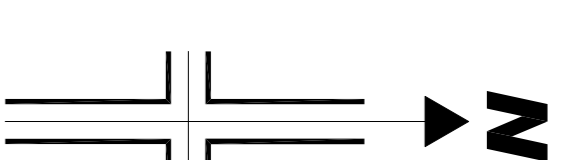

Mr & Mrs Stansfield

3 Higher Hodder Cottages  
Rear Garden Plan and Sections  
As Existing



The Old Bank House, 6 Berry Lane,  
Loughborough LE17 7RE  
www.psadesign.co.uk  
mail@psadesign.co.uk

Drawn	Checked	Approved
DME		
Date	May 2024	
Scale	As Shown	Sheet Size
As Shown		A1
Drawn	Checked	Approved
DME		