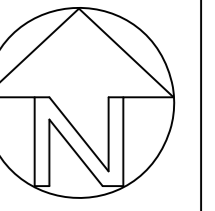
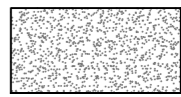


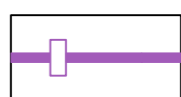
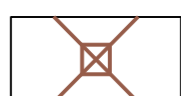
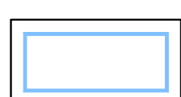
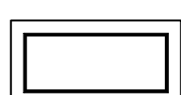


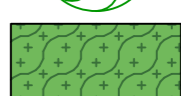
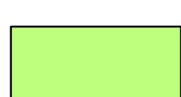


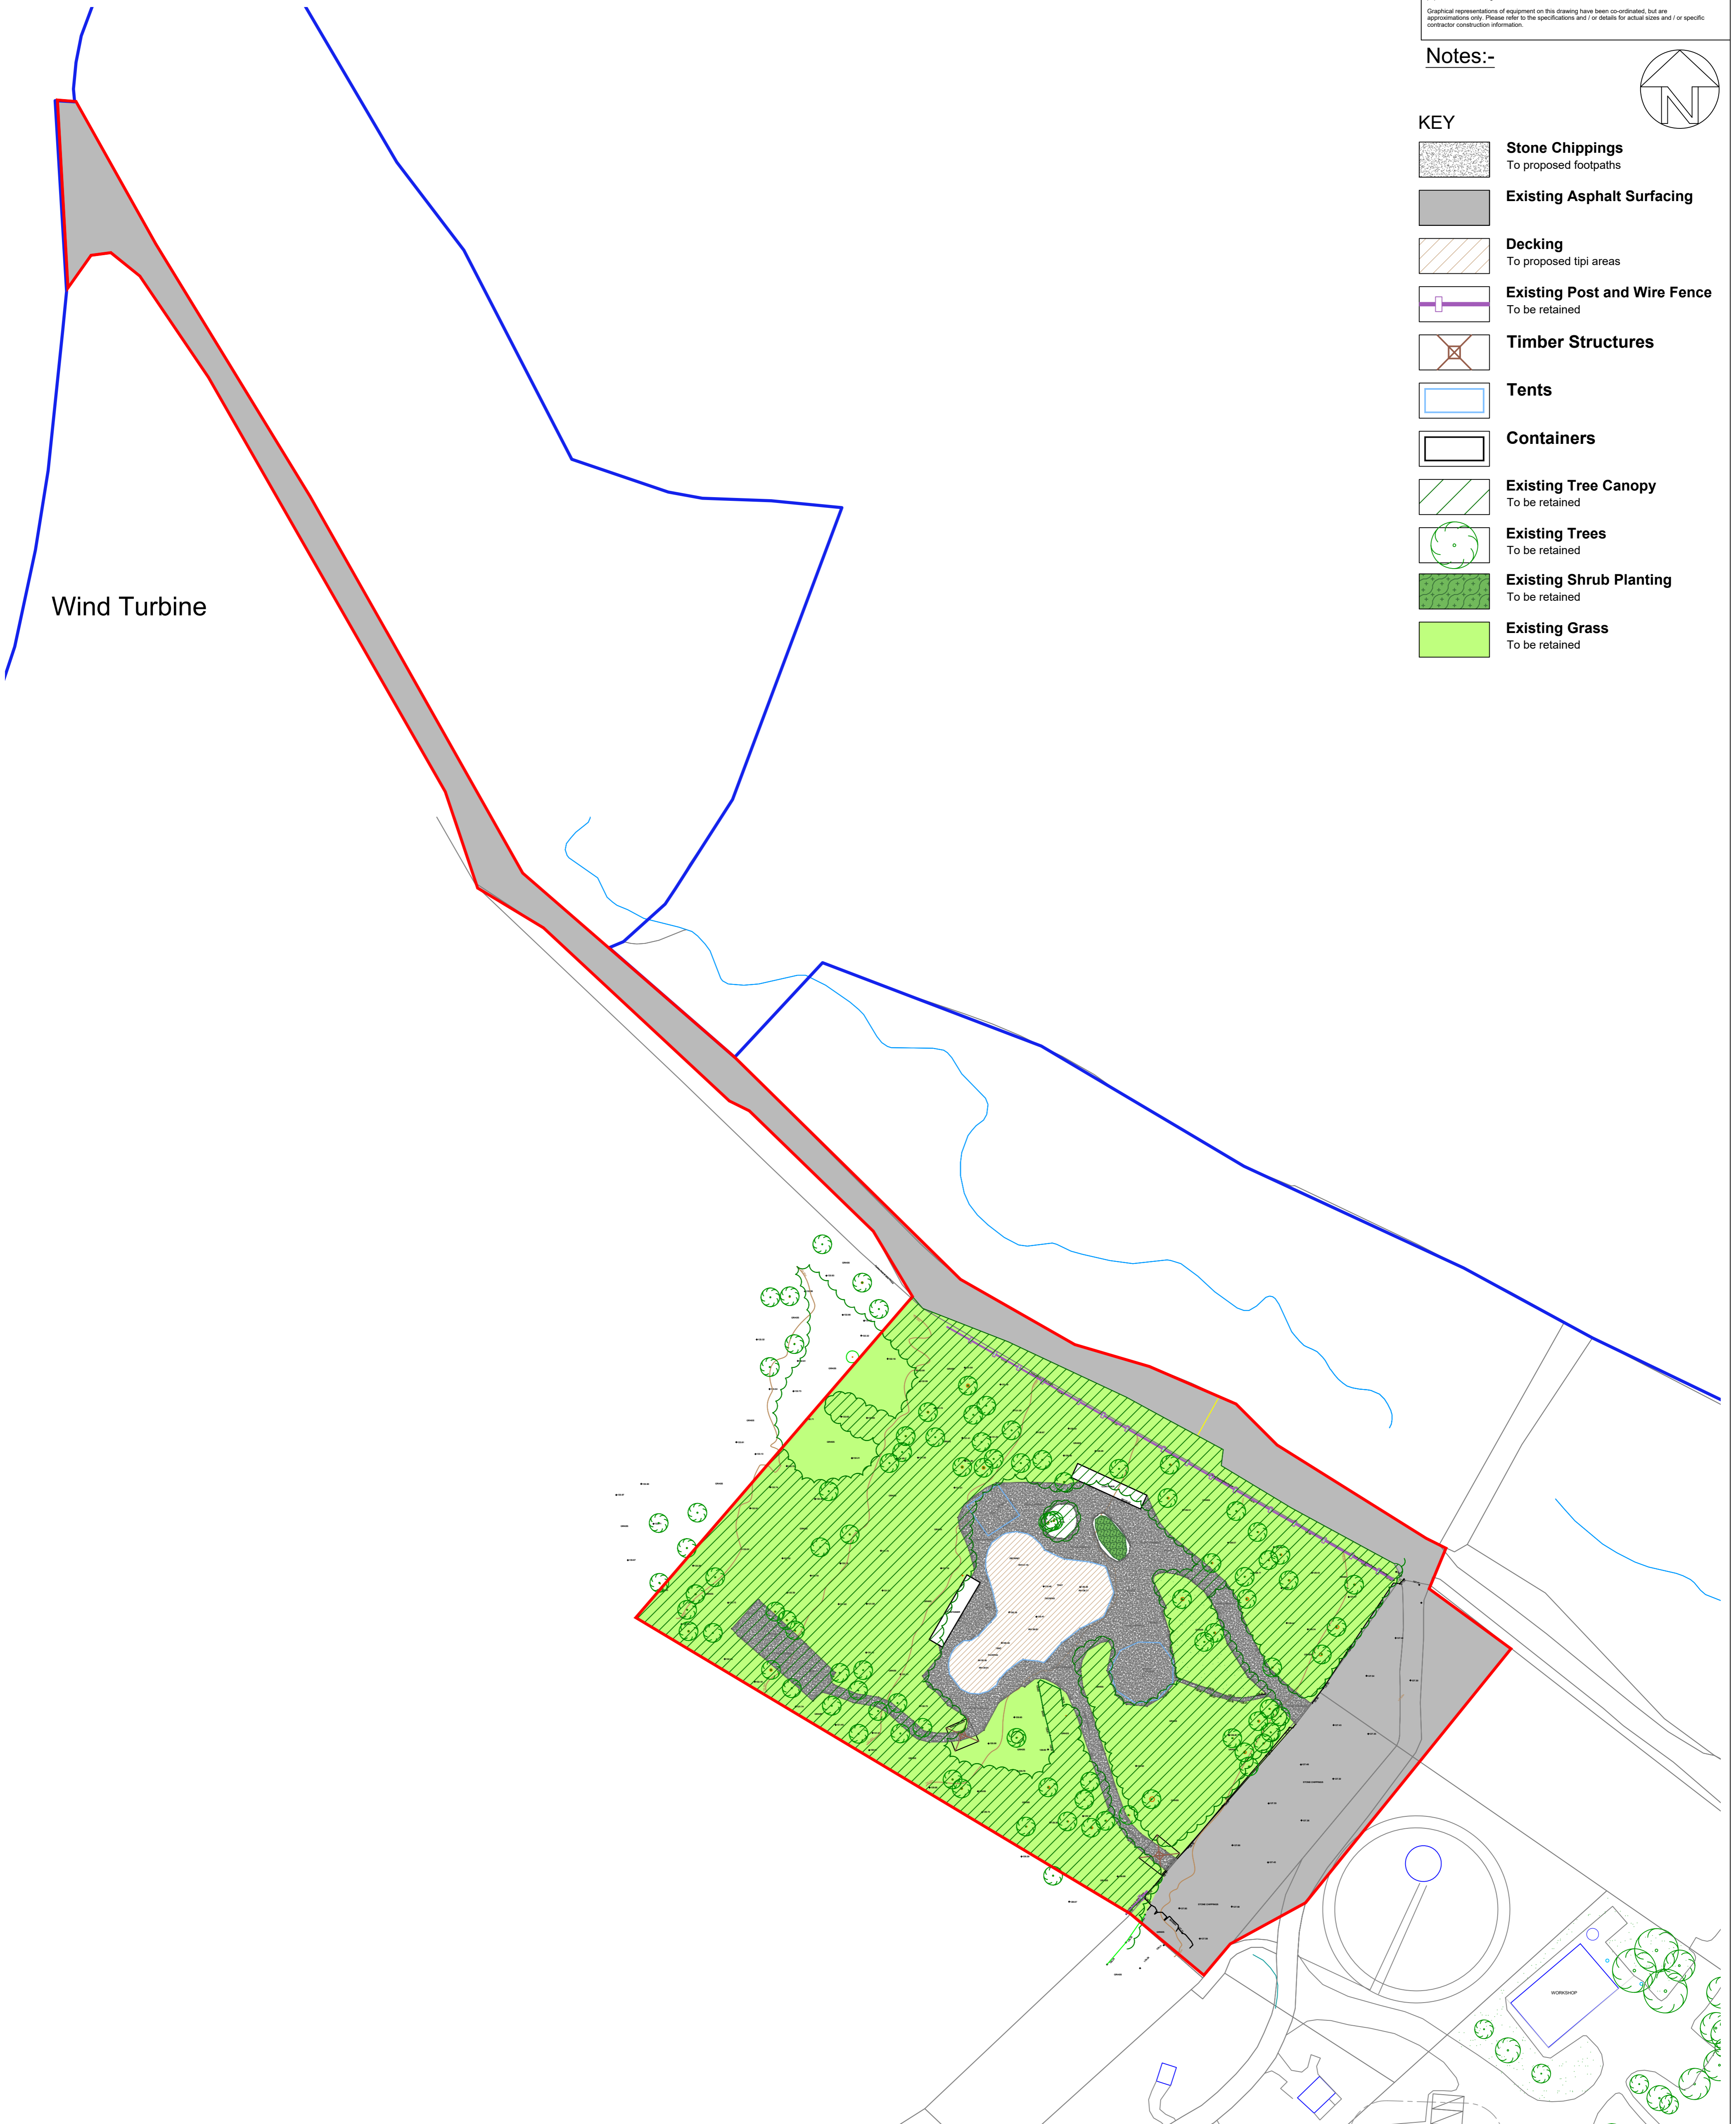
Do not scale this drawing (printed or electronic version).
 Contractors must check all dimensions from site.
 This drawing is copyright and is for use on this site only. This drawing should be read in conjunction with all relevant consultants drawings and specialist subcontractors / supply chain drawings and specifications.
 All works to be carried out in accordance with the latest British Standards / Codes of Practice unless specifically directed otherwise in the specification.
 Responsibility for the reproduction of this drawing in paper form, or issued in electronic format, lies with the recipient to check that all information has been replicated in full and is correct when compared to the original paper or electronic image.
 Graphical representations of equipment on this drawing have been co-ordinated, but are approximations only. Please refer to the specifications and / or details for actual sizes and / or specific contractor construction information.

Notes:-



KEY

-  **Stone Chippings**
To proposed footpaths
-  **Existing Asphalt Surfacing**
-  **Decking**
To proposed tipi areas
-  **Existing Post and Wire Fence**
To be retained
-  **Timber Structures**
-  **Tents**
-  **Containers**
-  **Existing Tree Canopy**
To be retained
-  **Existing Trees**
To be retained
-  **Existing Shrub Planting**
To be retained
-  **Existing Grass**
To be retained



P02	23/05/24	Layout Updated	TH	IG
P01	16/04/24	First Issue	IG	SA
REV.	DATE	DESCRIPTION	DRAWN	CHK'D

Client: BOWLAND TIPIS	Project: BOWLAND WILD BOAR PARK	Drawn: IG	Checked: SA	Approved: ME	Date: 23/05/24
Issue: PLANNING	Title: GENERAL ARRANGEMENT	Dwg No: UG_2490_LAN_GA_DRW_101		Scale @ A1: 1:500	Revision: P02



A: Ground Floor, The Tower,
 Deva City Office Park, Trinity Way,
 Manchester M3 7BF
T: +44 (0) 161 312 3131
 wearurbangreen.co.uk