


EXISTING (AS-BUILT) ELEVATIONS

BACK CASTLE WORKS - PENDLE COURT - LONGRIDGE - PRESTON -PR3 3WY

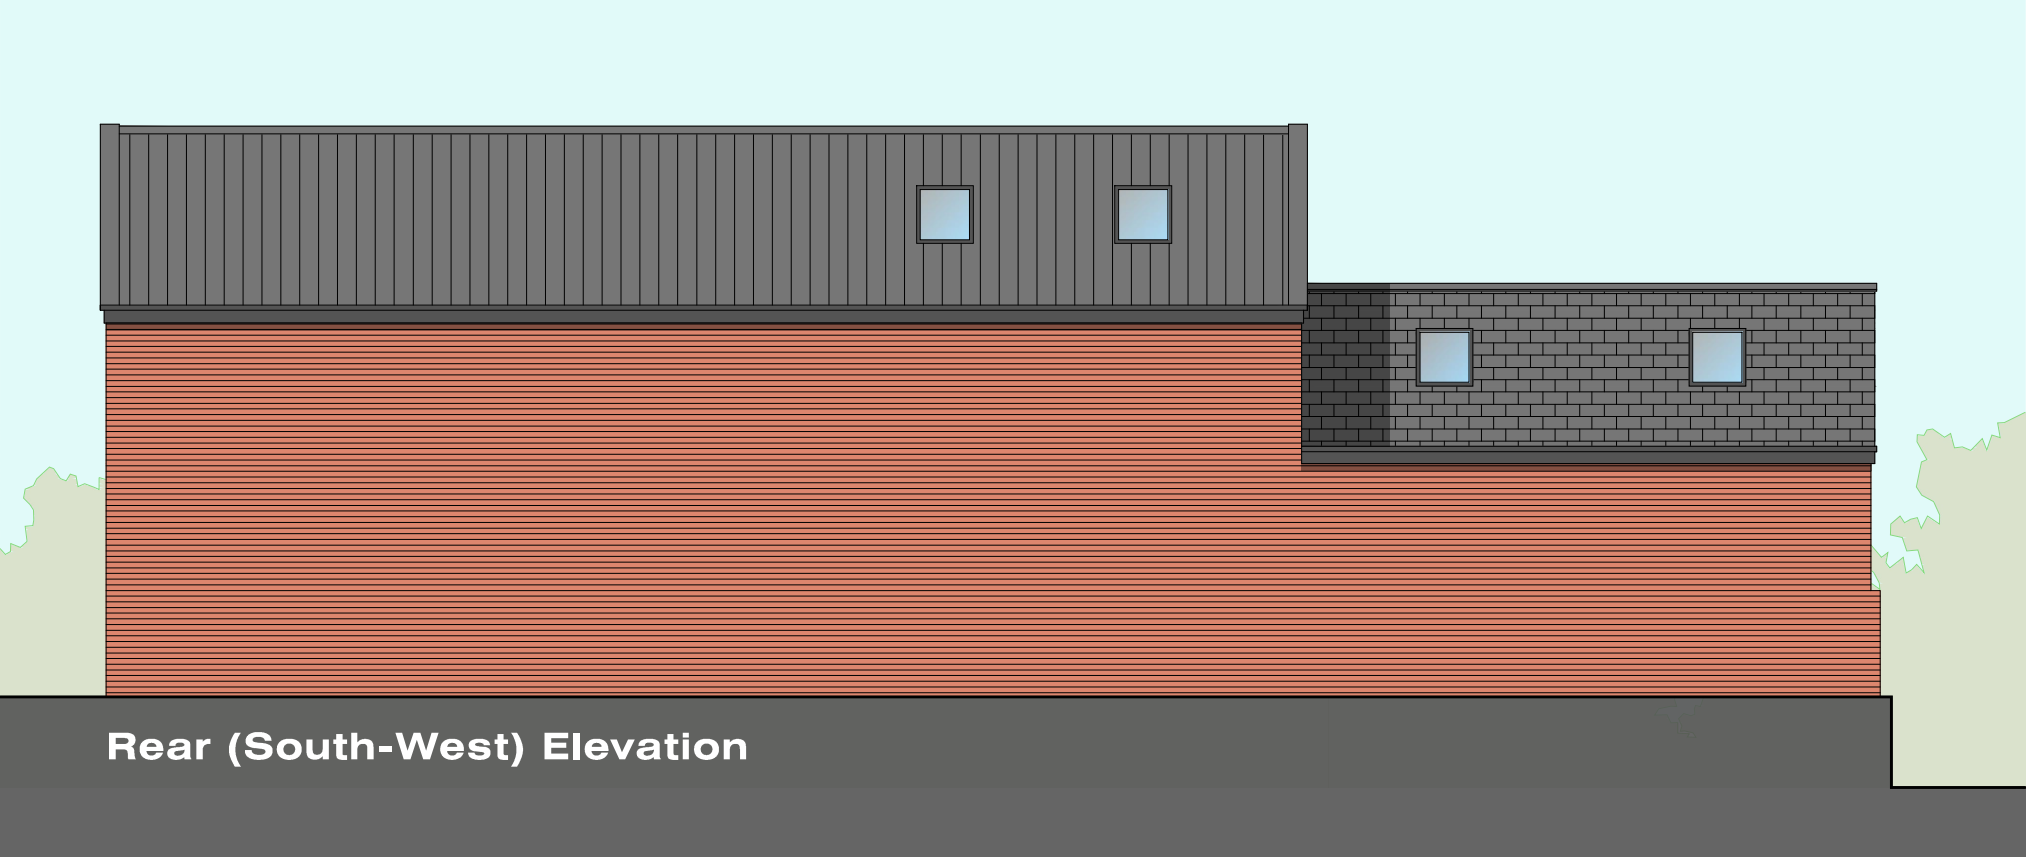

MR. G WALMSLEY BACK CASTLE WORKS PENDLE COURT LONGRIDGE PRESTON PR3 3WY	JM-0307	004	
	EXISTING (AS-BUILT) ELEVATIONS		Date: 18.03.24 Drawn: J Monks Scale: 1:100 Paper Size: A3
MONKS-ARCHITECTURAL-DESIGN 25 BIRCHFIELD DRIVE - LONGRIDGE- PRESTON - PR3 3HP			