



North Elevation

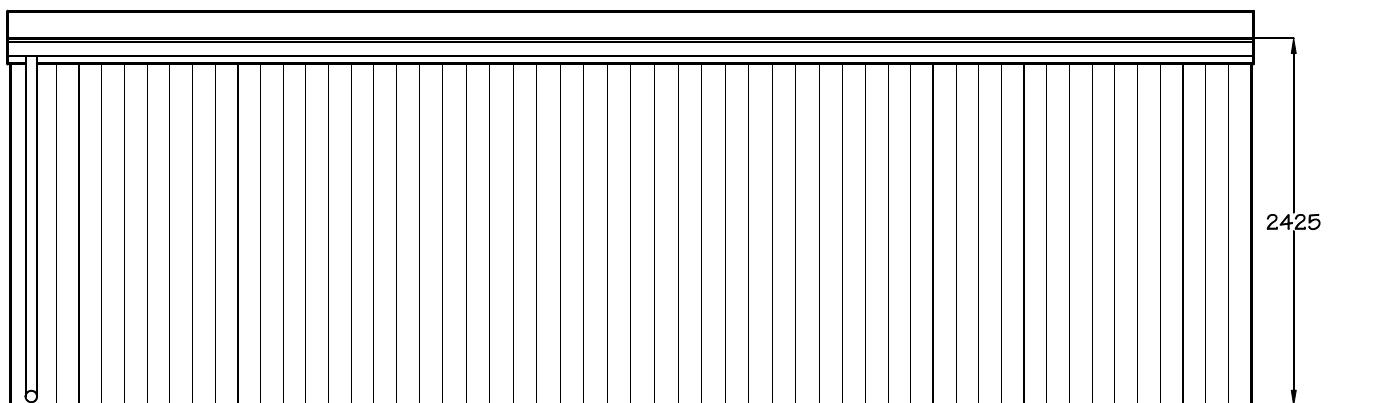

South Elevation

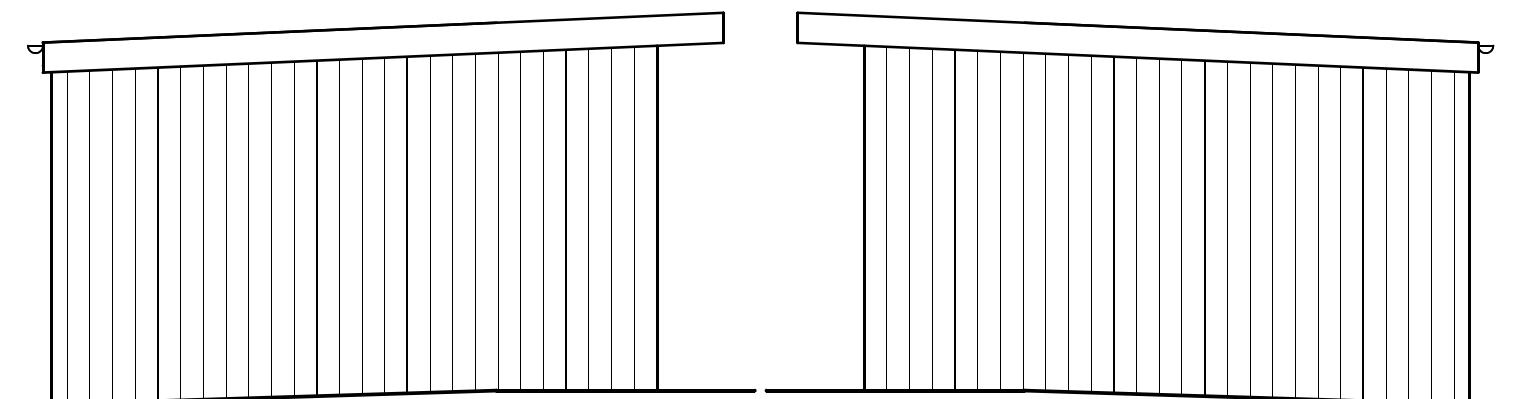

East Elevation


West Elevation

**Materials:**

Roof - dark grey coloured EDPM membrane  
 Walls - natural coloured vertical timber boarding  
 Door - dark grey powdered coated aluminium

**PD Construction Consultants**  
 7 Beech Street, Clitheroe, Lancs  
 BB7 2LL  
 tel: 07976 771297  
 email: pdcc@hotmail.co.uk

metres

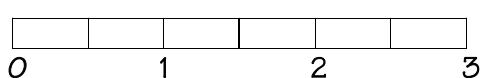

**PLANNING ISSUE**

Client:	Sarah McMillan			
Project:	Proposed Alterations 25 Middle Lodge Road Barrow			
Dwg title:				
Proposed Elevations Garden Room				
Scale @ A4:	1:50	Date: 18.07.23		
Drawn by:	PD			
Drawing no.	1474 - 08	Rev. A		