


Do not scale. Contractors must check all dimensions on site before preparing production drawings or commencing any work. This drawing and its design is the copyright of LMC Architecture Limited and may not be reproduced in any form whatsoever without their prior express written consent.

Revision	Date	Revision note	Drawn by	Purpose of issue
AB 1	28.03.25	Ground floor low level boundary wall amended. Artificial hedge added to the planter and top of ground to first floor stair. Larch cladding added to the open stairwell.	LM	Information
3				
4				
5				

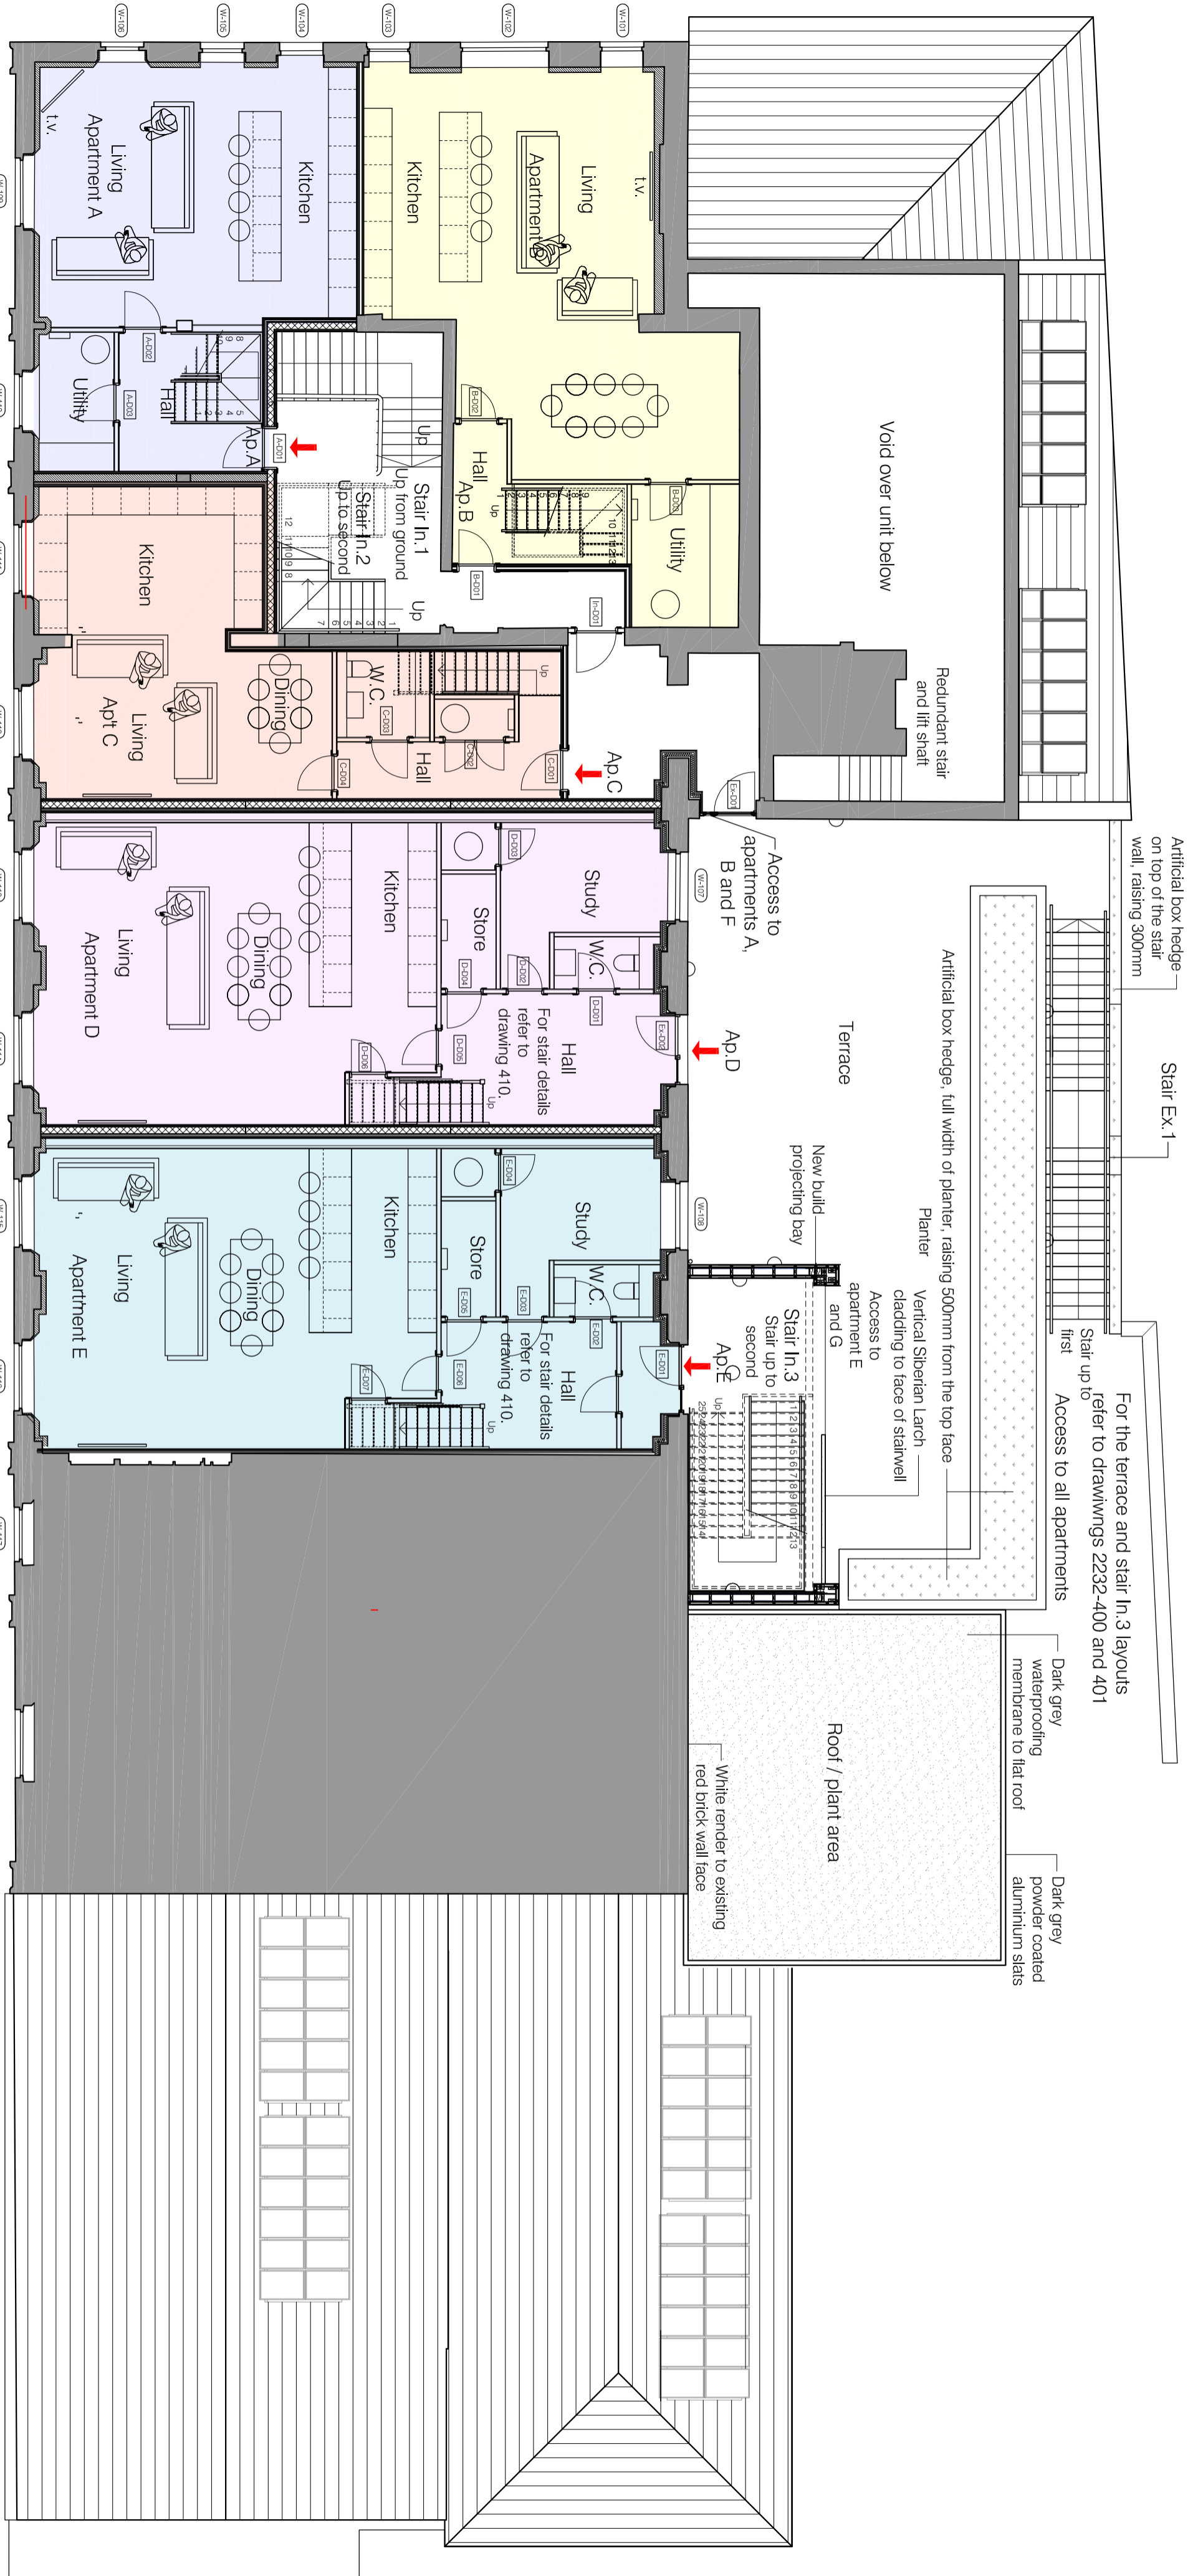

PROPOSED FIRST FLOOR PLAN

AS BUILT

Project Proposed apartments above 1 George Street Whalley	Drawing title Proposed first floor plan	Scale 1:100 @ A2	Client Romanan Corporation	Drawing number 2232-101 AB 1	Date 06.07.22	LMC Architecture Limited Architectural design services	LMC Architecture Ltd
						4 Doveedale Drive, Ightenhill, Burnley, Lancashire, BB12 8XD Web: www.lmcarchitecture.co.uk	