


Do not scale. Contractors must check all dimensions on site before preparing production drawings or commencing any work. This drawing and its design is the copyright of LMC Architecture Limited and may not be reproduced in any form whatsoever without their prior express written consent.

Revision	Date	Revision note	Drawn by	Purpose of issue
AB 1	28.03.25	Ground floor low level boundary wall amended. Larch cladding added to the open stairwell.	LM	Information
3				
4				
5				
6				
7				

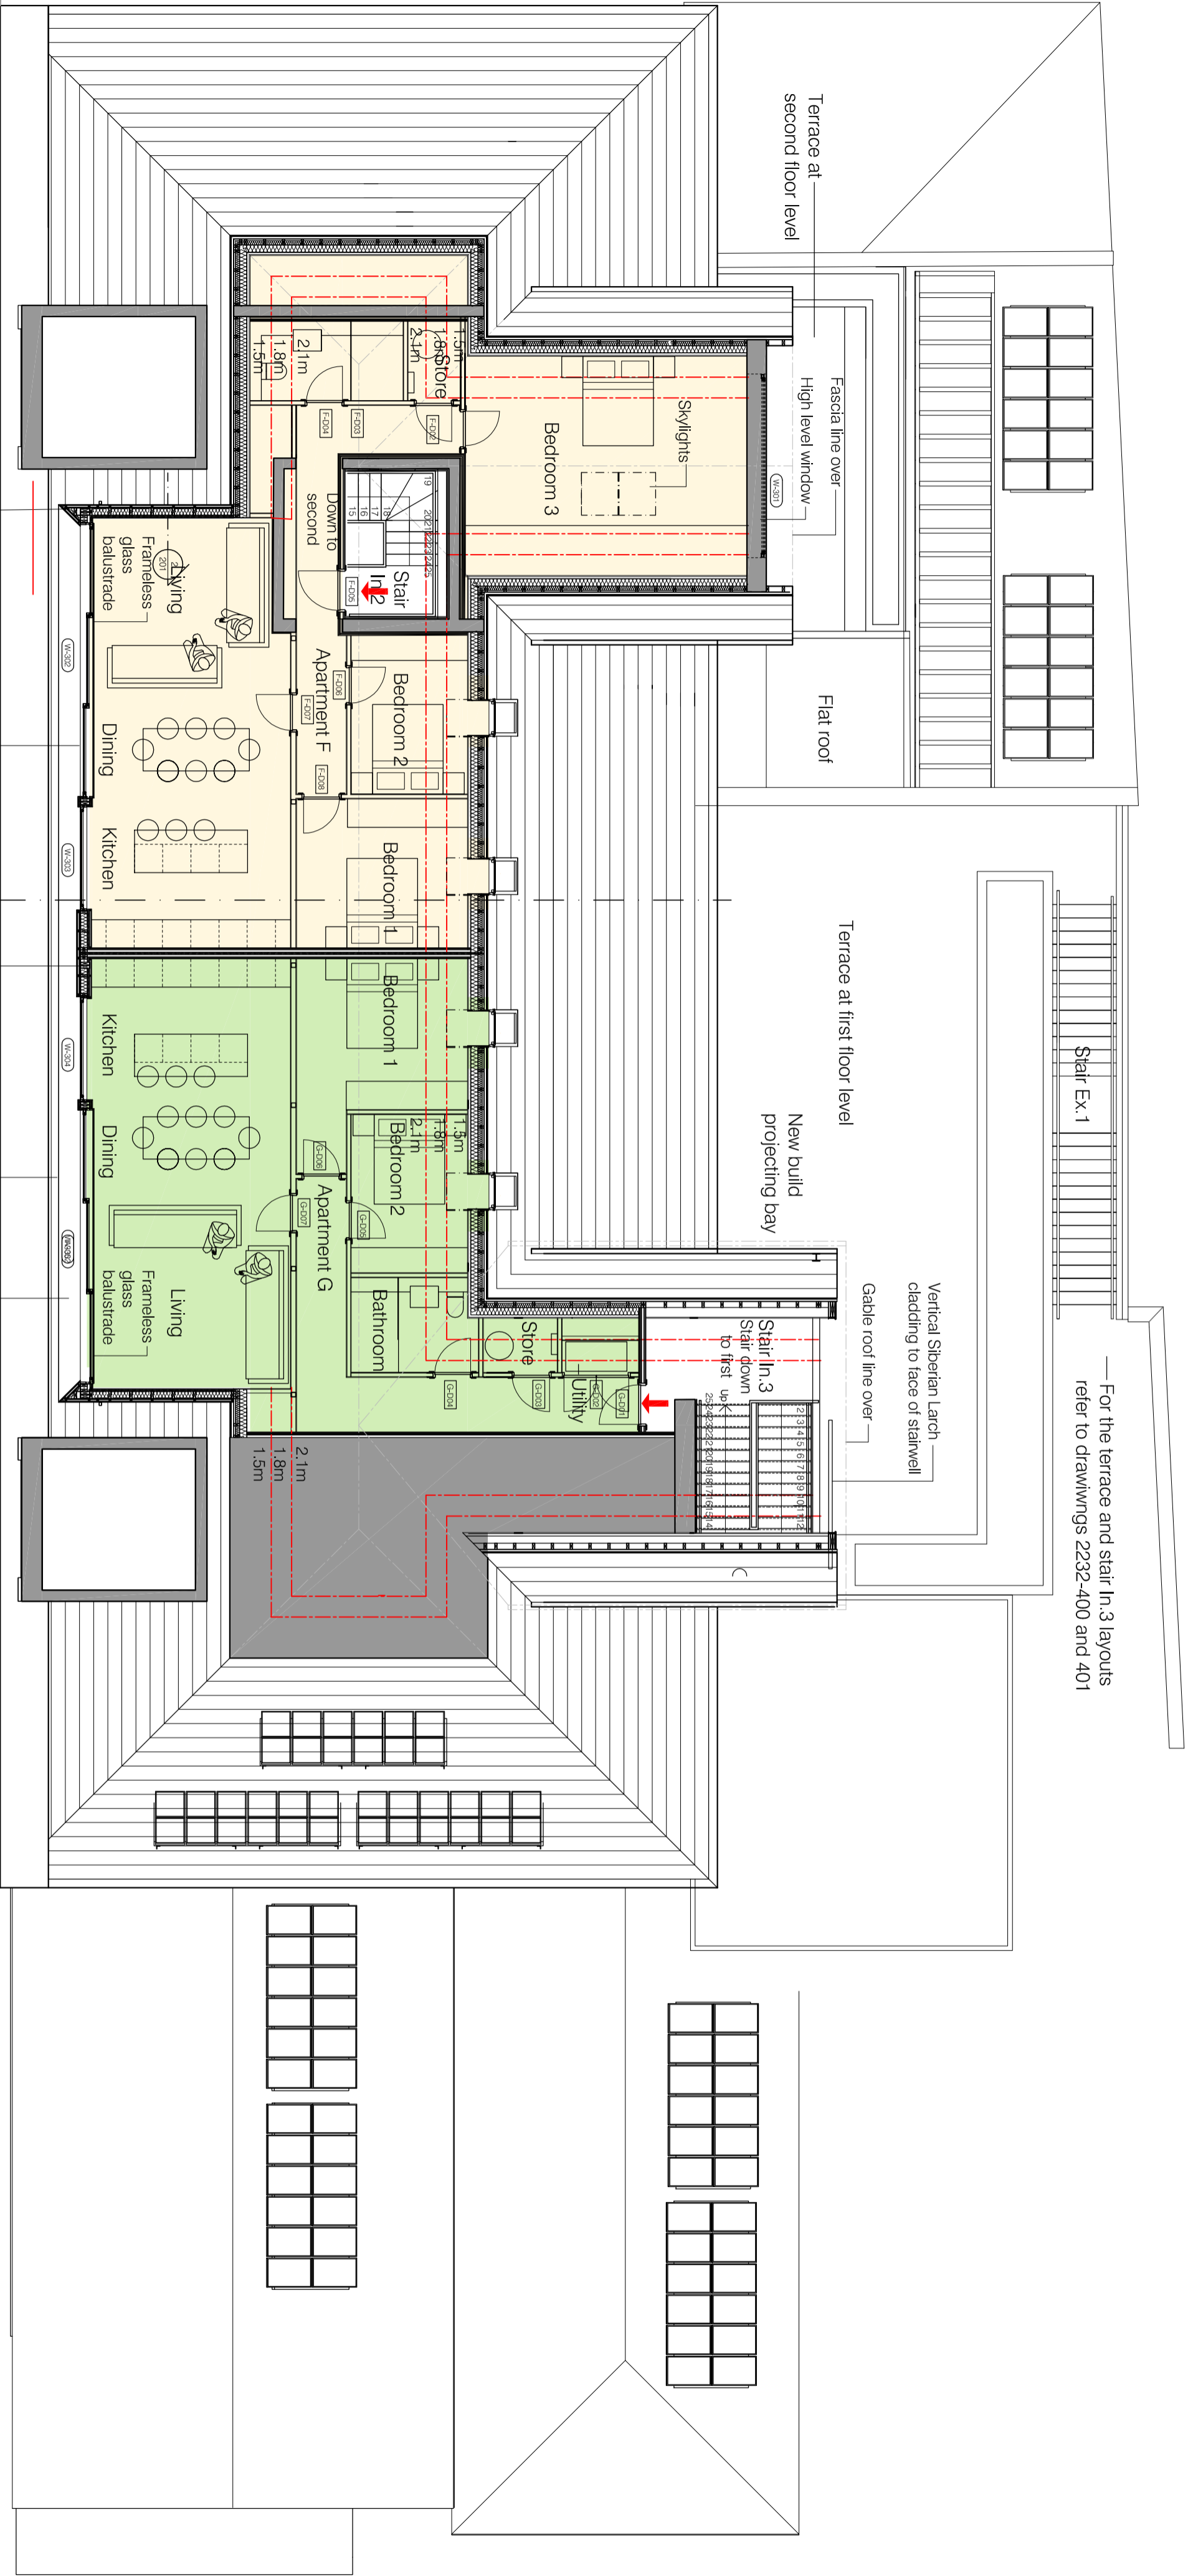

THIRD FLOOR PLAN

Project Proposed apartments above 1 George Street Whalley	Drawing title Proposed third floor plan	Scale 1:100 @ A2
Client Roman Corporation	Drawing number 2232-103 AB 1	Date 06.07.22
LMC Architecture Limited Architectural design services 4 Dovegate Drive, Ightenhill, Burnley, Lancashire, BB12 8XD Web: www.lmcarchitecture.co.uk		LMC ARCHITECTURE LTD

AS BUILT