


Do not scale. Contractors must check all dimensions on site before preparing production drawings or commencing any work. This drawing and its design is the copyright of LMC Architecture Limited and may not be reproduced in any form whatsoever without their prior express written consent.

Revision	Date	Revision note	Drawn by	Purpose of issue
AB	09.09.24	First issue	LM	Information

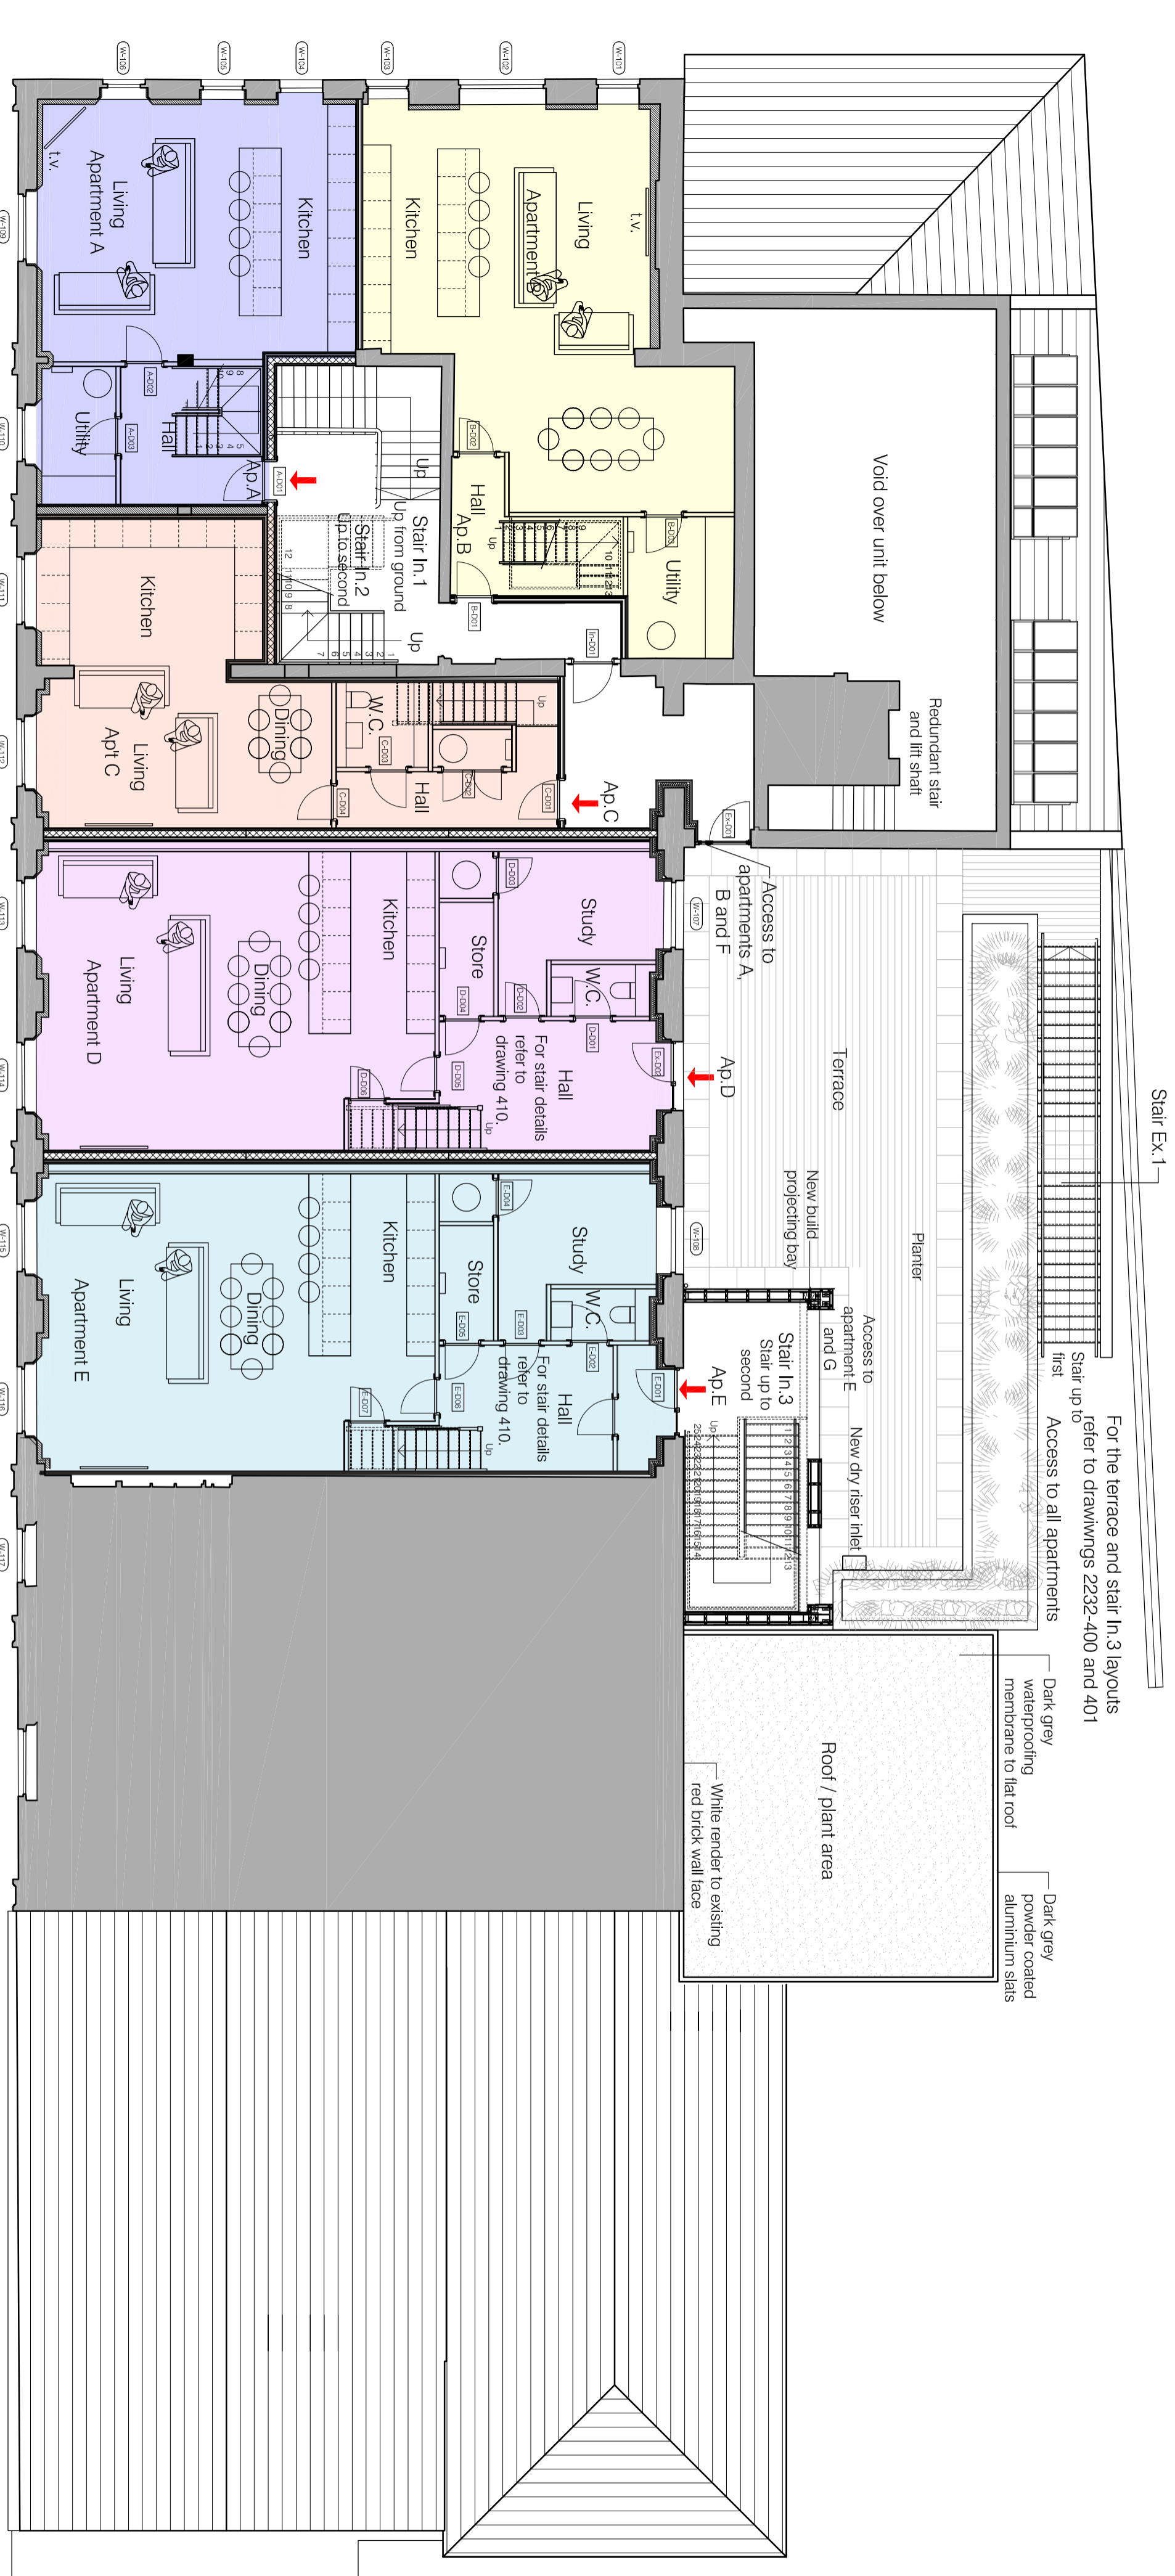

# PROPOSED FIRST FLOOR PLAN

# AS BUILT

Project Proposed apartments above 1 George Street Whalley	Drawing title Proposed first floor plan	Scale 1:100 @ A2	LMC Architecture Limited Architectural design services
Client Romanan Corporation	Drawing number 2232-101 AB	Date 06.07.22	4 Doveedale Drive, Ightenhill, Burnley, Lancashire, BB12 8XD Web : www.lmcarchitecture.co.uk

