



Do not scale. Contractors must check all dimensions on site before preparing production drawings or commencing any work. This drawing and its design is the copyright of LMC Architecture Limited and may not be reproduced in any form whatsoever without their prior express written consent.

Revision	Date	Revision note	Drawn by	Purpose of issue
AB	30.10.24	First Issue	LM	Information

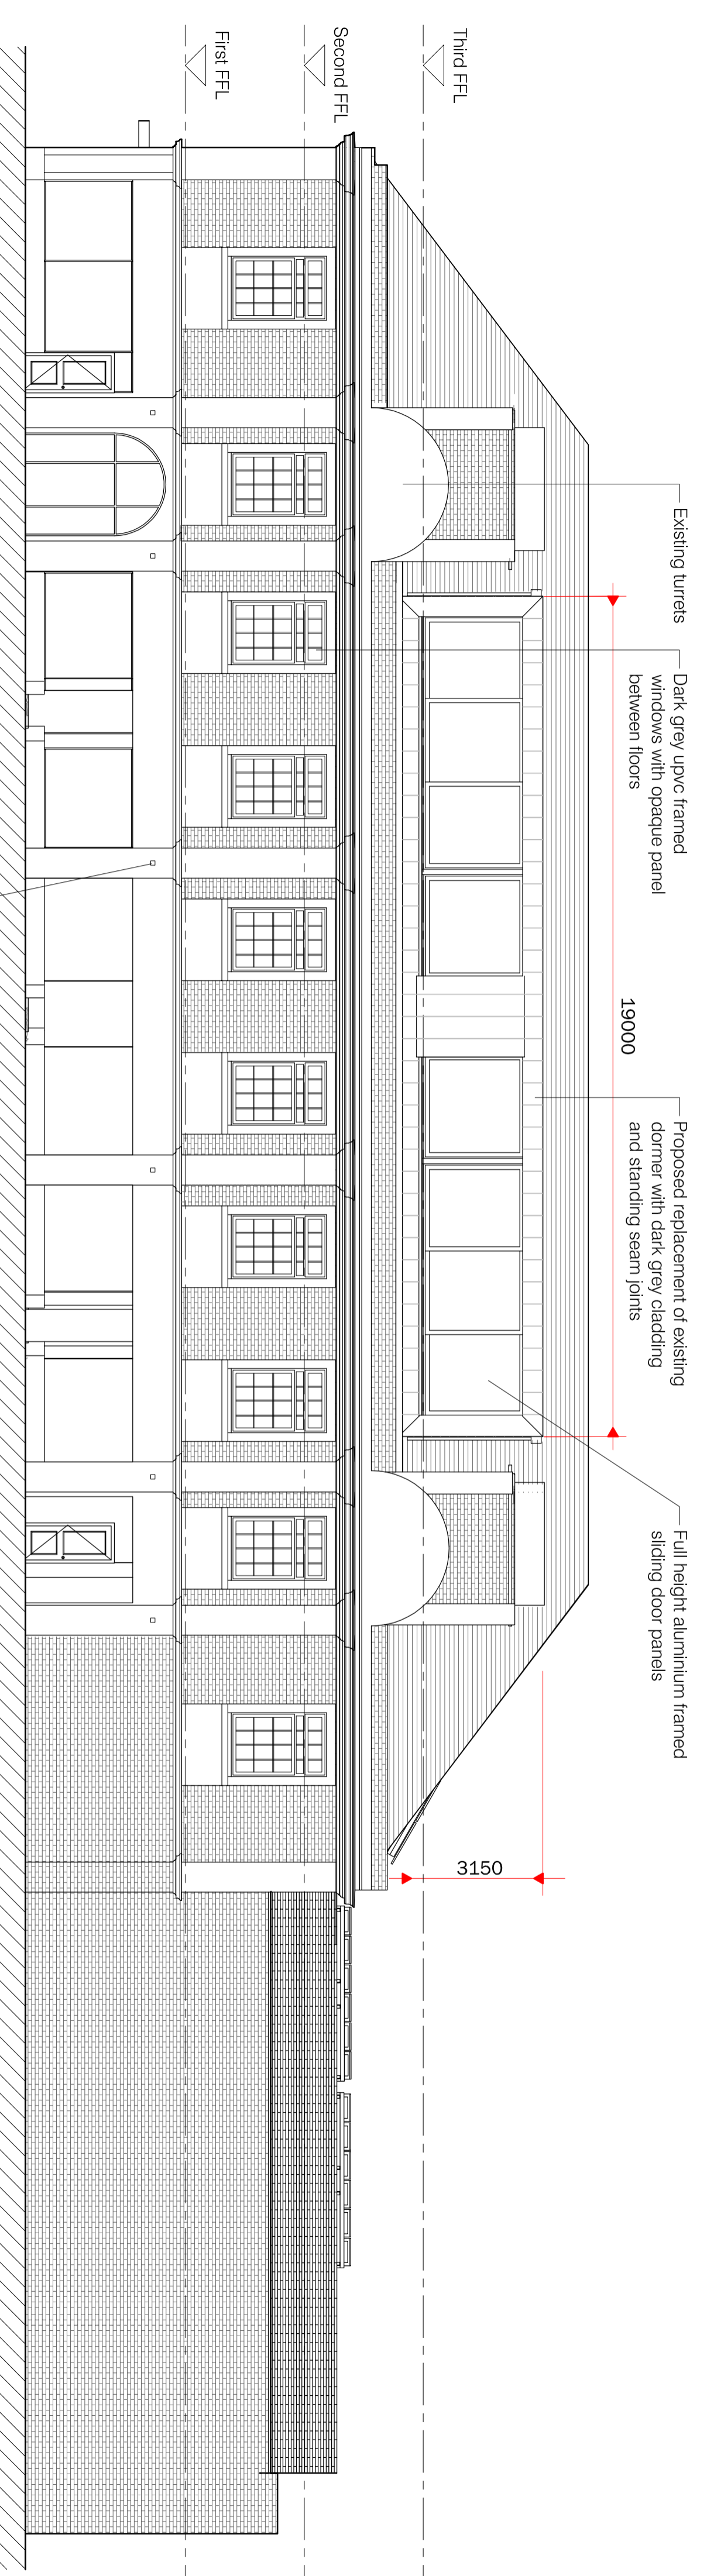

PROPOSED FRONT ELEVATION

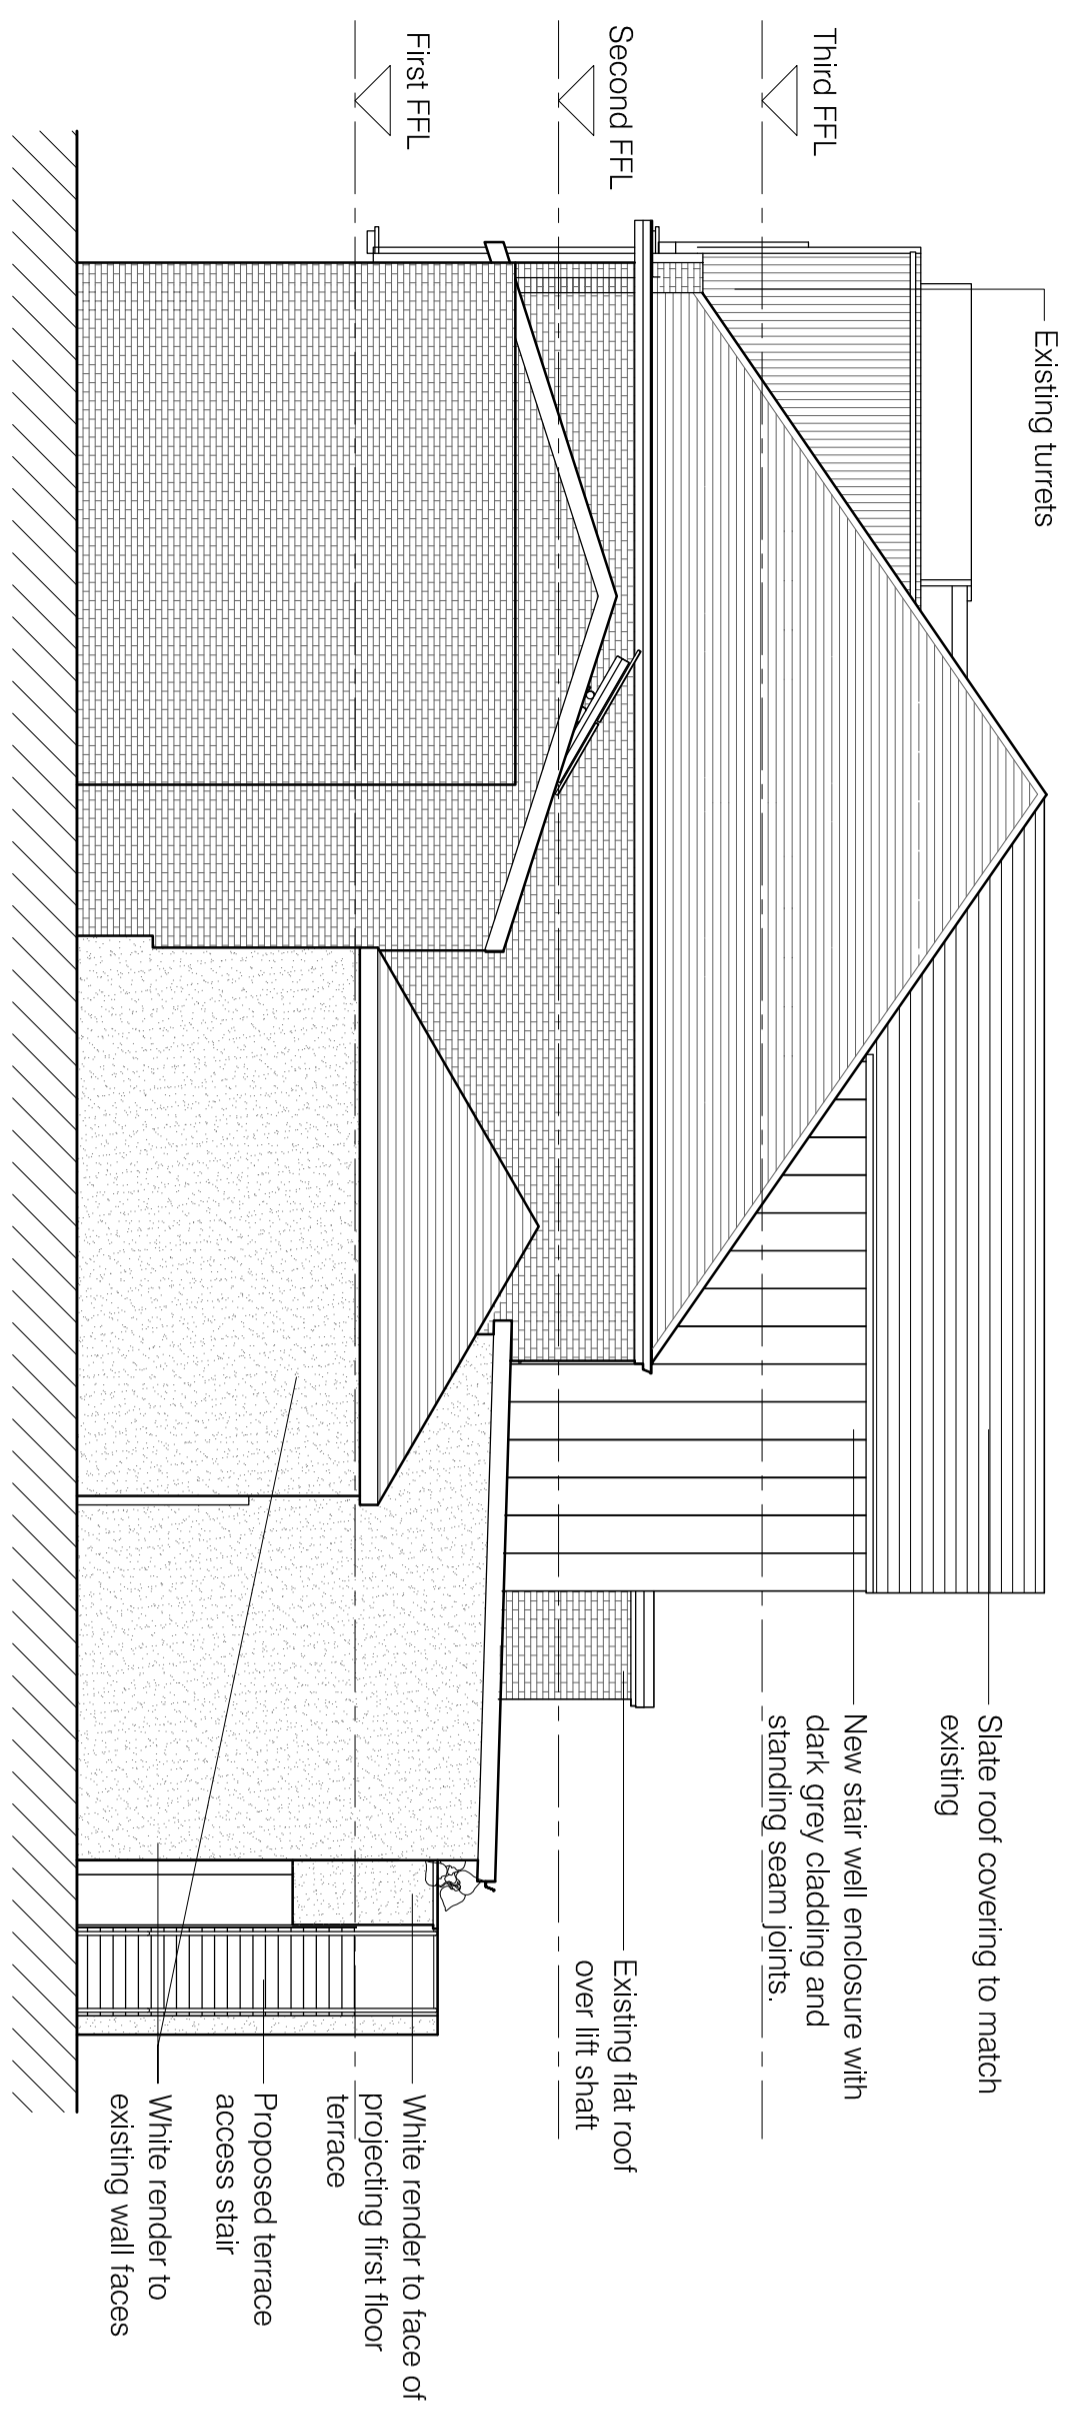

CAR PARK SIDE ELEVATION

AS BUILT

Project Proposed apartments above 1 George Street Whalley	Drawing title Proposed front and car park side elevations	Scale 1:100 @ A2	LMC Architecture Limited Architectural design services
Client Roman Corporation	Drawing number 2232-300 AB	Date 06.07.22	4 Dovegate Drive, Ightenhill, Burnley, Lancashire, BB12 8XD Web: www.lmcarchitecture.co.uk

