




East Elevation

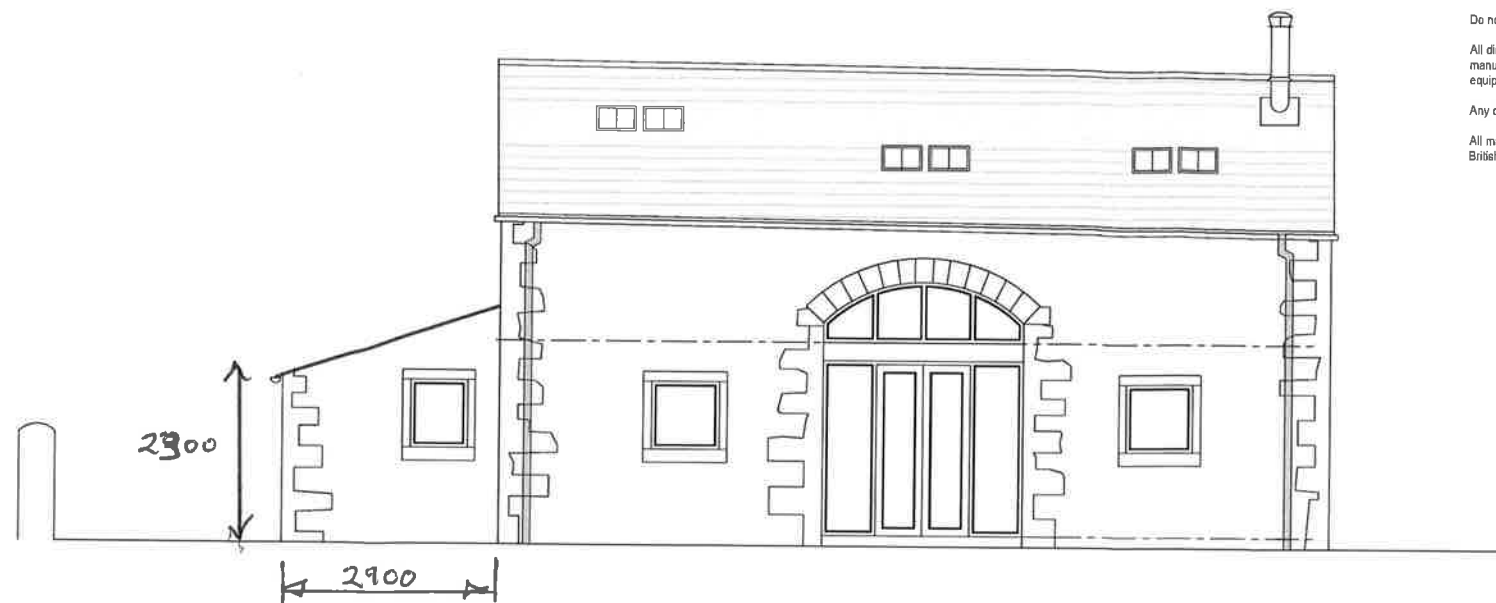

North Elevation

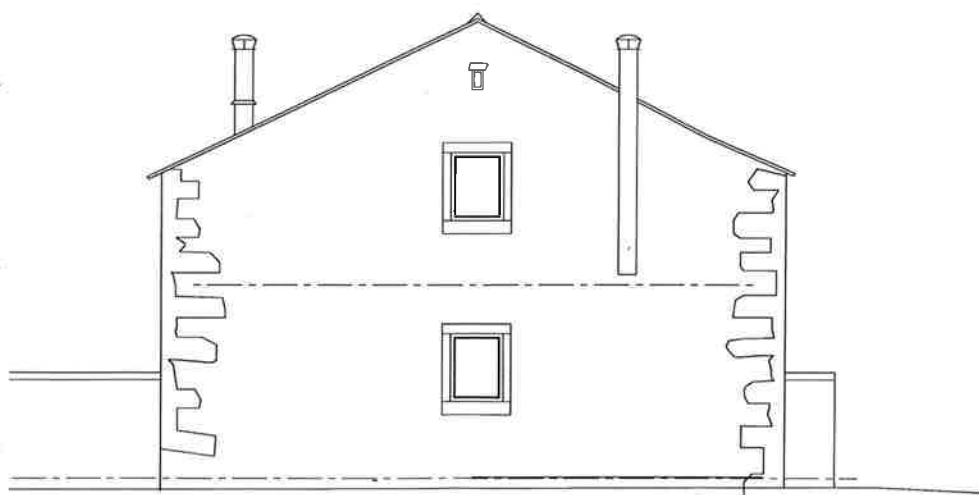

West Elevation

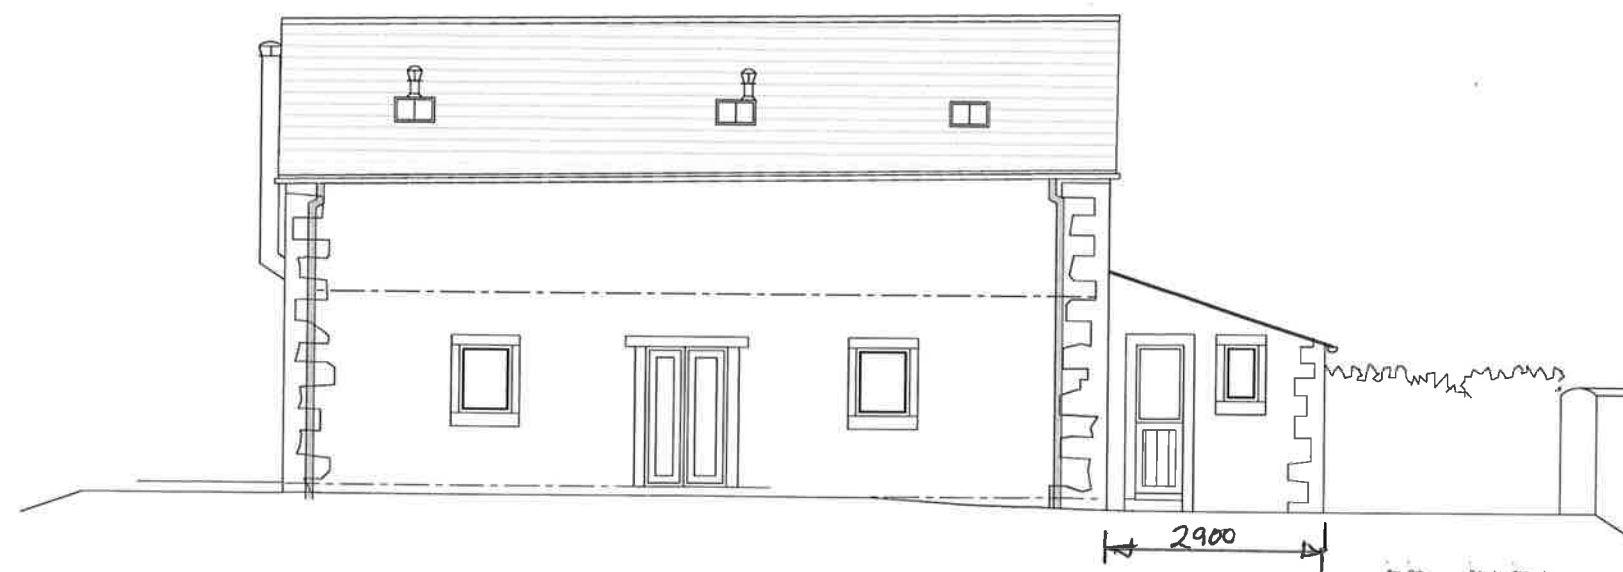

South Elevation

Notes

This drawing is the property of Peak Architecture Ltd and copyright is reserved by them. This drawing is not to be copied or disclosed by or to any unauthorised persons without the prior written consent of Peak Architecture Ltd.

Do not scale from this drawing.

All dimensions are to be checked on site prior to construction, manufacture of any components and ordering of materials and equipment.

Any discrepancies are to be reported to the architect for clarification.

All materials and workmanship to be in accordance with the current British Standards and codes of practice.

Rev	Date	Drawn by	Comments

Client

Project

Betty Barn, Slaidburn Road
Waddington

Drawing

As built Elevations

Date 05.12.2024 Drawn by SFM Scale 1:50 @ A1

Job No - Dwg No - Rev

22065 - 03 - B

PEAK
ARCHITECTURE

22 Hebrow Road, Burnley,
Lancashire, BB10 1NW
Tel: 01282 122455
Mob: 0757739422
Email: info@peakarchitecture.co.uk
Website: www.peakarchitecture.co.uk