




First Floor Plan

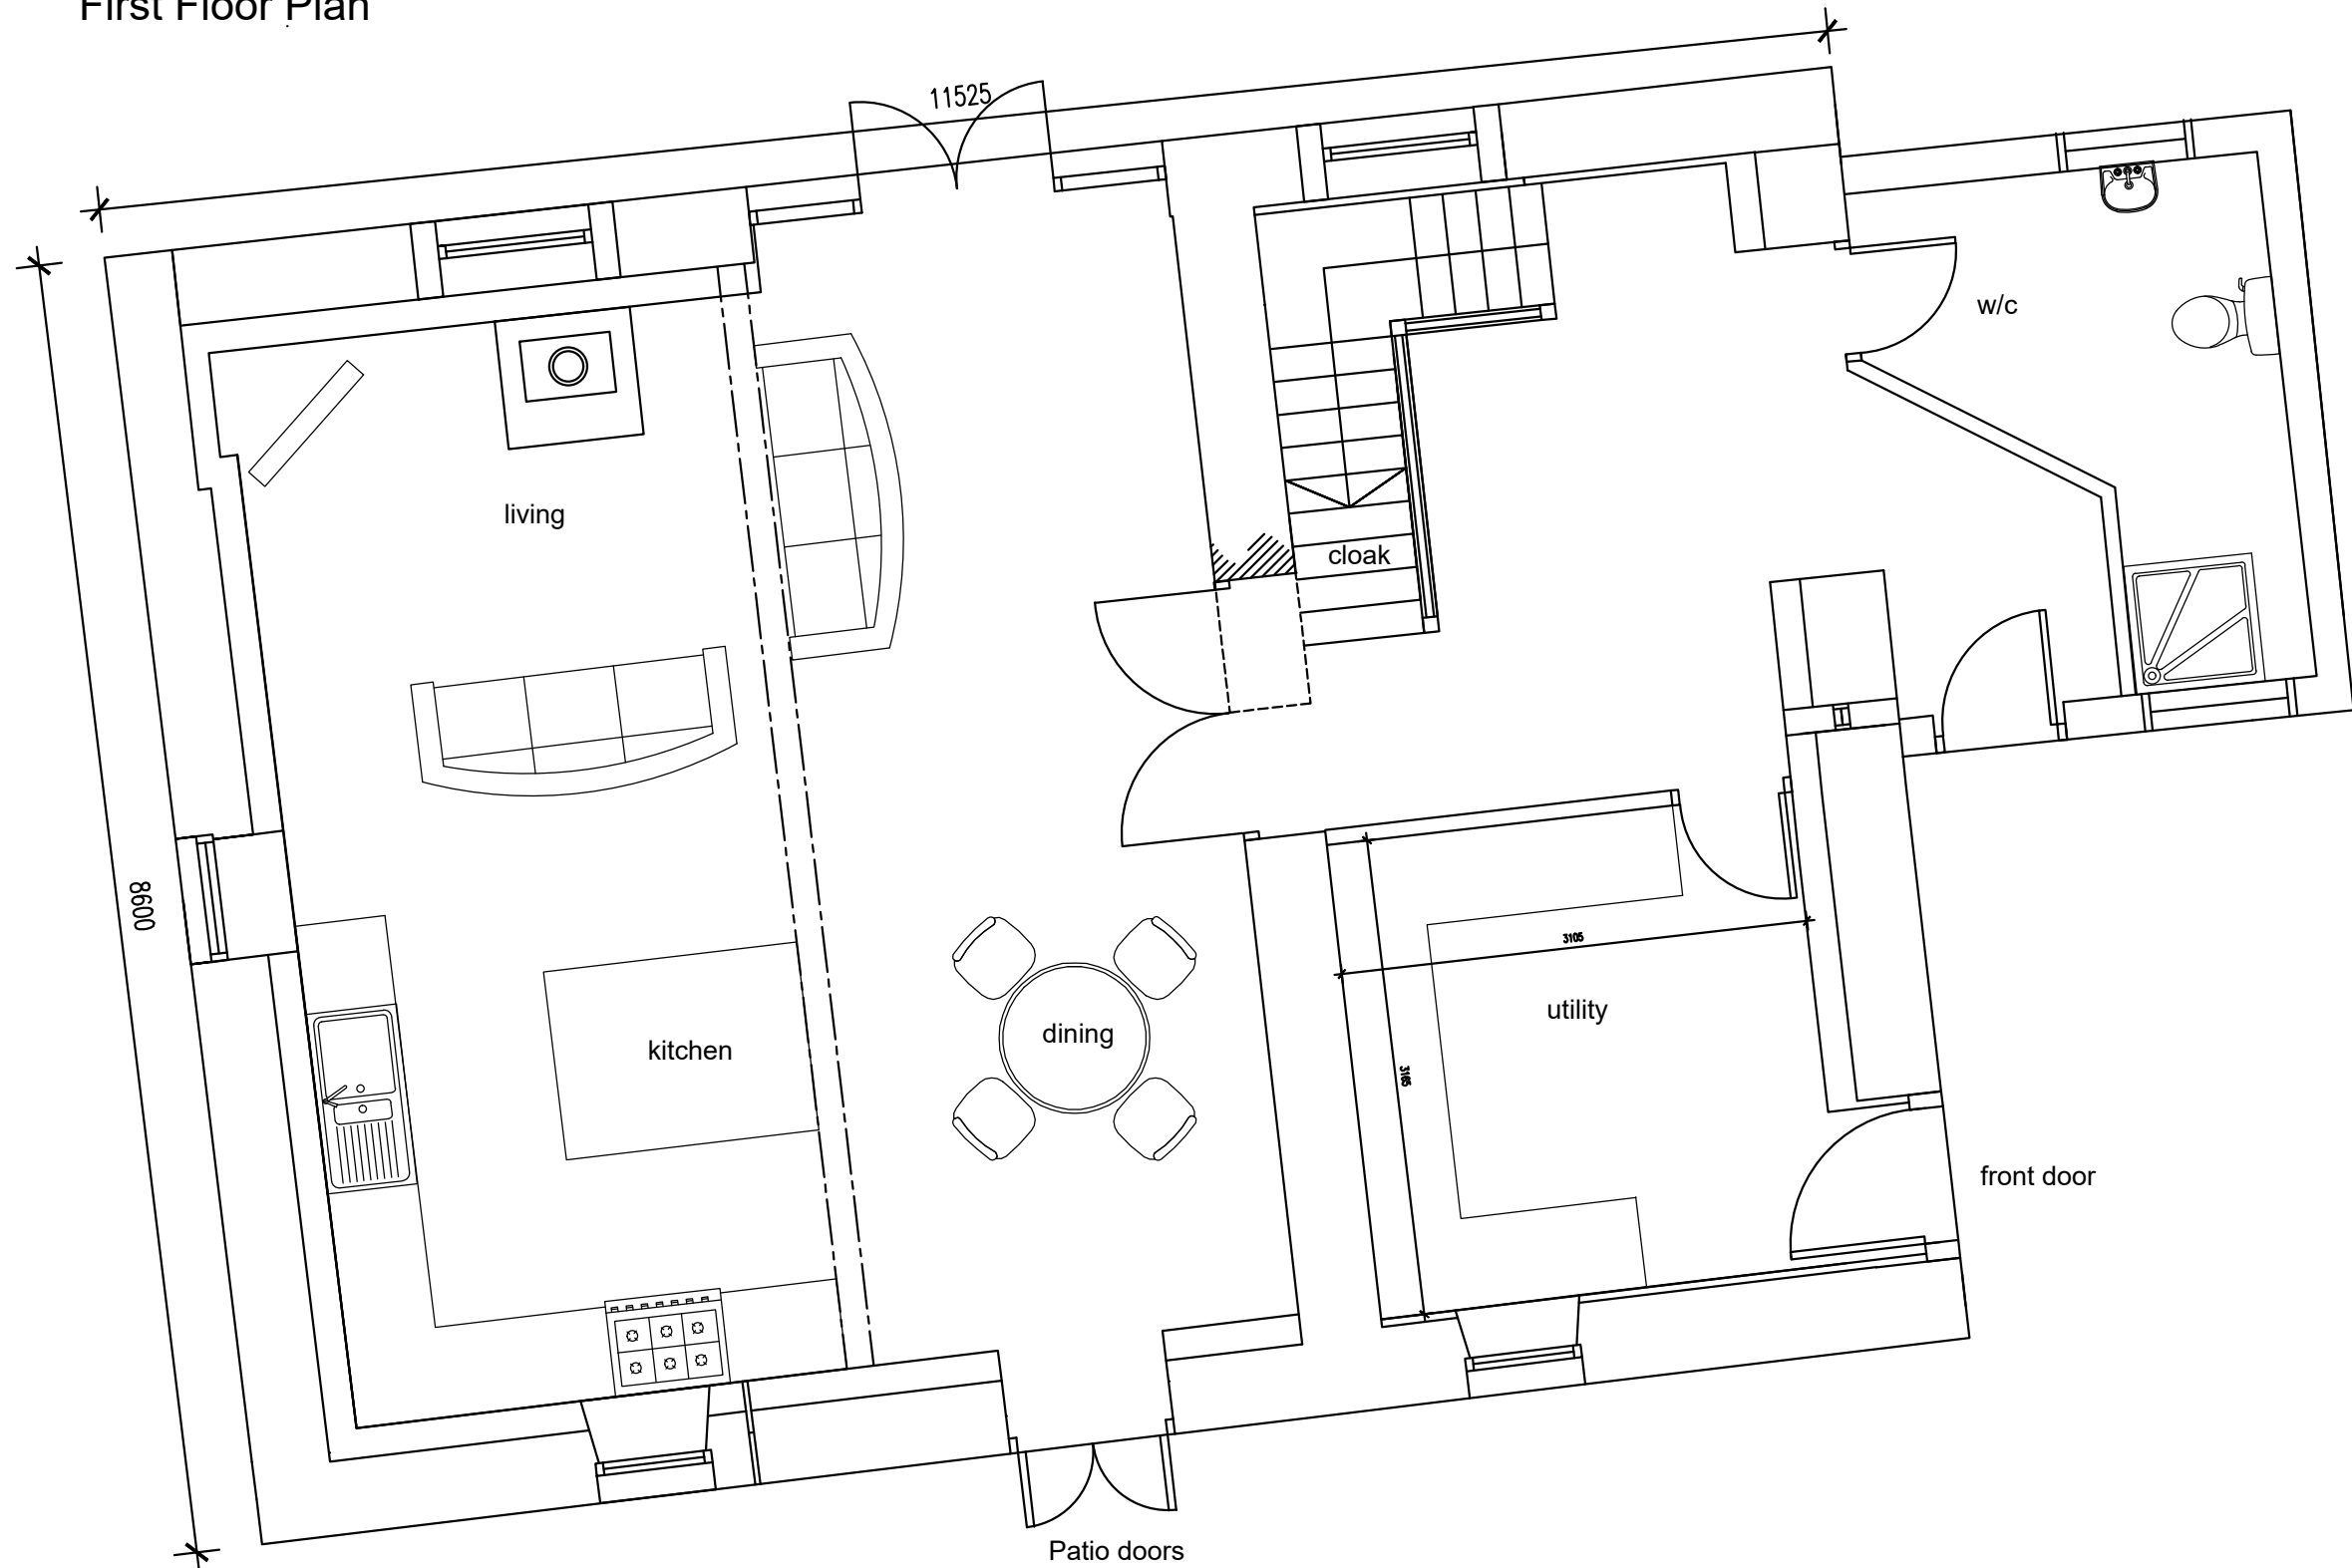

Ground Floor Plan

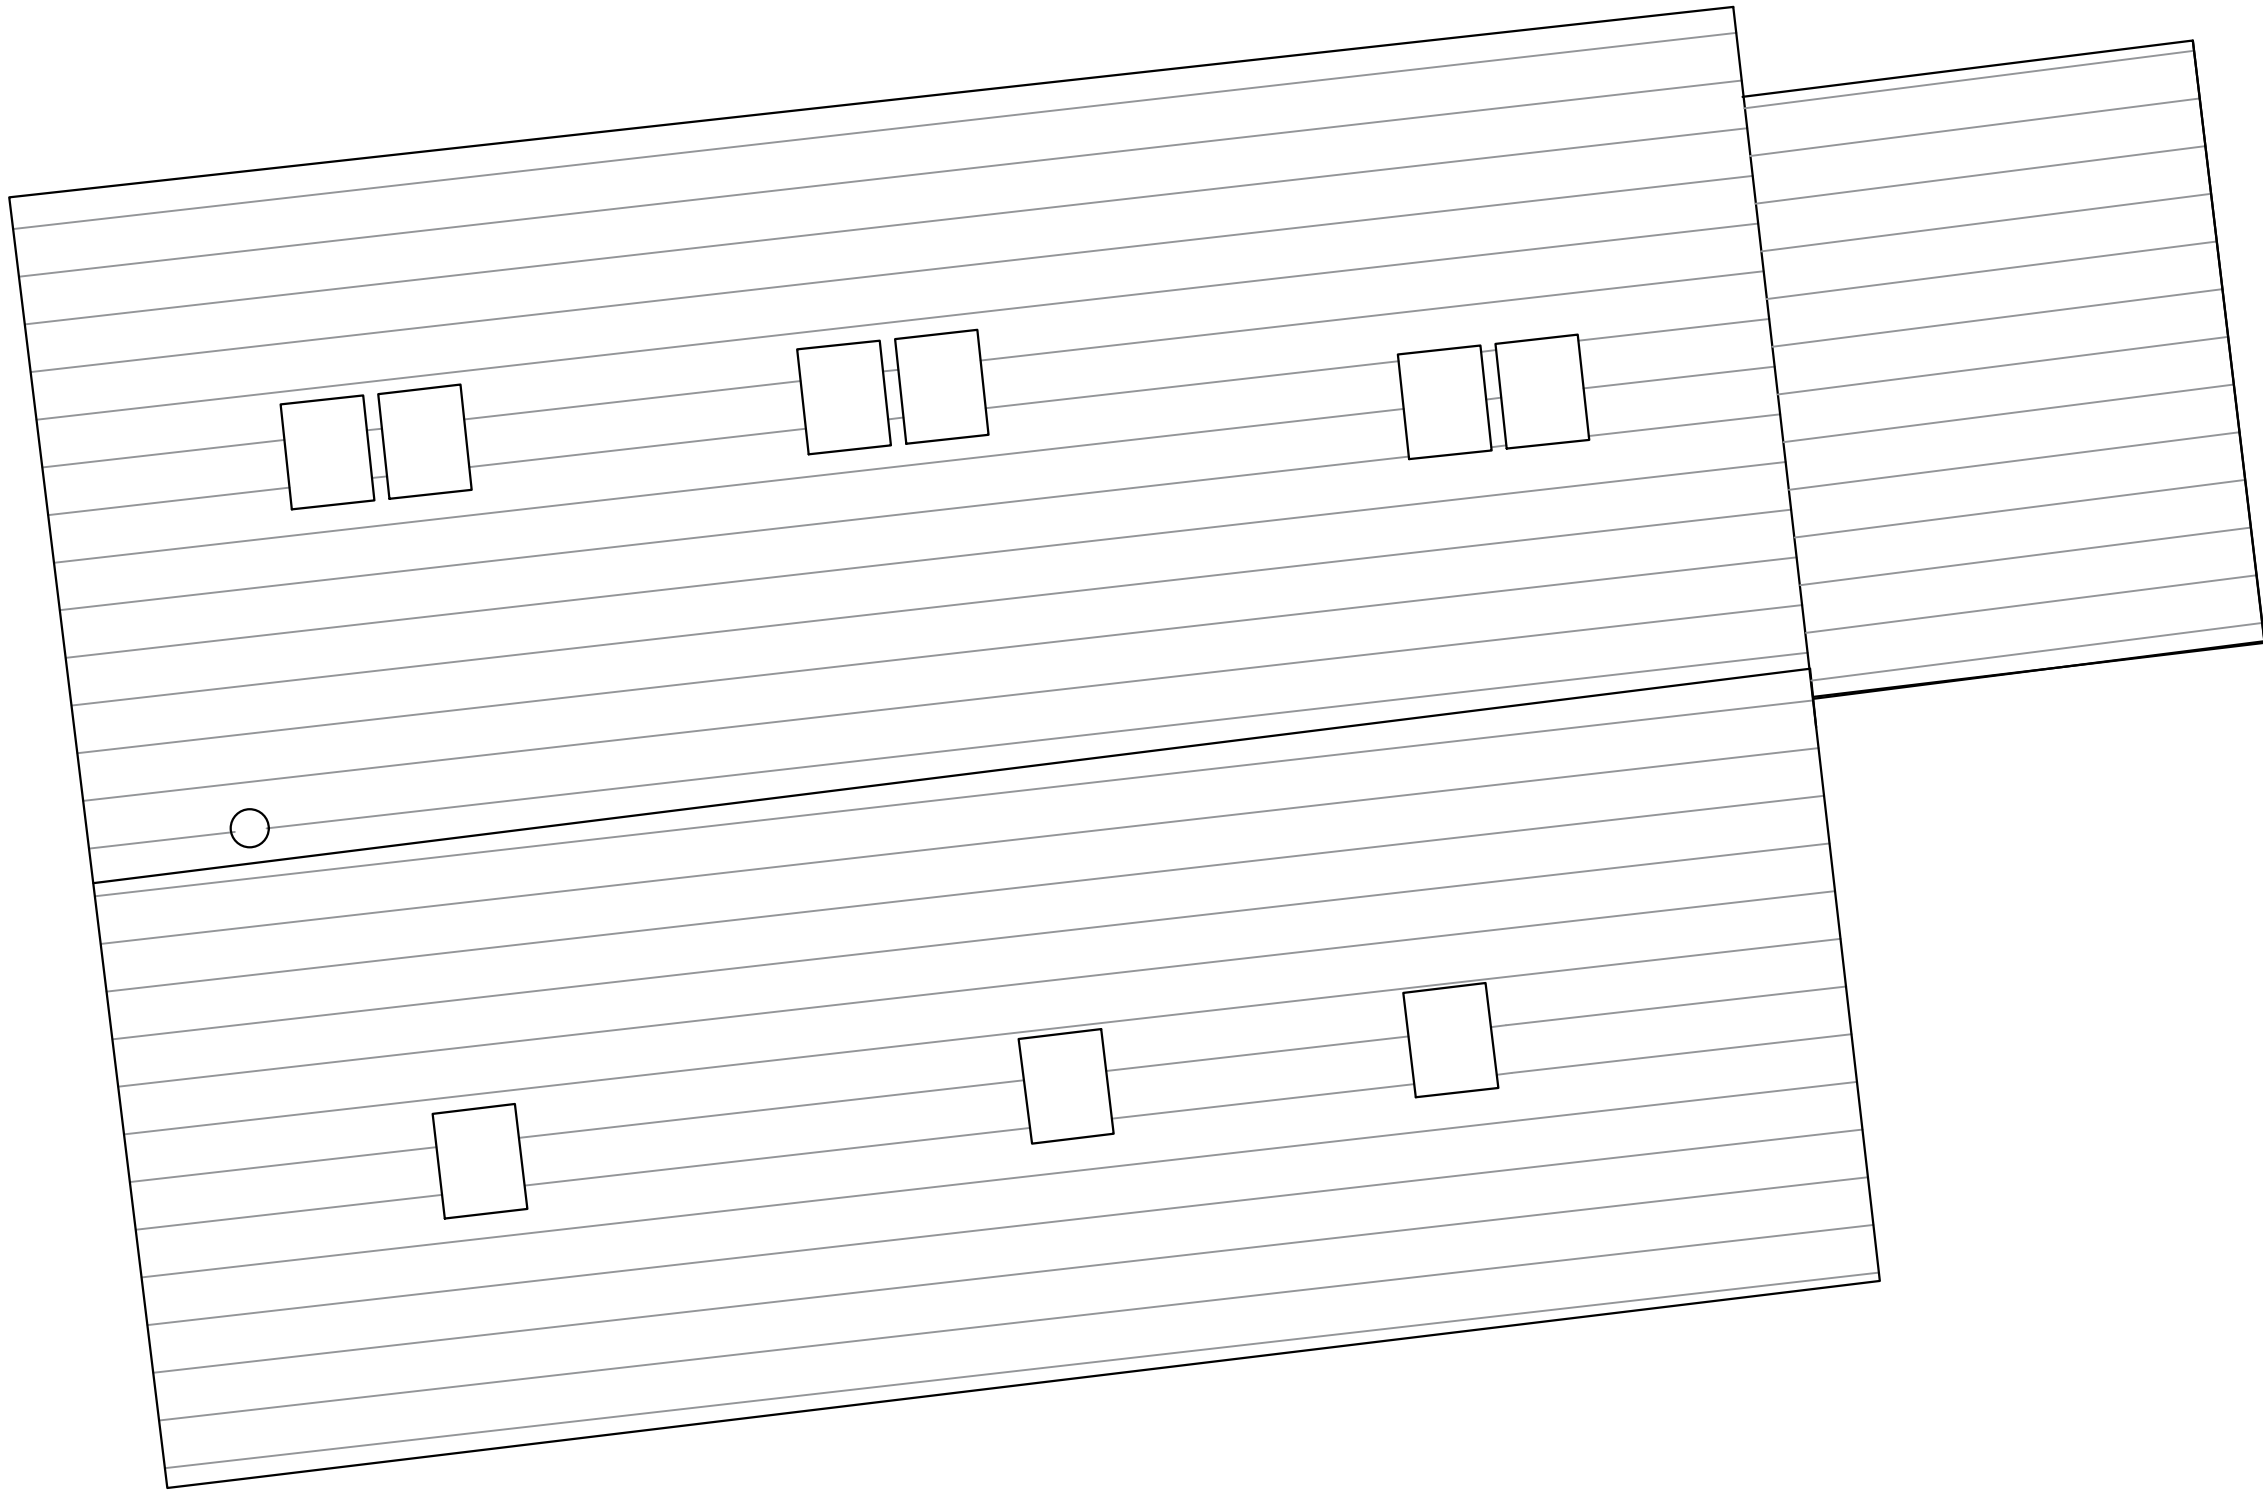

Roof Plan

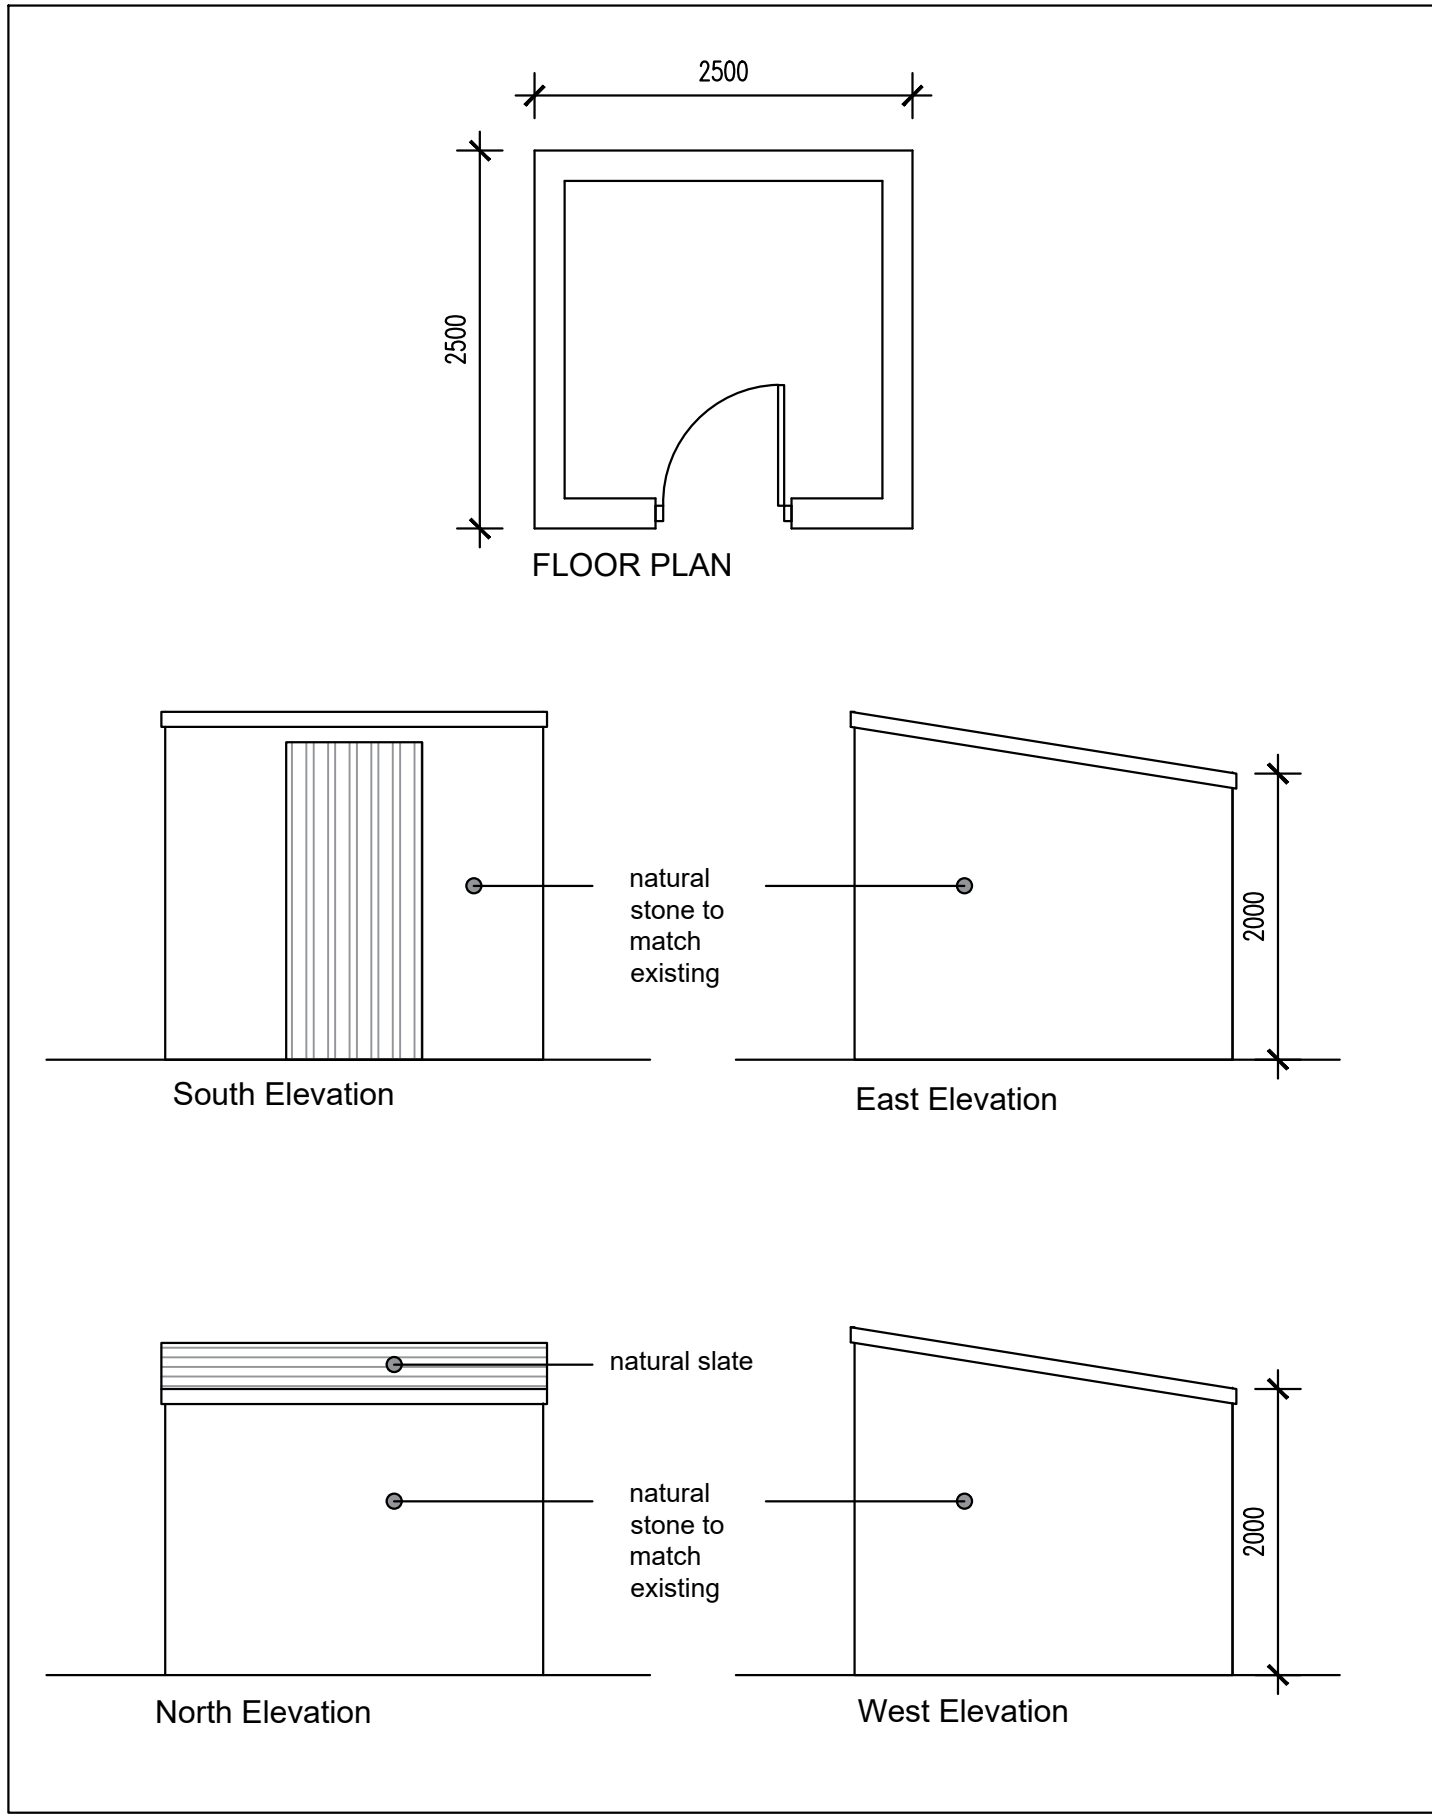

PROPOSED CYCLE
STORAGE

Rev Date Drawn by Comments
Client

Project
Betty Barn, Slaidburn Road
Waddington

Drawing
As built Plans
Date 05.12.2024 Drawn by SFM Scales 1:50 @ A1

Job No - Dwg No - Rev
22065 - 02 - B