


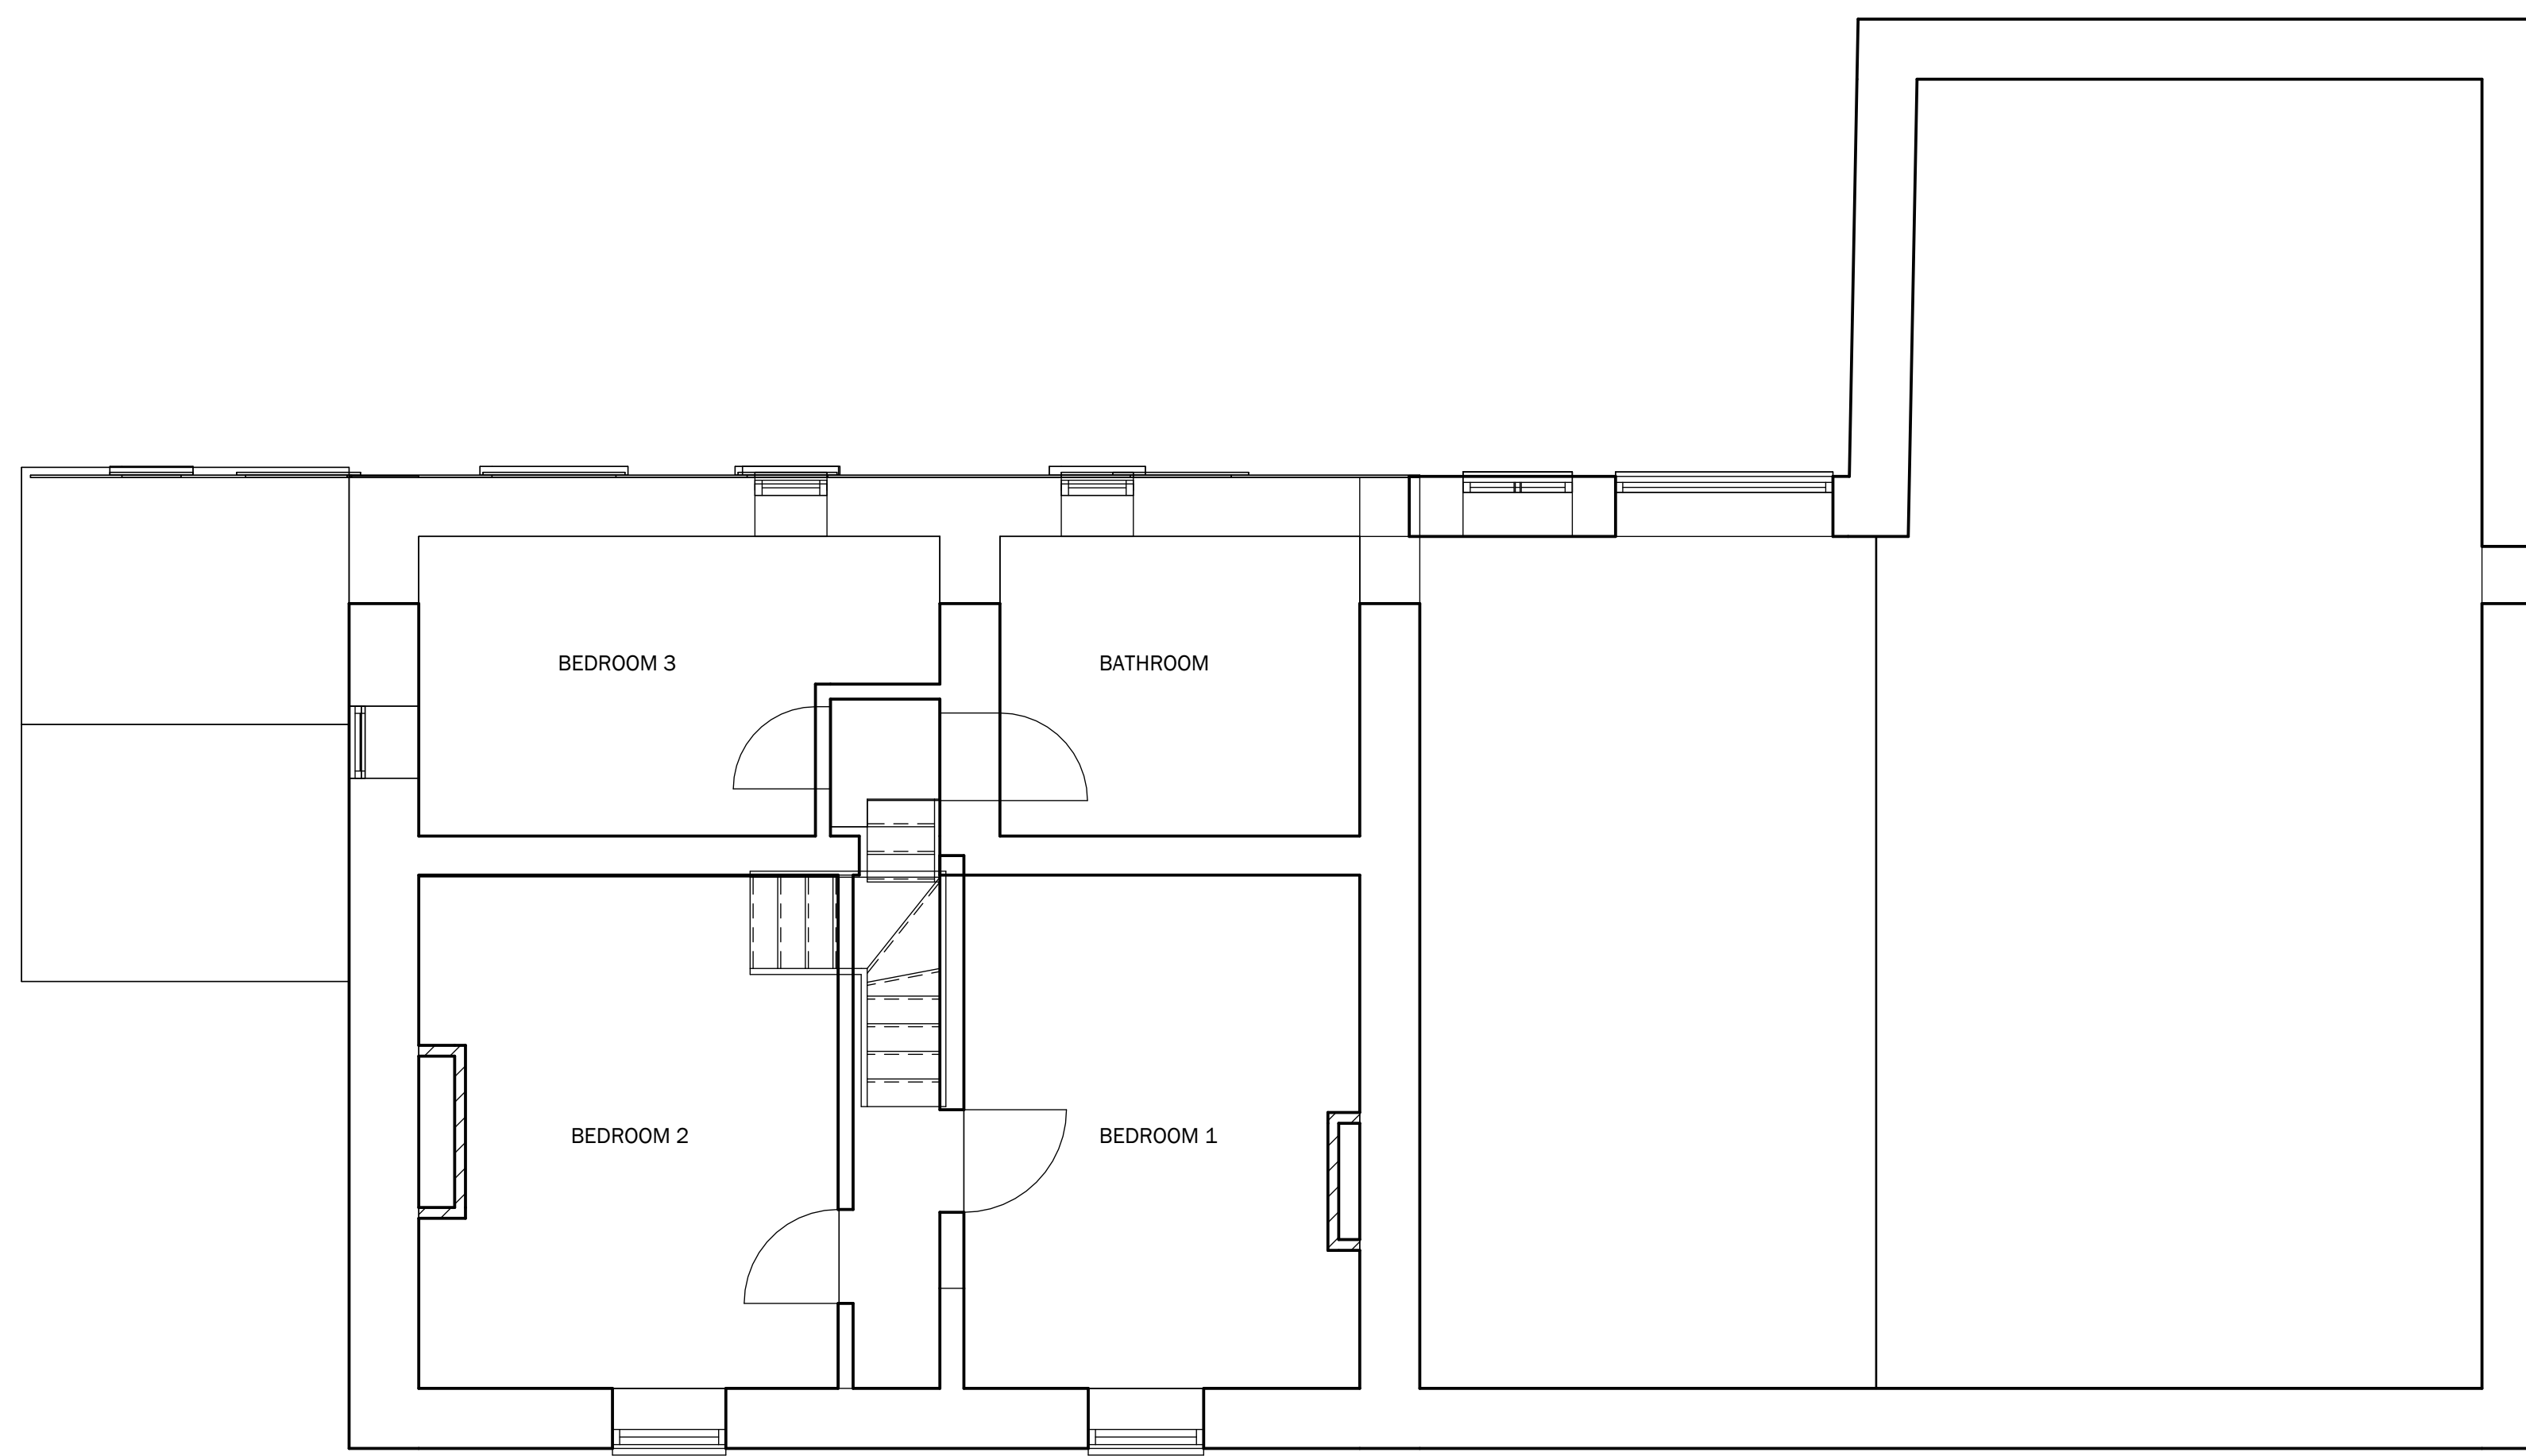

NOTES:

[illegible]

CLIENT: **MAGGIE NICHOLSON**  
**CROSS TREES**  
**6 WHALLEY ROAD**  
**HURST GREEN**  
**LANCASHIRE**  
**BB7 9QJ**

|            |        |
|------------|--------|
| Scale      | 1 : 50 |
| Sheet size | A1     |