


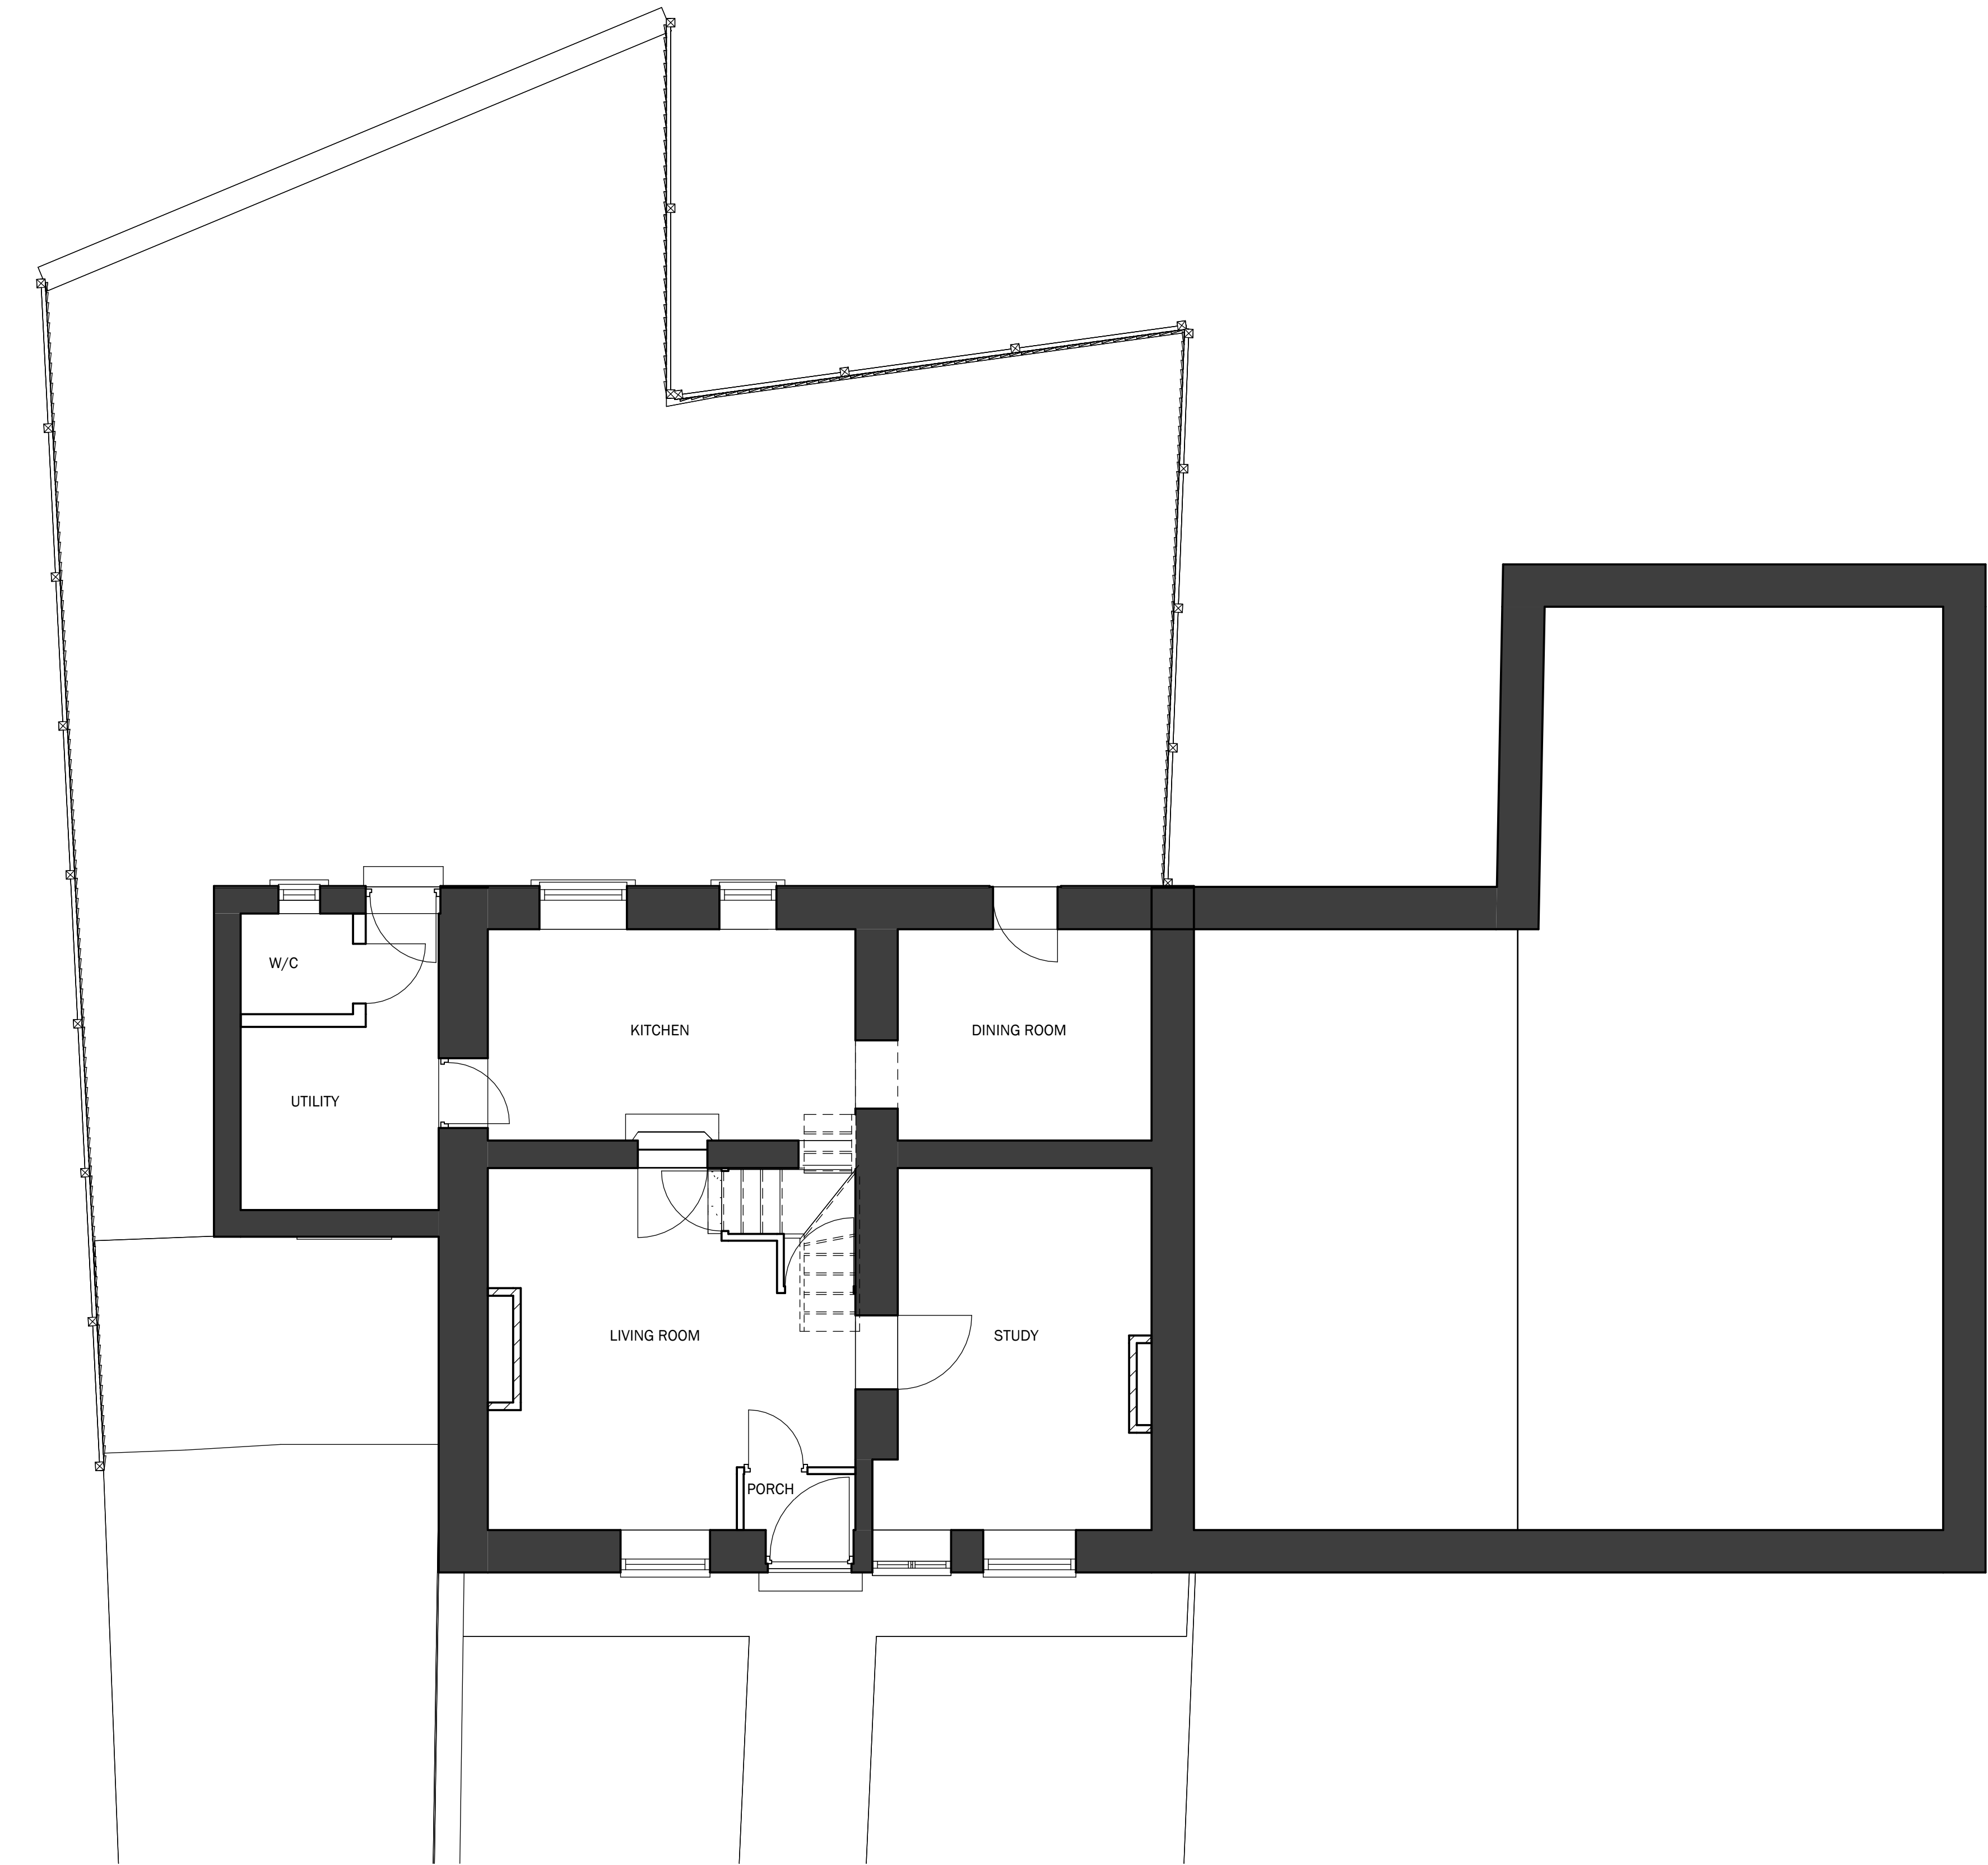

1 0 GROUND FLOOR
1 : 50

NOTES:

No.	Description	Date

CLIENT: MAGGIE NICHOLSON
CROSS TREES
6 WHALLEY ROAD
HURST GREEN
LANCASHIRE
BB7 9QJ
