

NOTES:

No.	Description	Date

CLIENT: Mr & Mrs Towler
Loft Shay Farm
Clitheroe Road
Knowle Green
PR3 2YQ

PROJECT:

BARN CONVERSION

SHEET:

Existing Elevations

Project number PHA/617

Date 11/02/2025


Drawn by LW

Checked by PH


A2.2.1

Scale 1 : 50

Sheet size A1

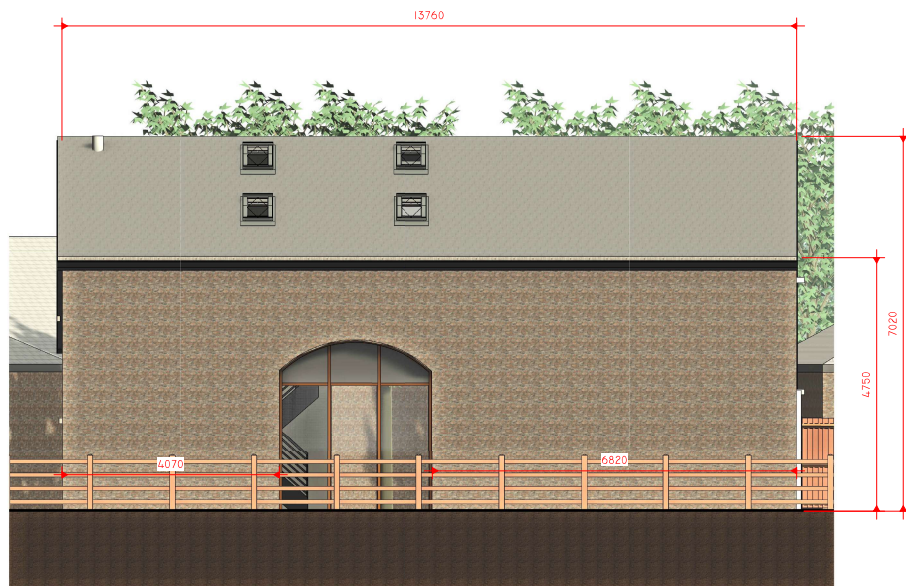

3 Existing North East
1 : 50

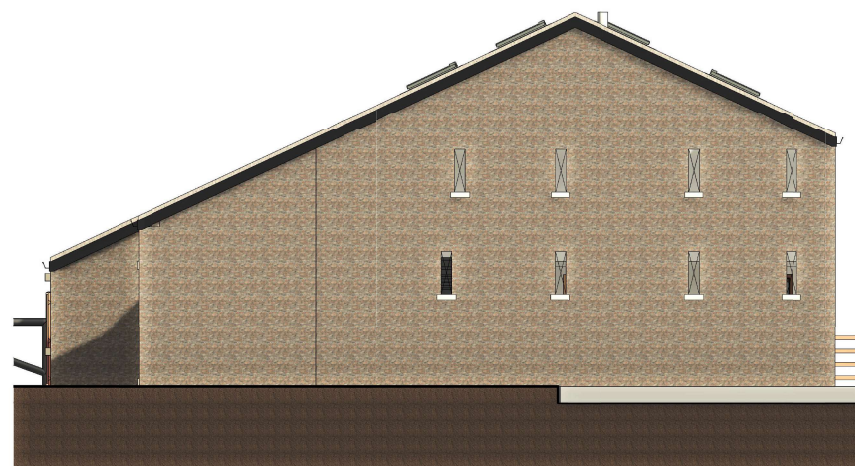

4 Existing South East
1 : 50



2 Existing North West
1 : 50



1 Existing South West
1 : 50