

NOTES:

No.	Description	Date

CLIENT: Mr & Mrs Towler
Loft Shay Farm
Clitheroe Road
Knowle Green
PR3 2YQ

PROJECT:
BARN CONVERSION

SHEET:
Existing Plans

Project number PHA/617

Date 11/02/2025


Drawn by LW

Checked by PH


A1.4

Scale 1 : 50

Sheet size A1

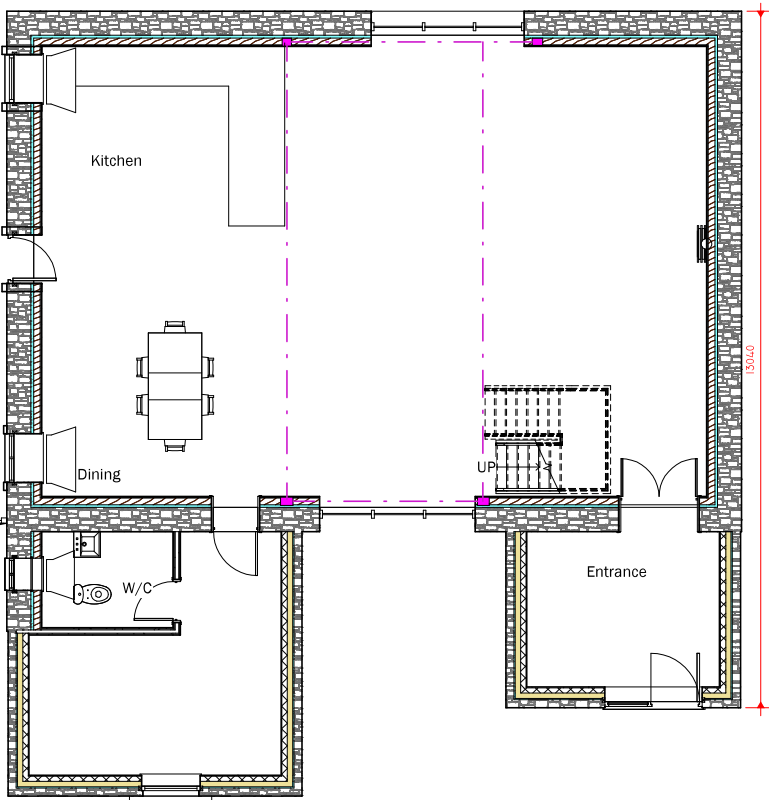

1 Existing Ground Floor
1 : 50

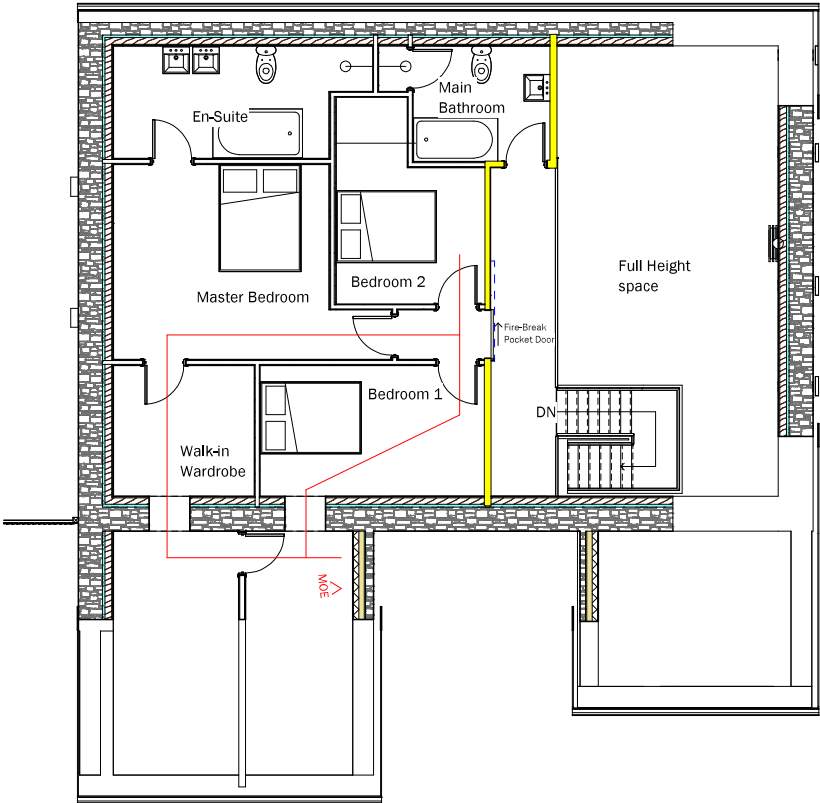

2 Existing First Floor
1 : 50