

EXISTING NORTH ELEVATION


Scale 1:100

EXISTING WEST ELEVATION

Scale 1:100

EXISTING SOUTH ELEVATION

Scale 1:100

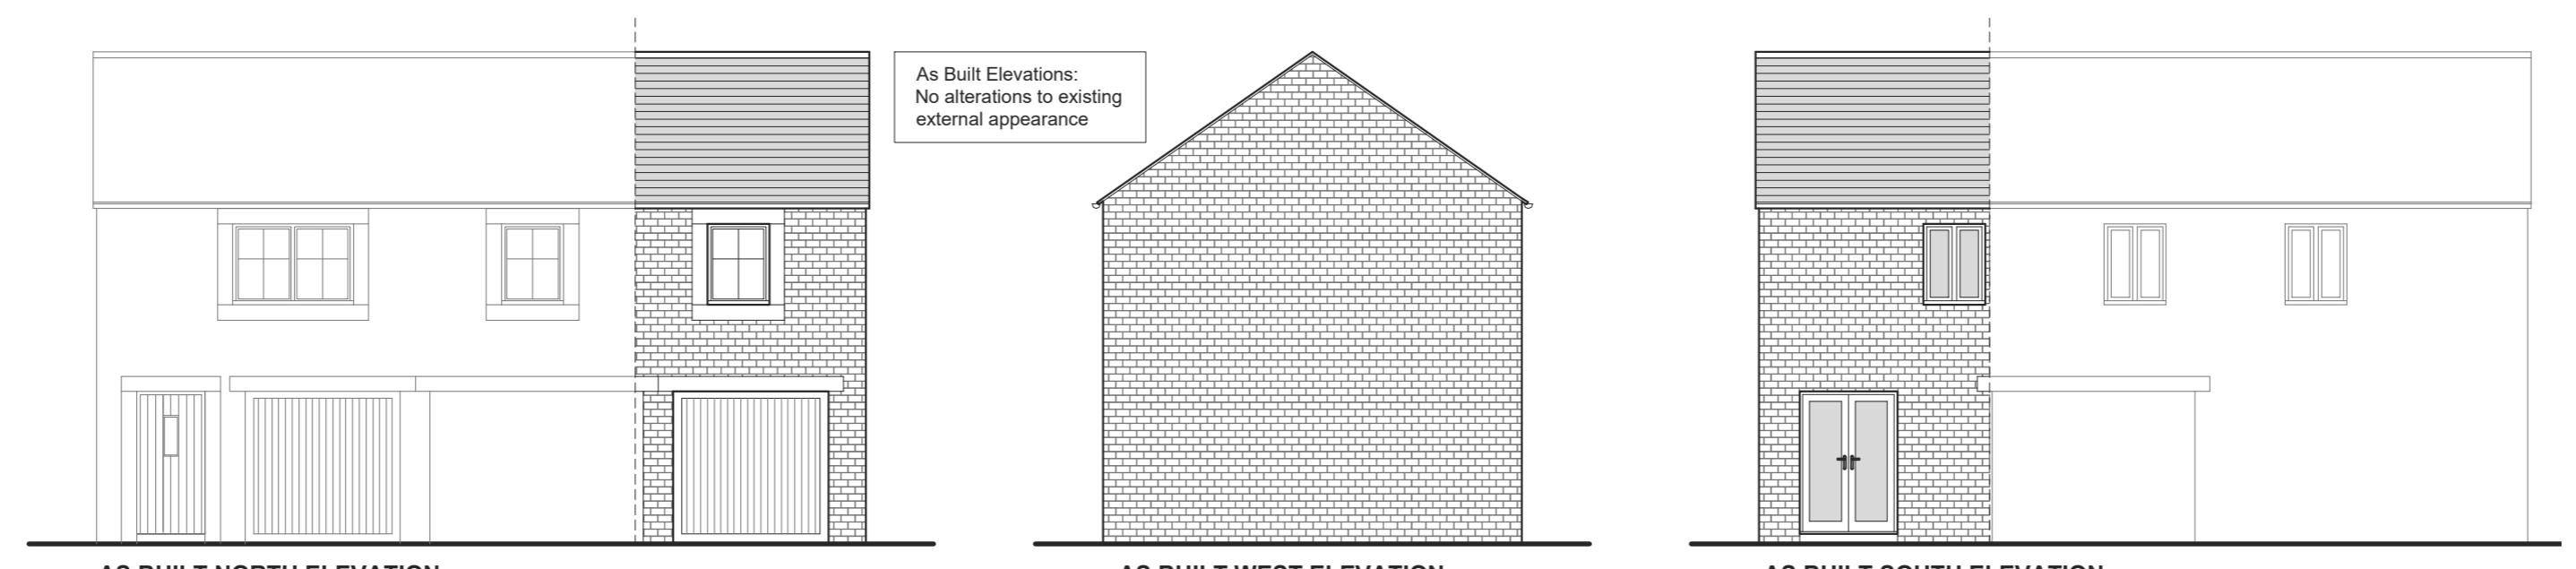

AS BUILT NORTH ELEVATION


Scale 1:100

AS BUILT WEST ELEVATION

Scale 1:100


AS BUILT SOUTH ELEVATION

Scale 1:100

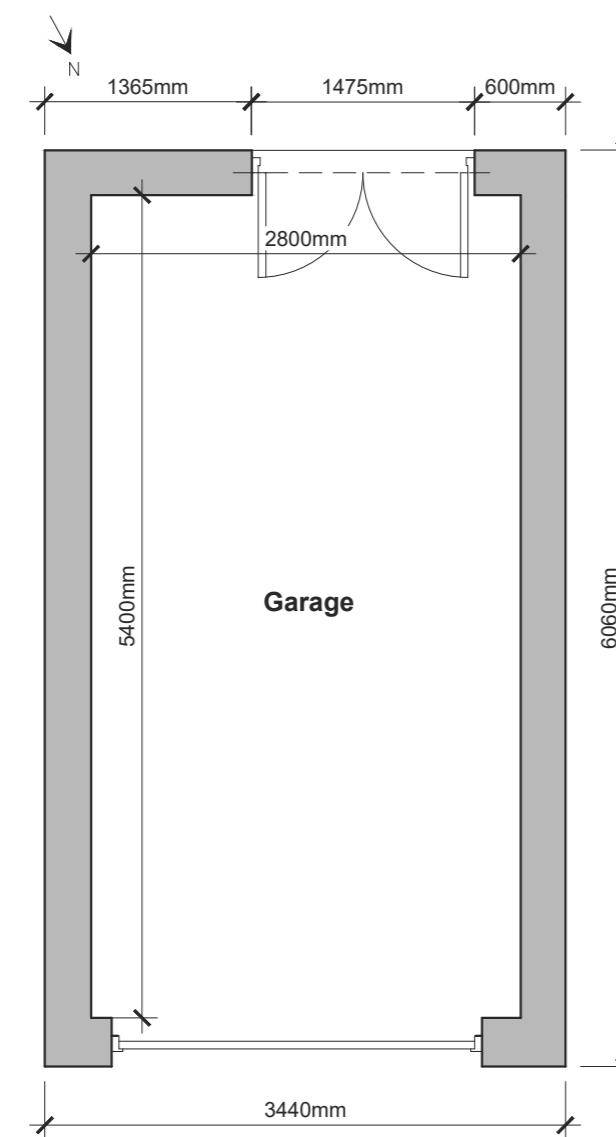


EXISTING FLOOR PLAN

Scale 1:50

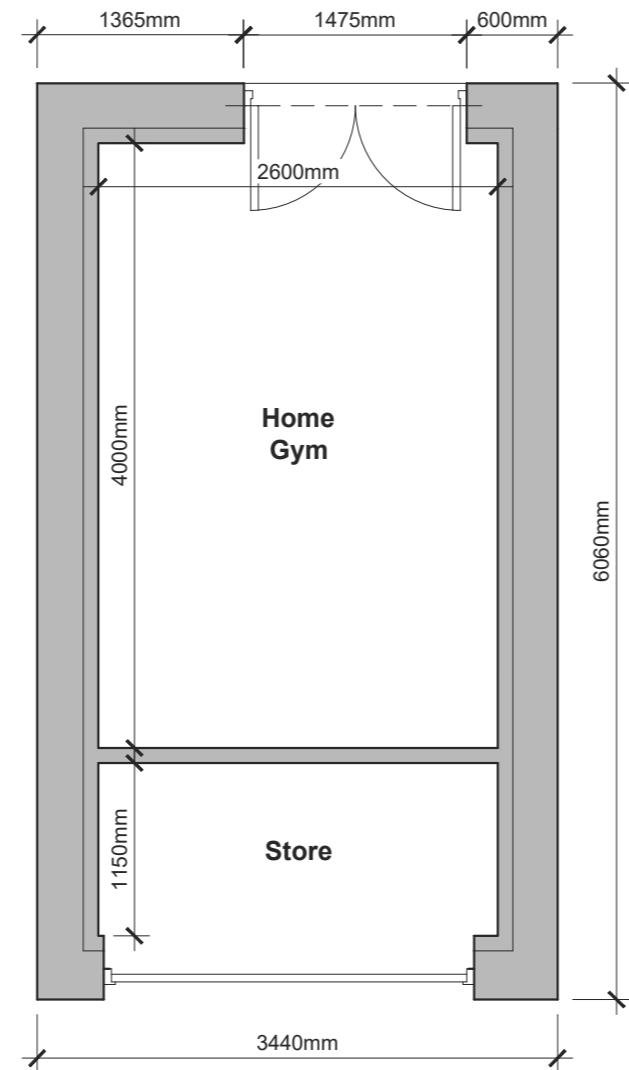

AS BUILT FLOOR PLAN

Scale 1:50

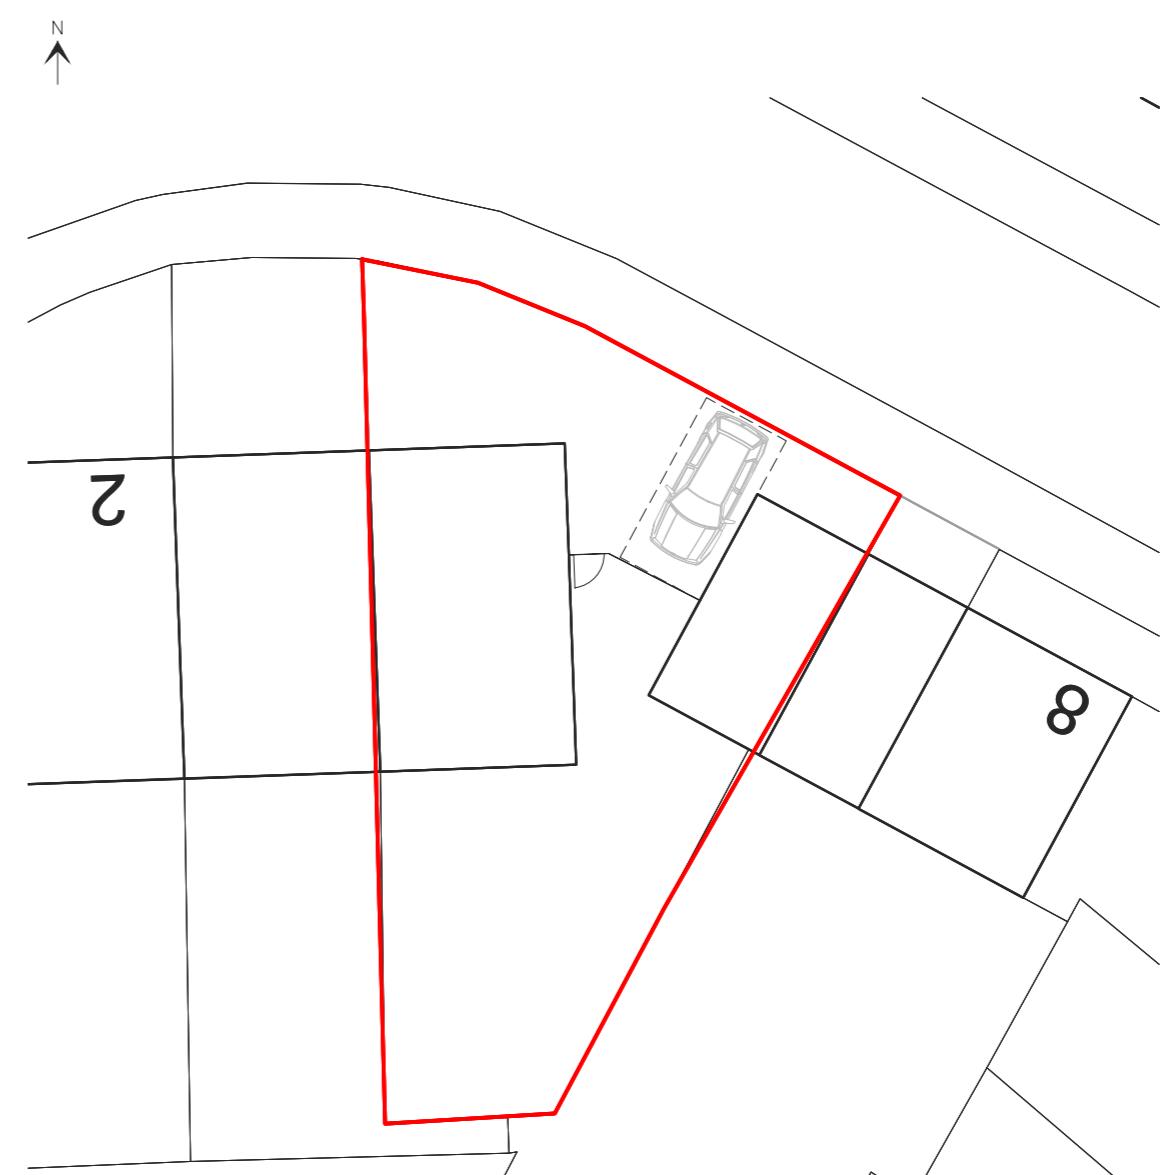

SITE PLAN

Scale 1:200