




2 EXISTING NORTH WEST -
AS BUILT
1 : 100



1 PROPOSED NORTH WEST
1 : 100

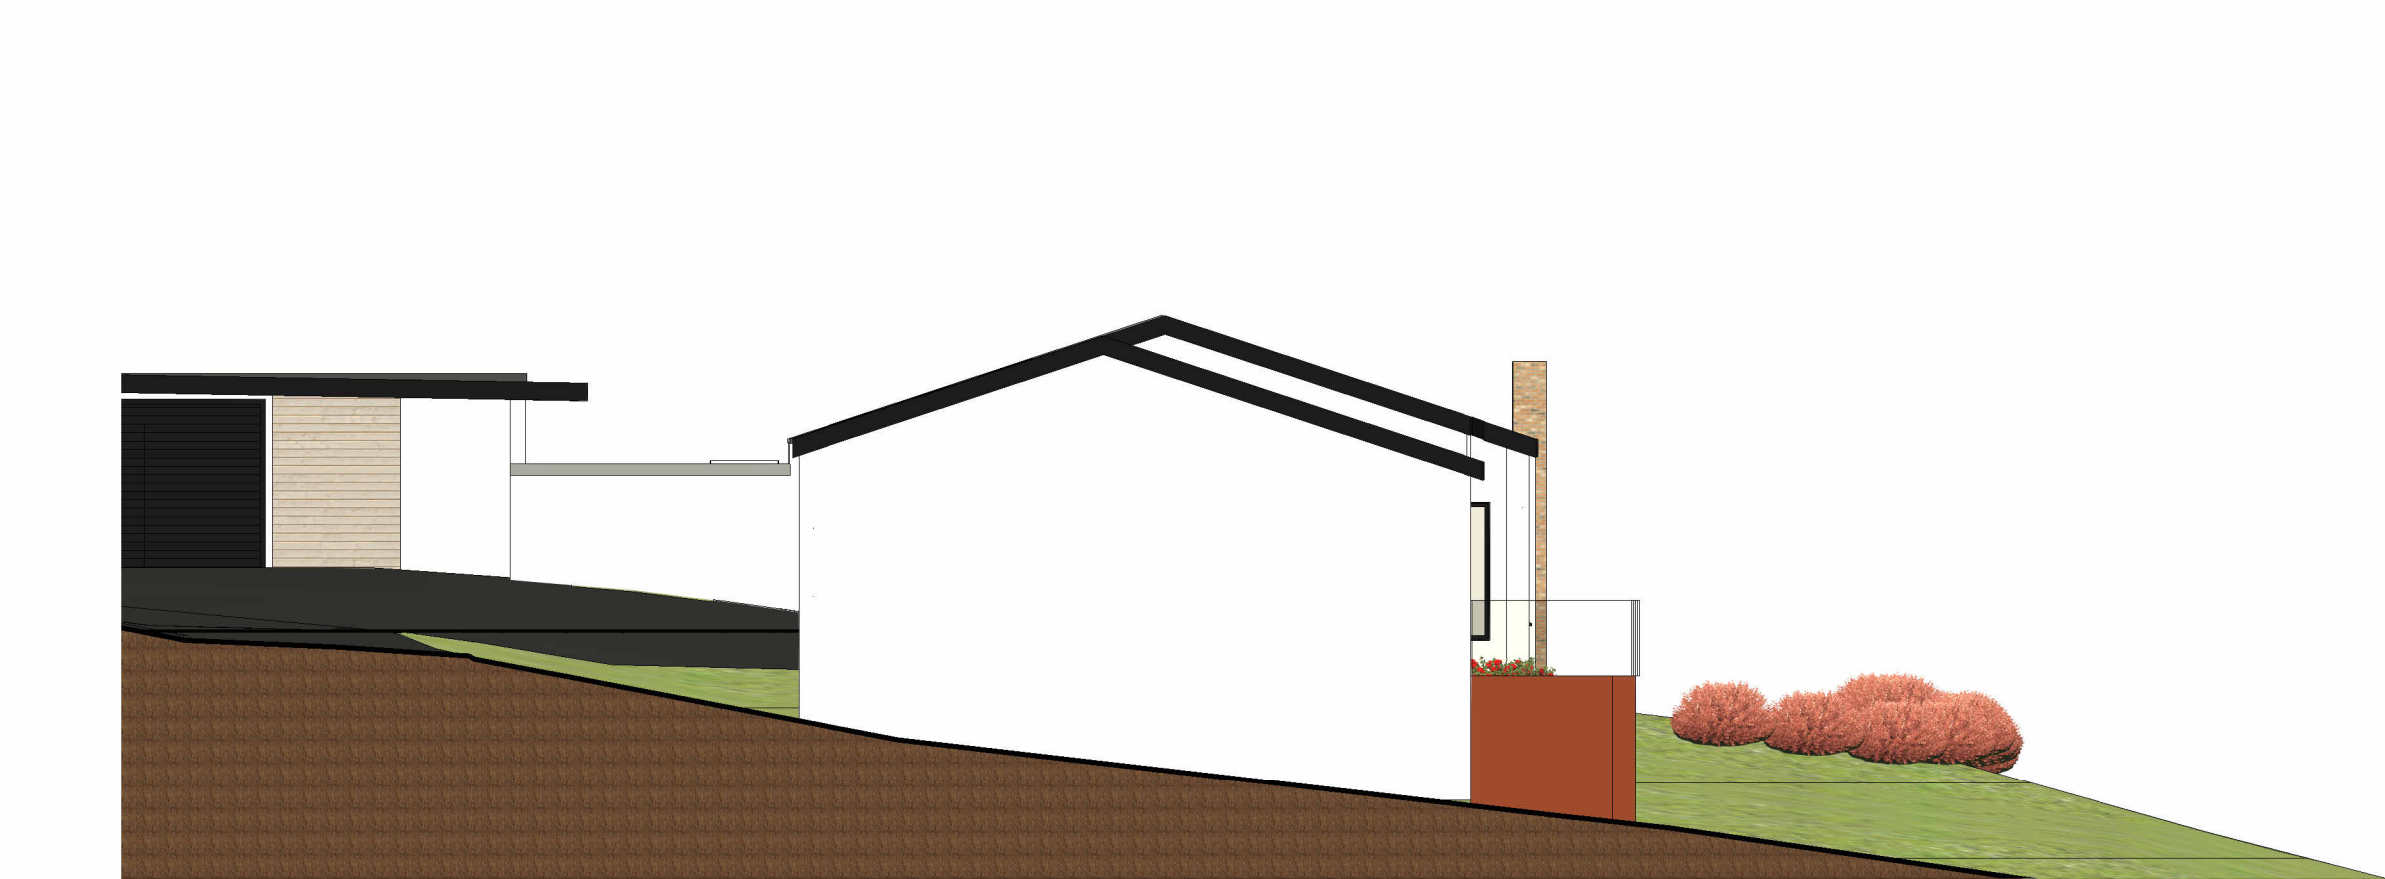

3 PROPOSED NORTH EAST
1 : 100



4 EXISTING NORTH EAST -
AS BUILT
1 : 100

Peter Hitchen
Architects

Marathon House
The Sidings Business Park
Whalley, BB7 9SE

01254 823 885

www.peterhitchenarchitects.co.uk

NOTES:

No.	Description	Date

CLIENT:

MR & MRS HOWARTH

PROJECT:

ALTERATIONS & SIDE
EXTENSION TO 42 PAINTER
WOOD

SHEET:

EXISTING AND PROPOSED
ELEVATIONS FRONT

Project number PHA/410

Date 12/12/2019

Drawn by RH

Checked by PH

A300

Scale 1 : 100

Sheet size A1