



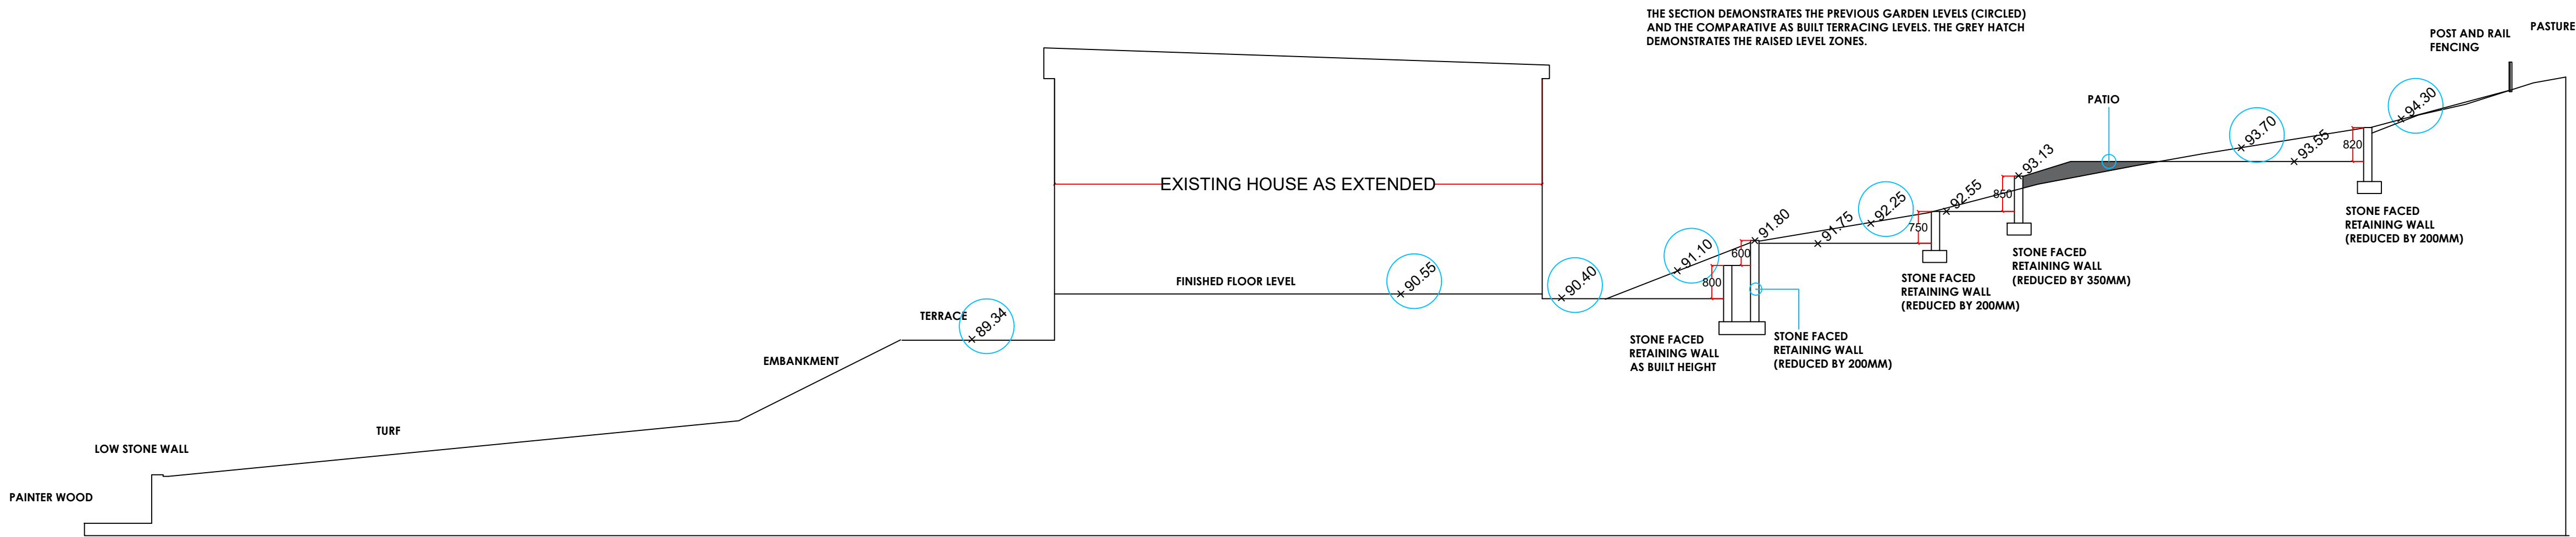

CROSS SECTION A - A

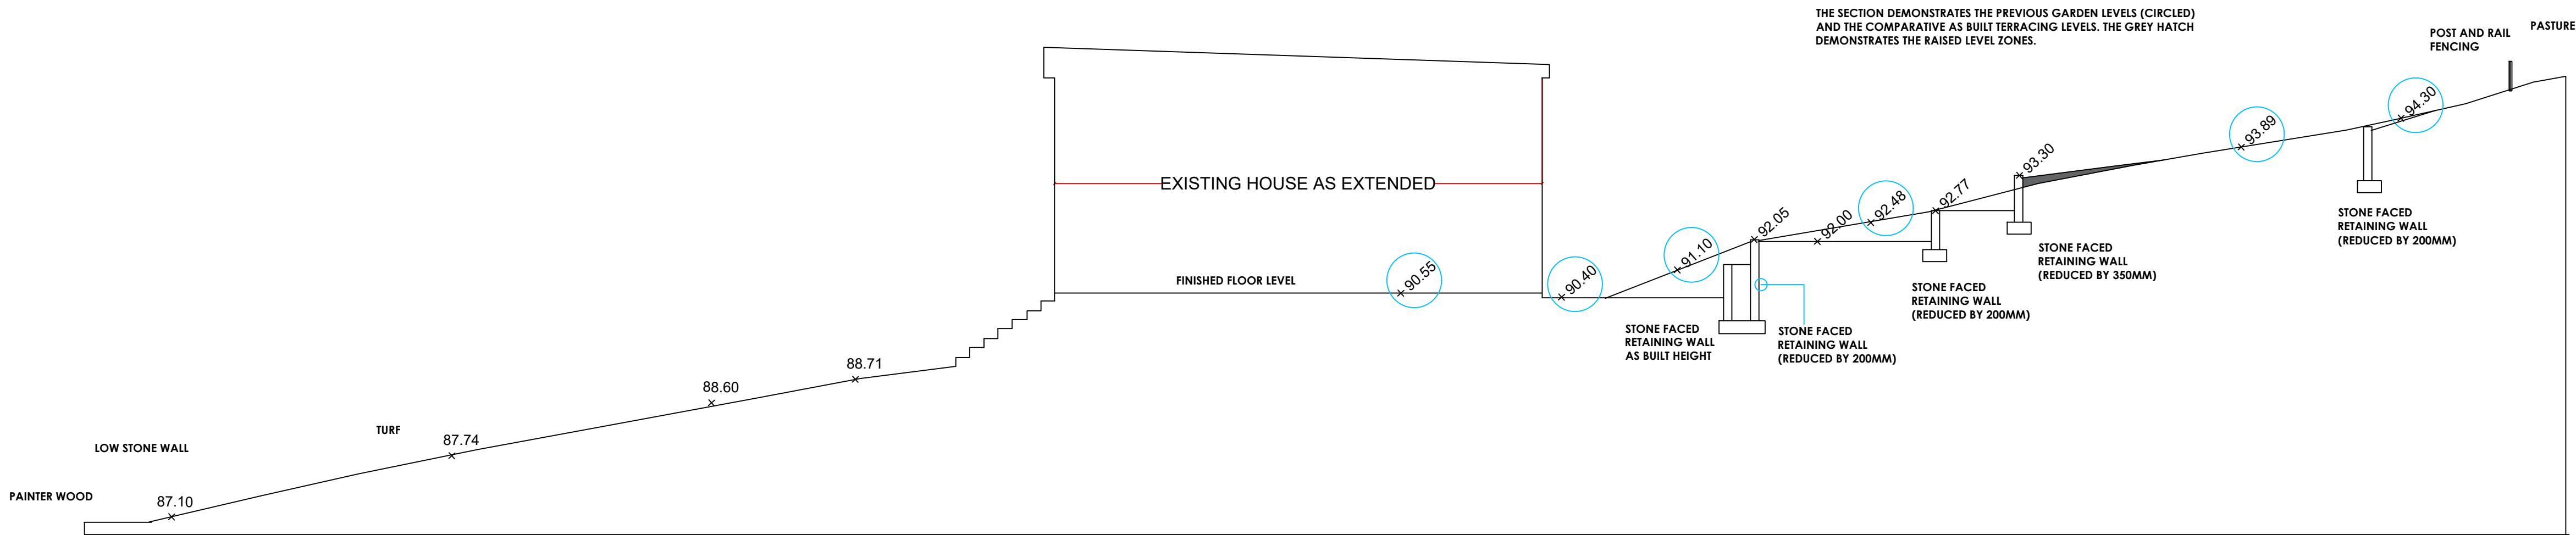

CROSS SECTION B - B

Notes.

REV A – WALL HEIGHTS LAND LEVELS REDUCED AND SUMMER HOUSE REMOVED

notes.

FOR PLANNING APPROVAL (RESUBMISSION)

REFER TO THE EXISTING AND PROPOSED SITE PLANS DEMONSTRATING THE SITE ARRANGEMENT/LANDSCAPING LEVELS AS BUILT IN COMPARISON WITH THE PREVIOUS SITE LEVELS.

REFER ALSO TO THE DESIGN STATEMENT AND SITE PHOTOGRAPHS

Project .

36 PAINTER WOOD
WHALLEY OLD ROAD
BILLINGTON,LANCASHIRE

Client.

TIM STEPHENSON

drawing title:

PROPOSED ALTERED SITE SECTIONS

status.

scale.

1:100

Drawn by:

checked: PH

Date.

8.7.25

project no.

PHA/941

dig no.

200

rev.

A