

- Notes.
- A STONE WALL
 - B 1M HIGH FENCING
 - C 1.8M HIGH CLOSE BOARDED FENCING
 - D 1.2M HIGH CLOSE BOARDED FENCE AND GRAVEL PATH (TO THE BROOK ONLY)

notes.

FOR THE NON MATERIAL AMENDMENT APPLICATION

Project.

PROPOSED CONVERSION AND EXTENSIONS TO THE FORMER CARE HOME
10 KNOWSLEY ROAD
WILPSHIRE

Client.

MR & MRS COUPLAND

Drawing title.

AS BUILT SITE PLAN

Status.

Scale.



1:100 AT A1

Drawn by: PH

Date.

20/08/25

Project no.	PHA/123	Rev.	
Dwg no.	700B	Rev.	

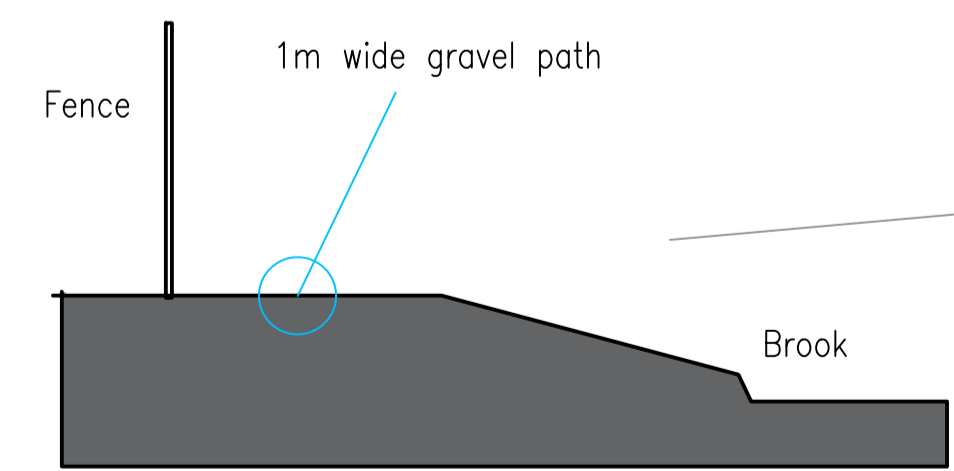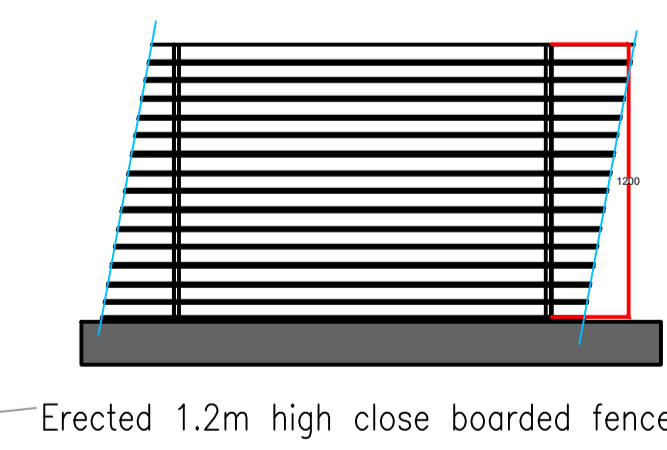

DETAILS OF BOUNDARY CONDITION D