

- Notes
- A STONE WALL
 - B 1M HIGH FENCING
 - C 1.8M HIGH CLOSE BOARDED FENCING
 - D 1.2M HIGH CLOSE BOARDED FENCE AND GRAVEL PATH (TO THE BROOK ONLY)

notes

[Redacted]

Project

PROPOSED CONVERSION AND EXTENSIONS TO THE FORMER CARE HOME
10 KNOWSLEY ROAD
WILPSHIRE

Client

MR & MRS COUPLAND

drawing title

AS BUILT SITE PLAN

Scale

1:100 AT A1

Drawn by

PH

Date



20/08/25

project no.

PHA/123

sig no.

700B

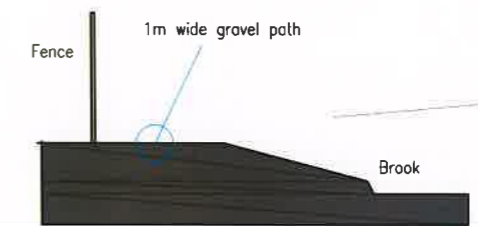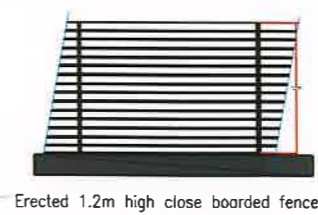

DETAILS OF BOUNDARY CONDITION D