



Blockwork to be finished with white render to match existing below

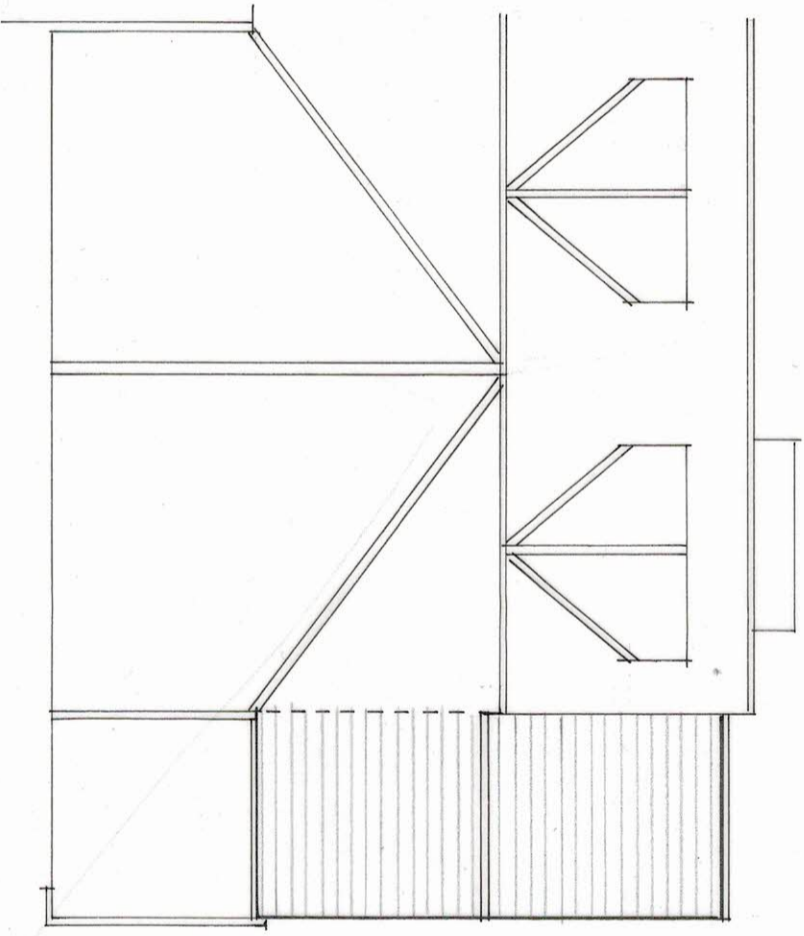


GABLE ELEVATION

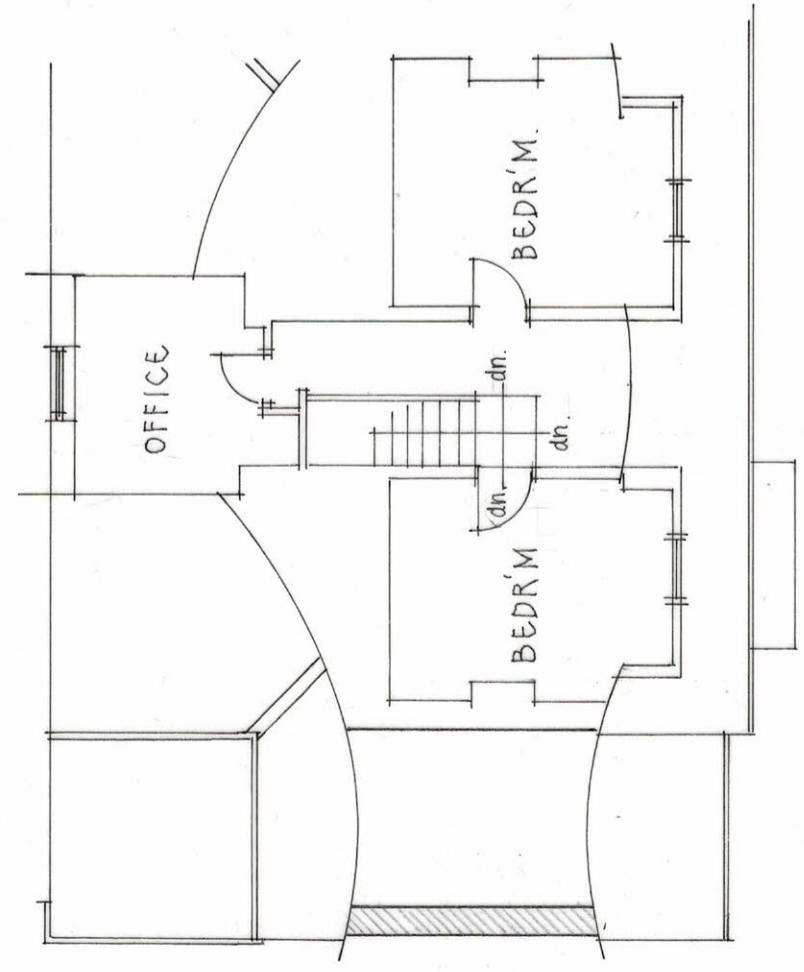


FIRST FLOOR PLAN

Strip off tiles to front roof slope and fix reclaimed Beauvais diamond clay tiles to match existing  
 Blockwork to be finished with white render.

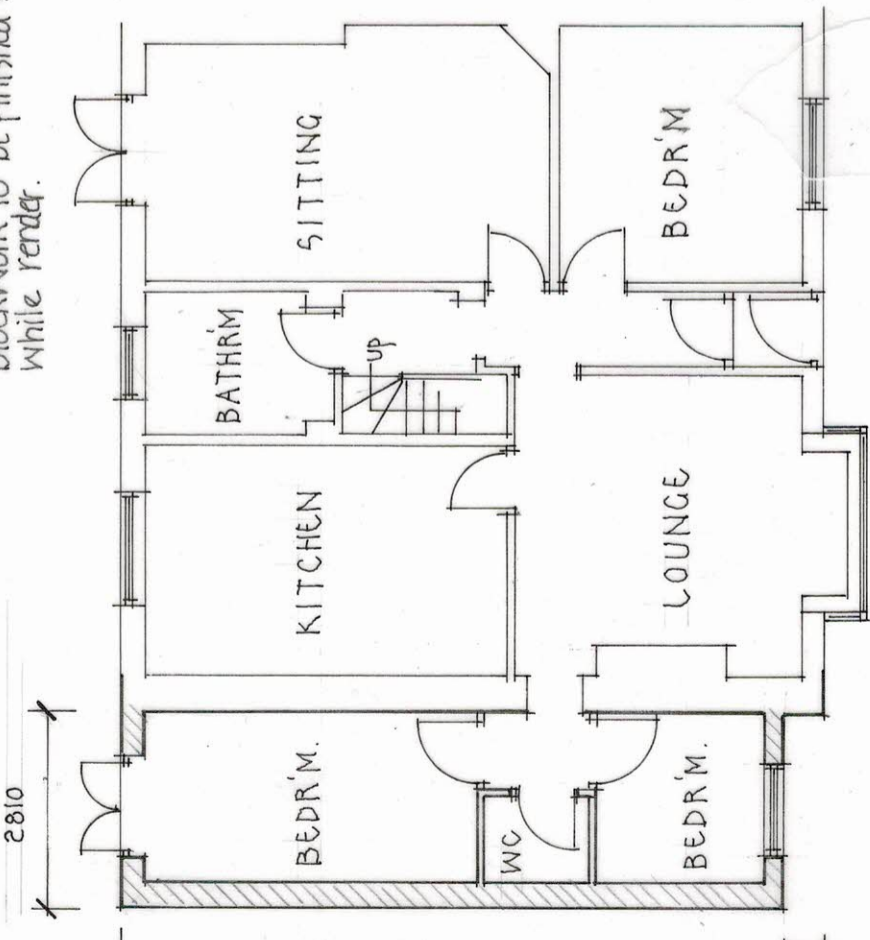


GROUND FLOOR PLAN

ROOF PLAN

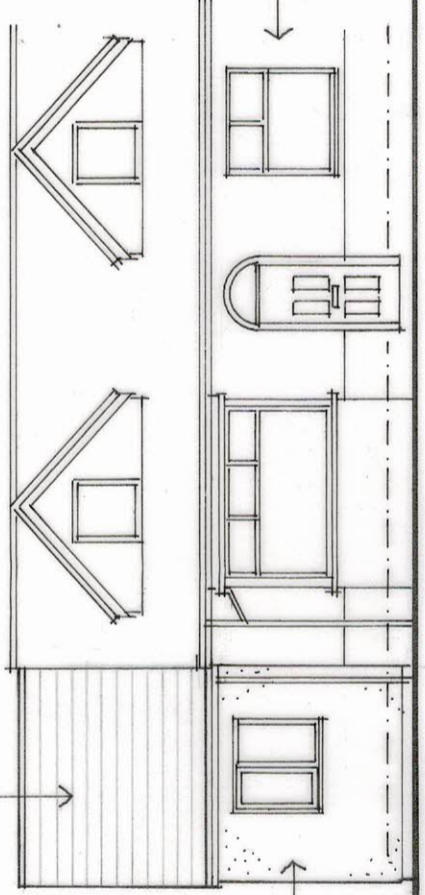


New white render to replace existing.

FRONT ELEVATION

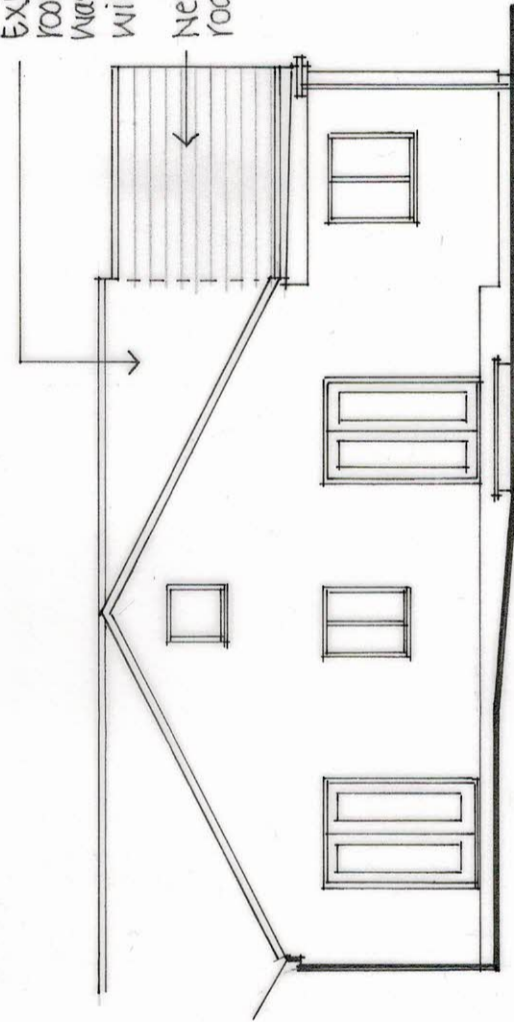

Existing old english flat roof tiles to be power washed to tone in with new tiles.  
 New old english flat roof tiles.

REAR ELEVATION

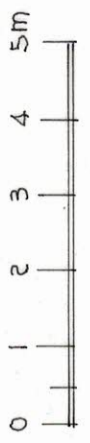

REVISION	DATE	DR	CH
<b>Architectural Design Partnership</b> Kirksyde 9 Castle Road Colne Lancashire BB8 7AR Tel: 01282 861876			
PROJECT RETROSPECTIVE APPLICATION FOR SINGLE STOREY SIDE EXTENSION AT 26 WHALLEY ROAD LANGHO			
DRAWING TITLE			
AS BUILT PLANS AND ELEVATIONS WITH PROPOSED MINOR MATERIAL ALTERATIONS			
<small>THIS DRAWING IS COPYRIGHT                  THIS DRAWING IS NOT TO BE SCALED                  ALL DIMENSIONS TO BE CHECKED ON SITE                  ANY DISCREPANCY OR OMISSION OF WORK                  APP TO BE NOTIFIED OF ANY ERRORS</small>			
DRAWN	K J NOLAN	DATE	OCT 2025
CHECKED		SCALE	1:100 @ A3
DRAWING NO			<b>740/2A</b>