




West Elevation
1:100 Scale

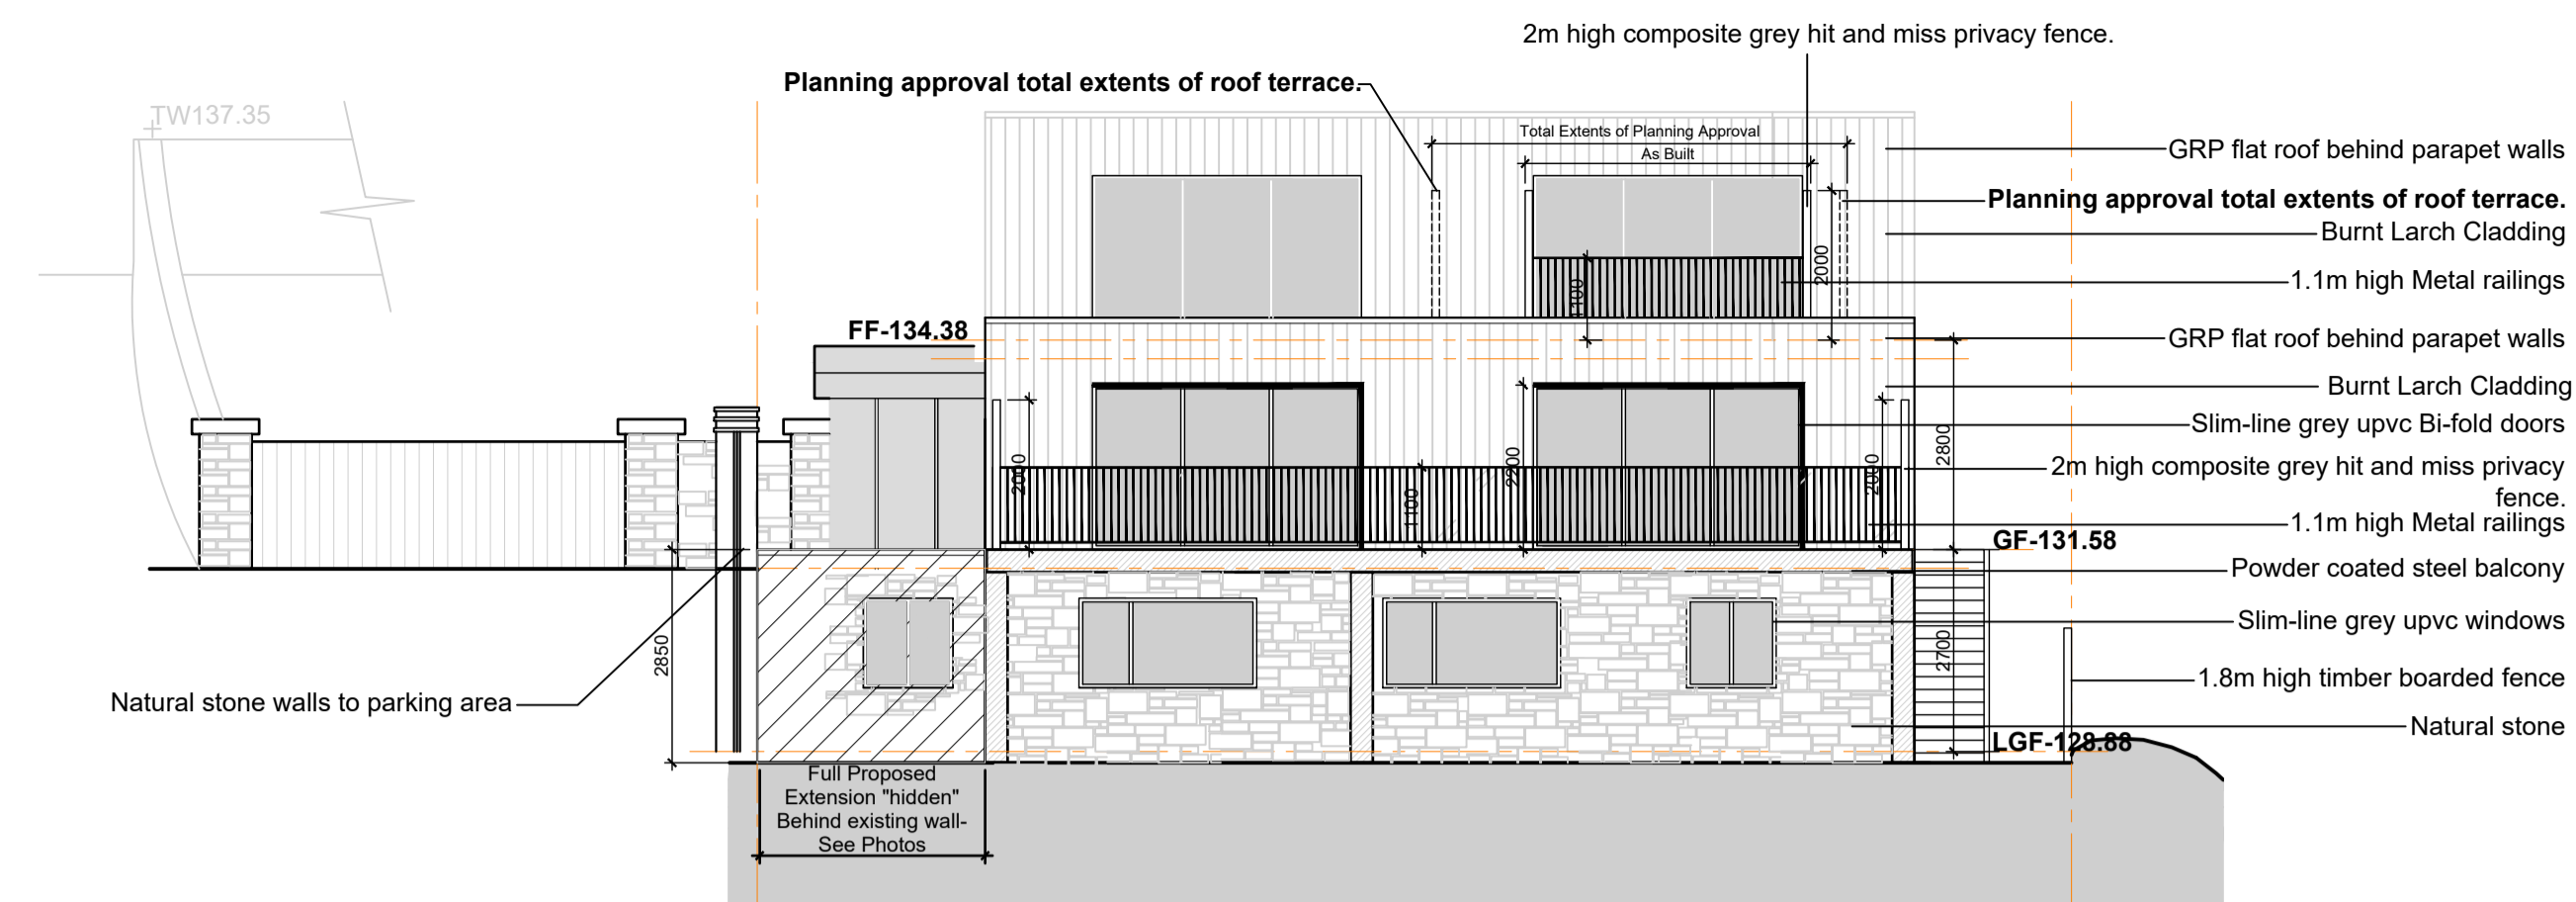


South Elevation
1:100 Scale

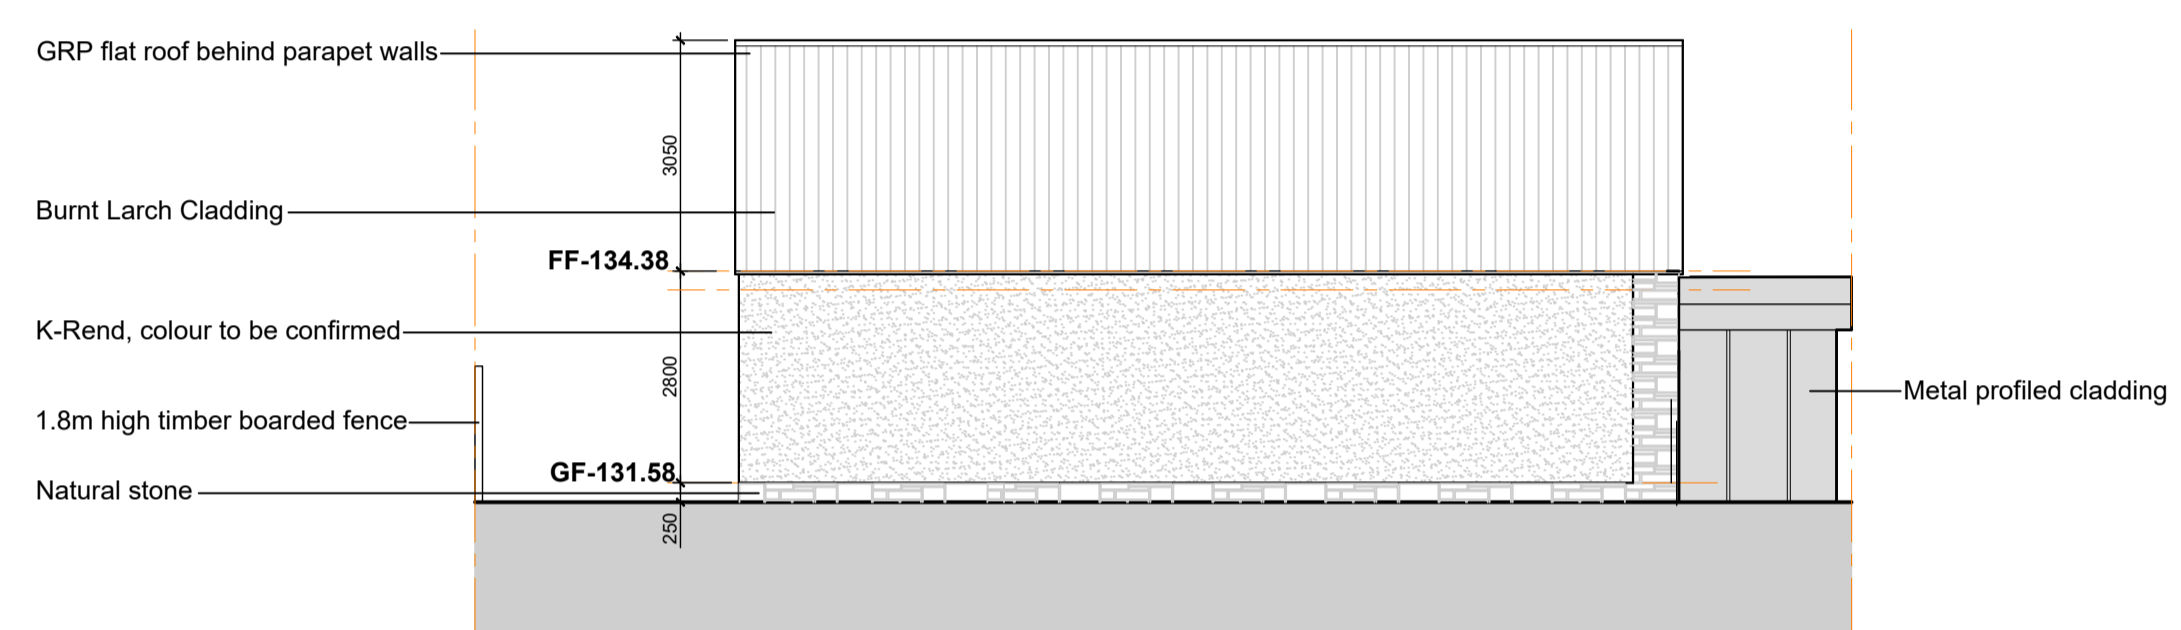



North Elevation
1:100 Scale

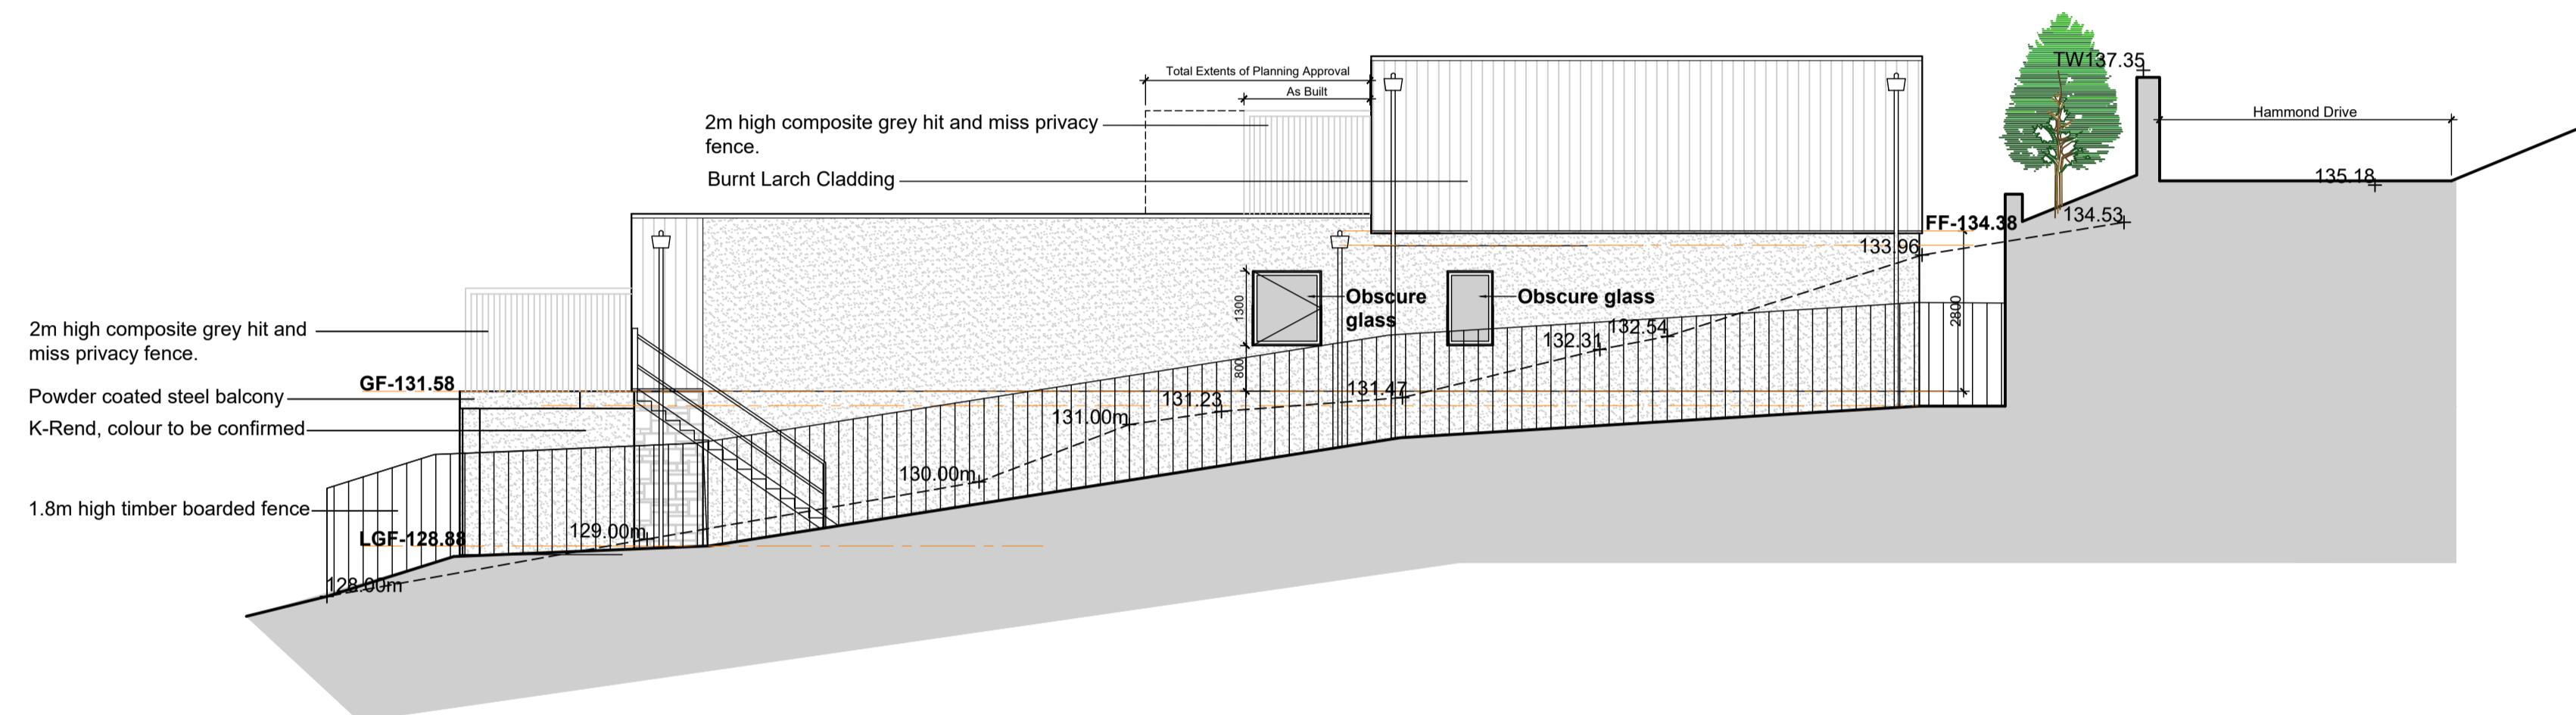


East Elevation
1:100 Scale

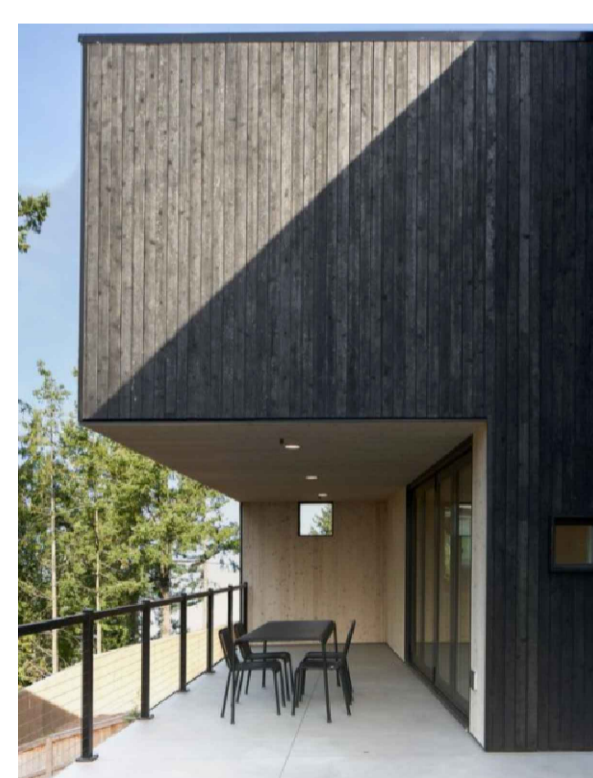

Burnt Larch Cladding

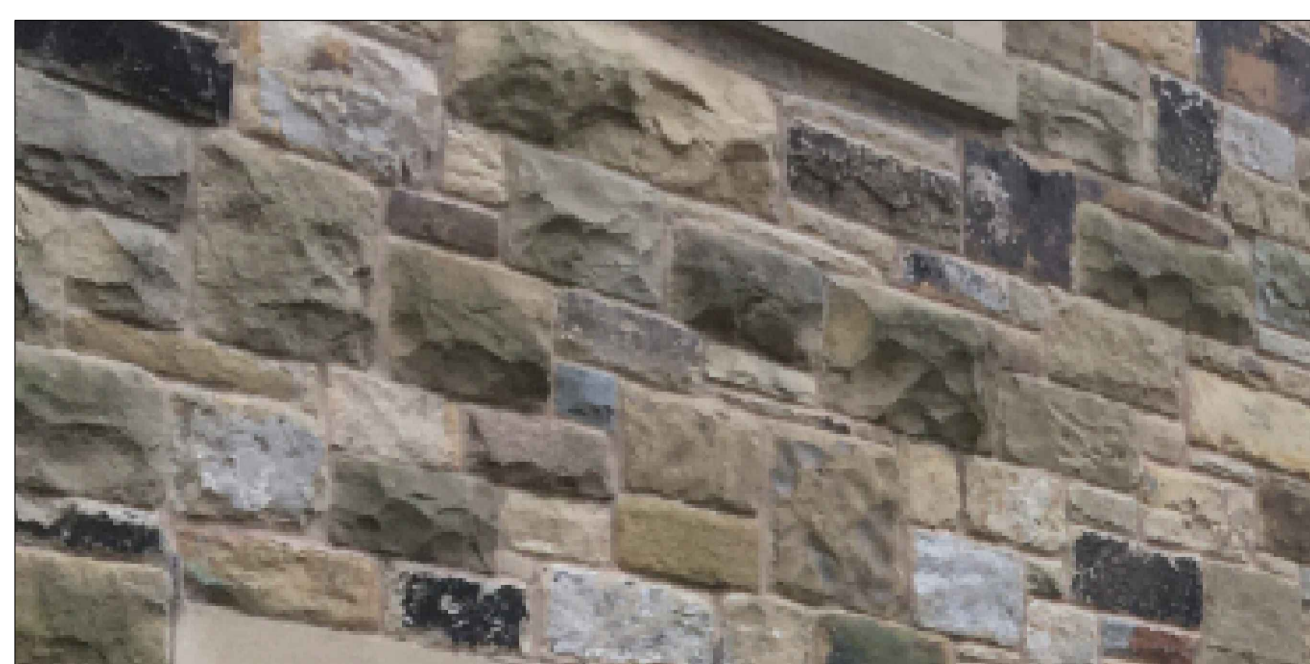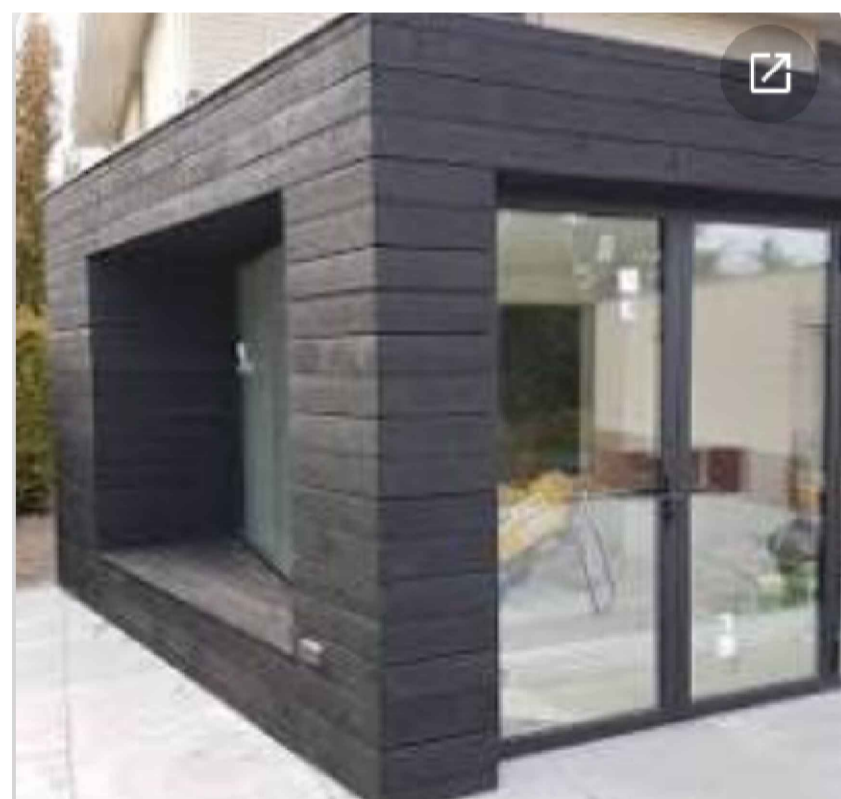

Natural stone

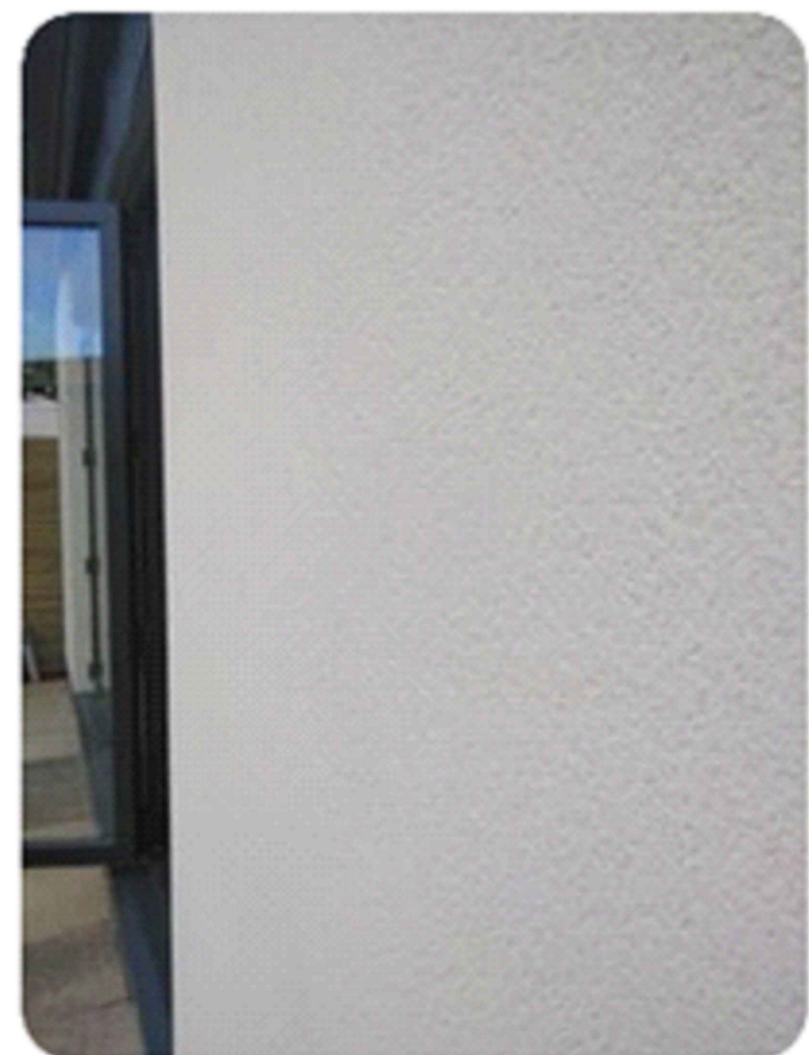

K-Rend Scraped Finish Render



Wall cladding: Catnic - SSR2 Standing Seam Cladding - To Entrance Canopy, steel colour coated (colour tbc).



Polyroof GRP Flat Roof - Colour Dark Battleship Grey

Rev I: Updated to As Built (in progress), 08.12.2025. Craig Harrison

Client
Mr John Houston

Job Title
Proposed Alterations to 8 Hammond Drive Read

Drawing Title
Proposed Elevations

Scale
1:100 @ A1

Date
March 2021

Drawn
Craig Harrison

spa
SUNDERLAND PEACOCK ARCHITECTS
SUNDERLAND PEACOCK & ASSOCIATES LTD.
HAZELMERE, PEARLICO ROAD, CLITHEROE
LANCASHIRE, BB7 2AG
T 01200 423178 F 01200 427328
E info@sunderlandpeacock.com
www.sunderlandpeacock.com

6219 - P011