




2 Front Elevation
1 : 50

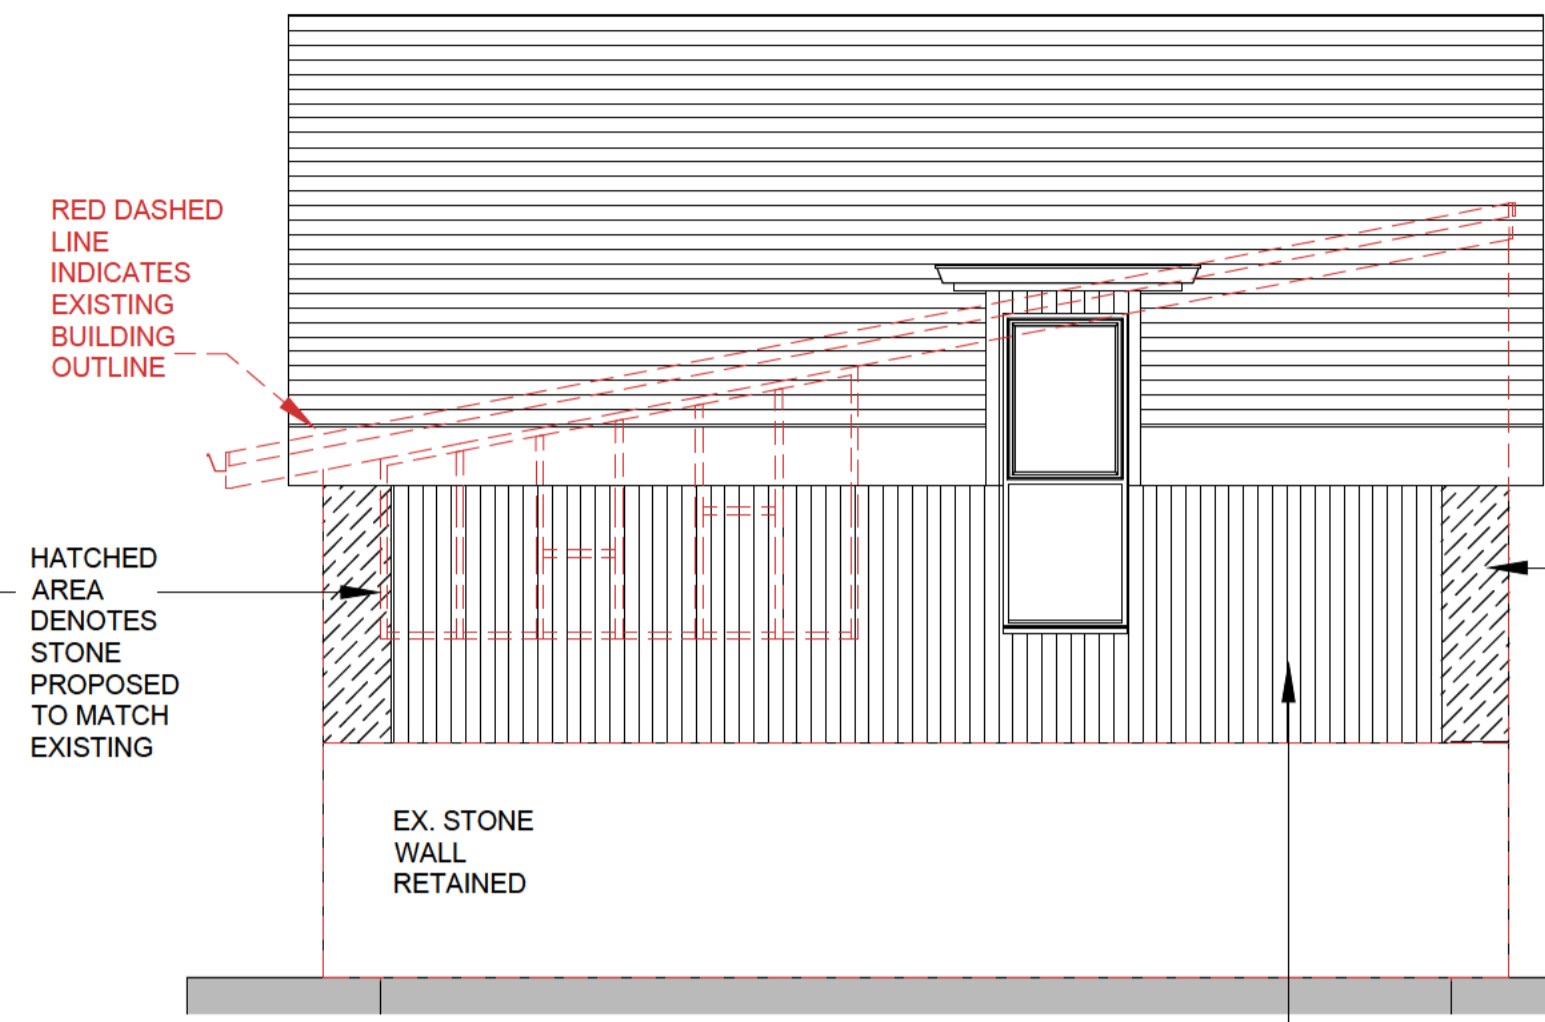


3 Side Elevation
1 : 50

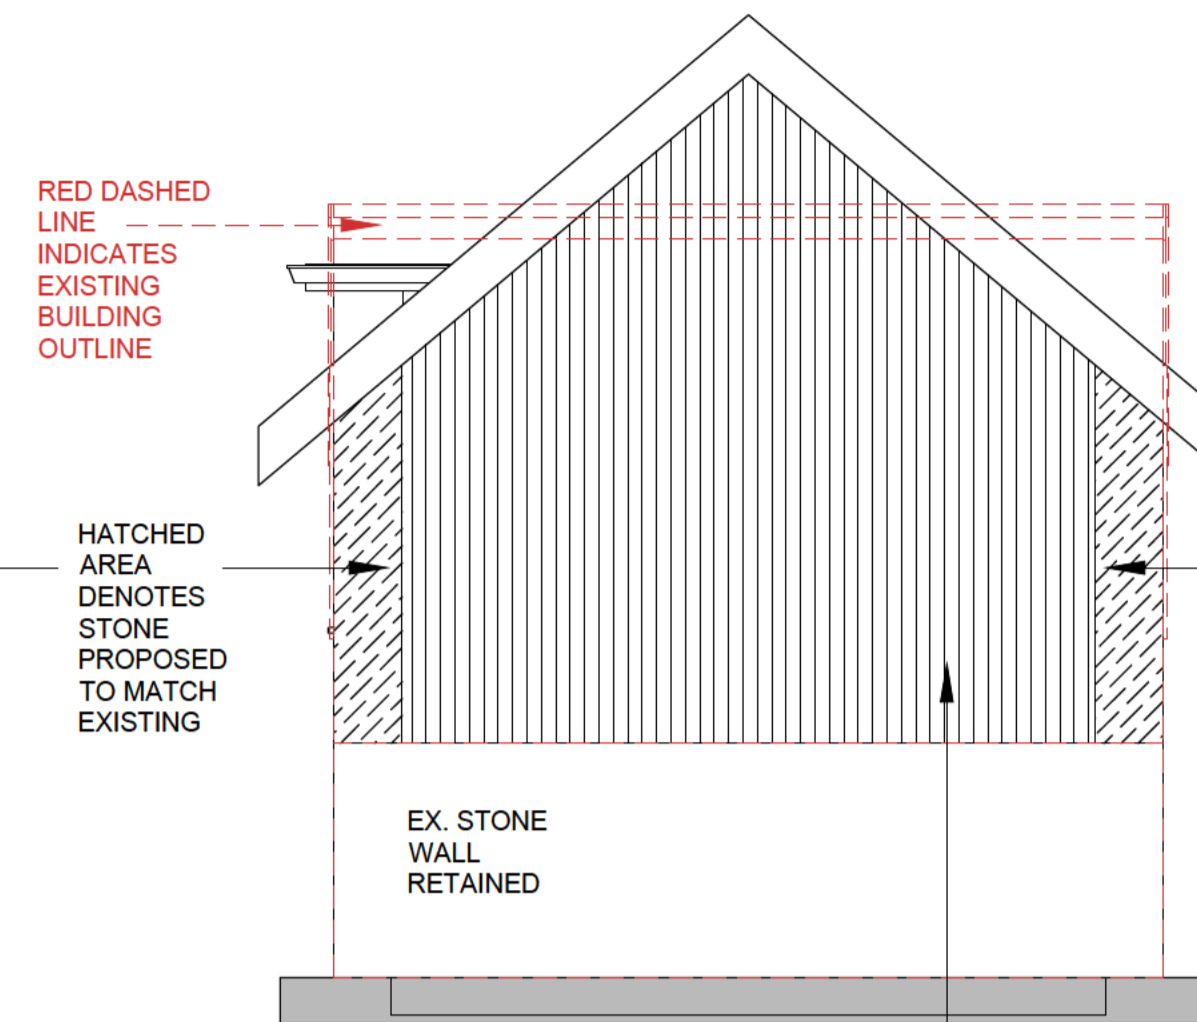


4 Rear Elevation
1 : 50

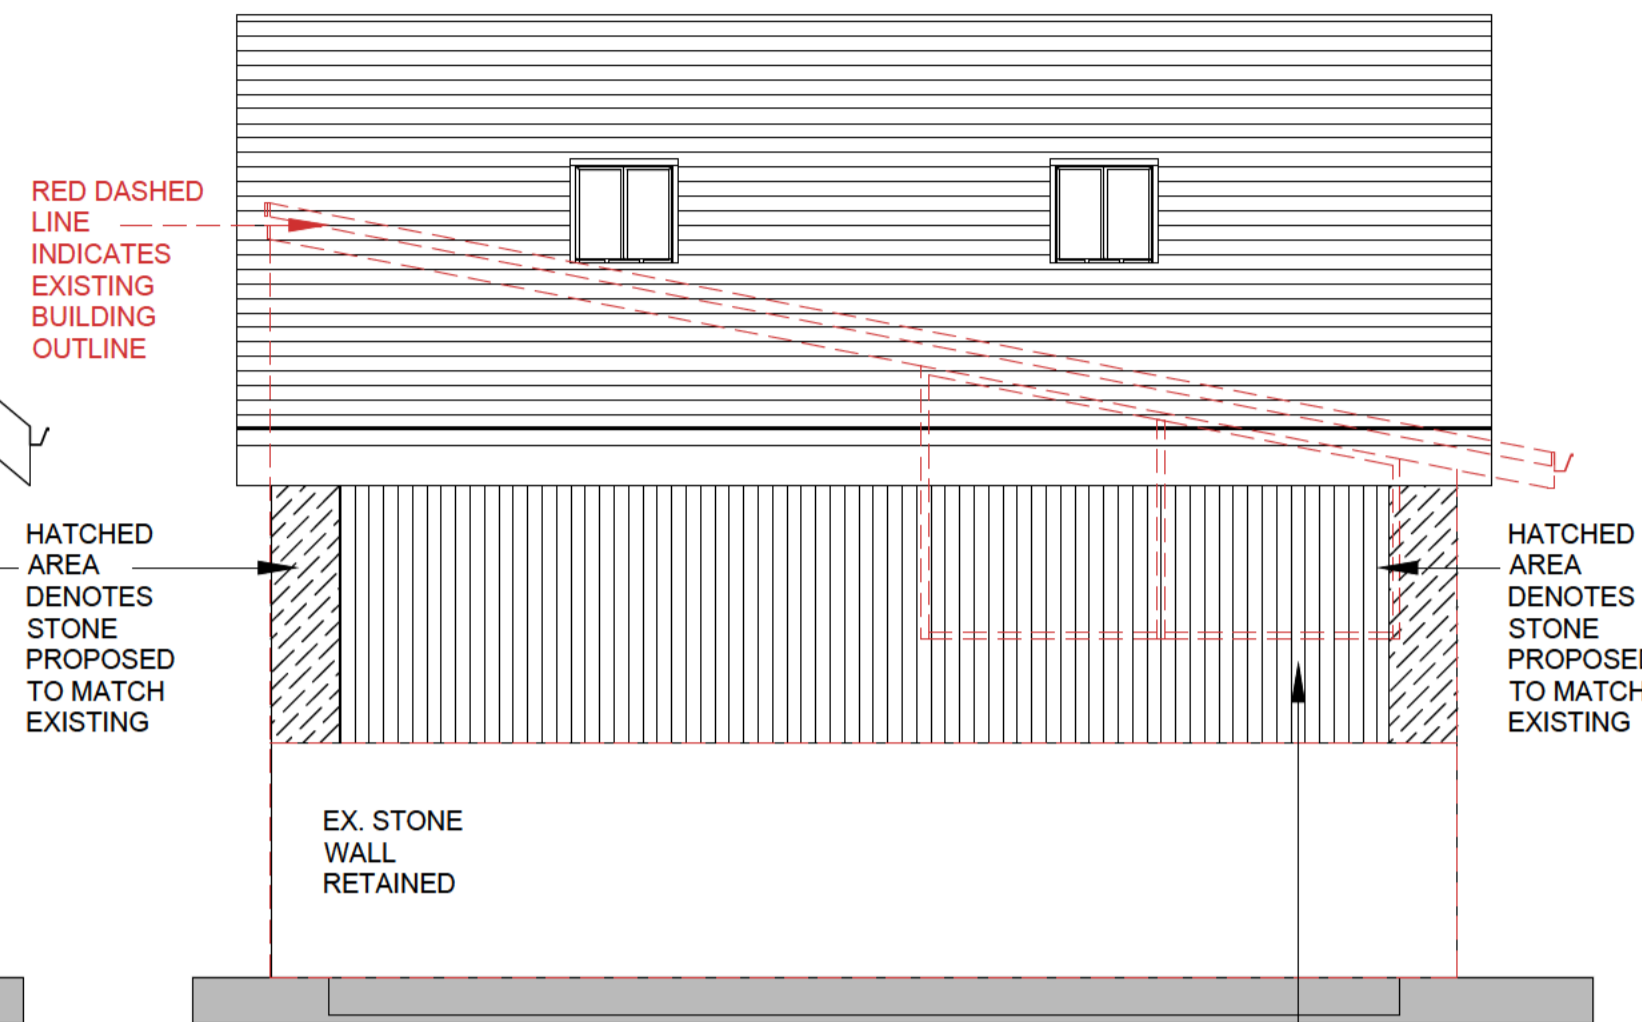


5 Side Elevation 2
1 : 50

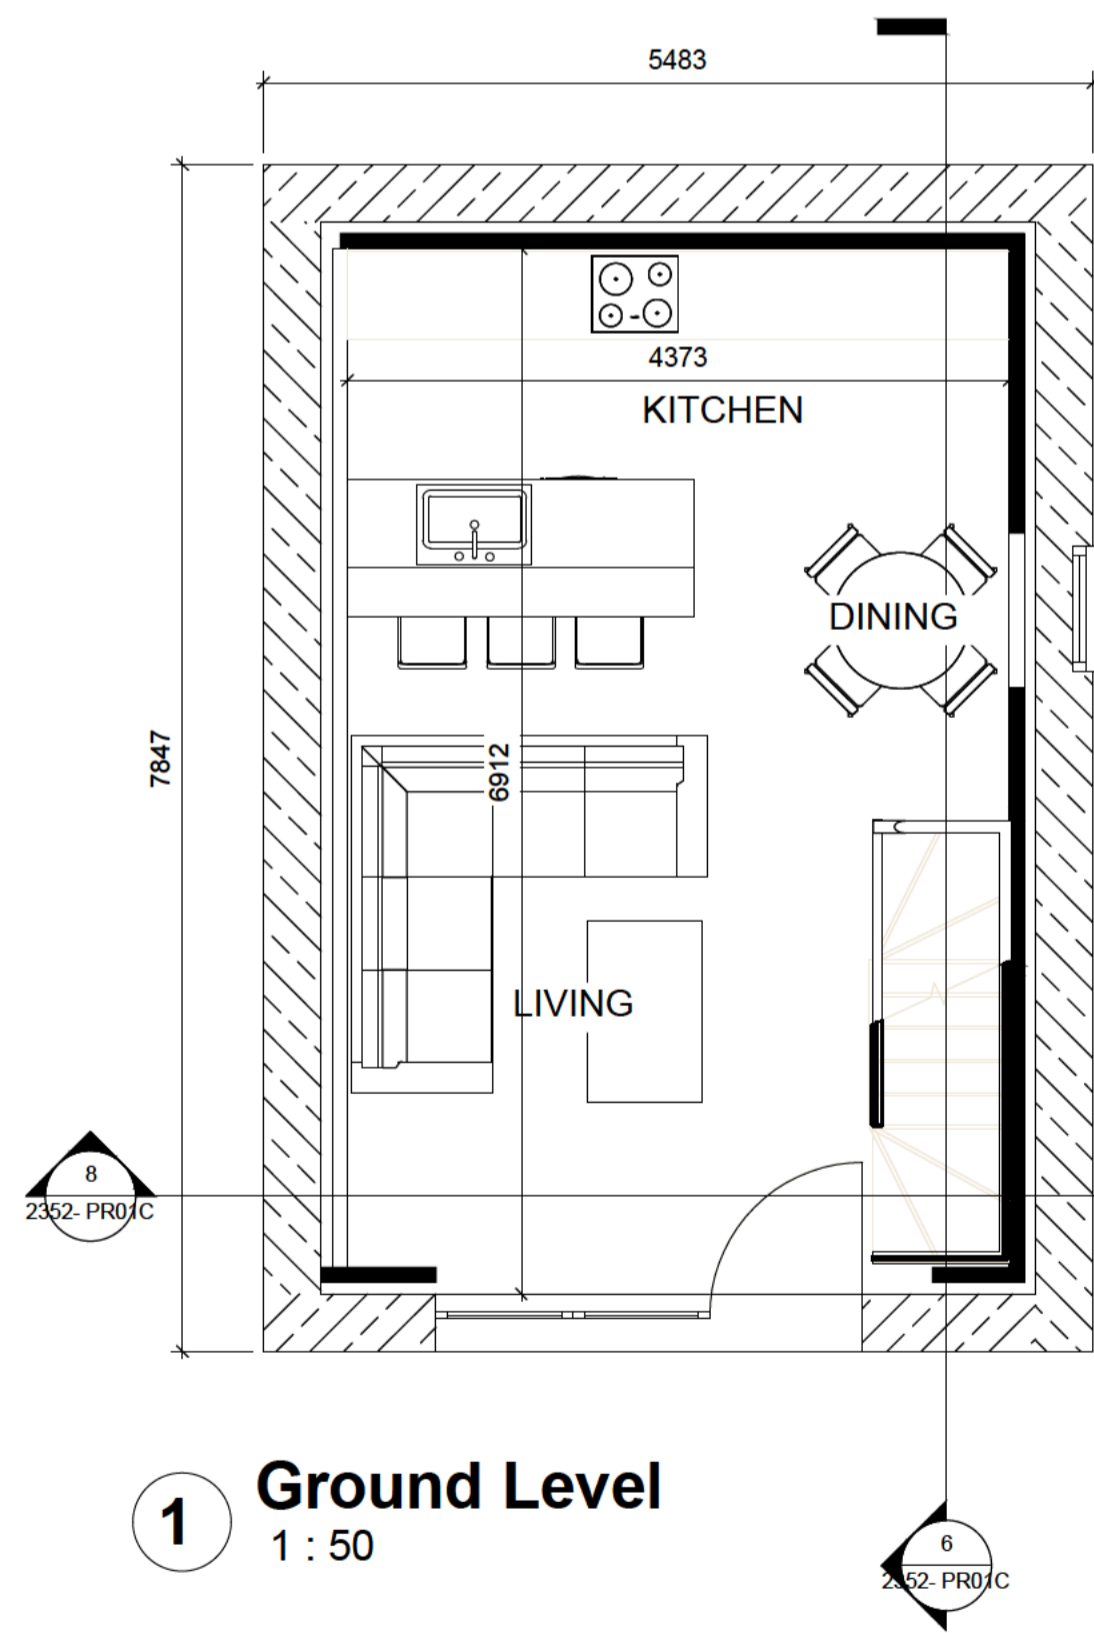


1 Ground Level
1 : 50

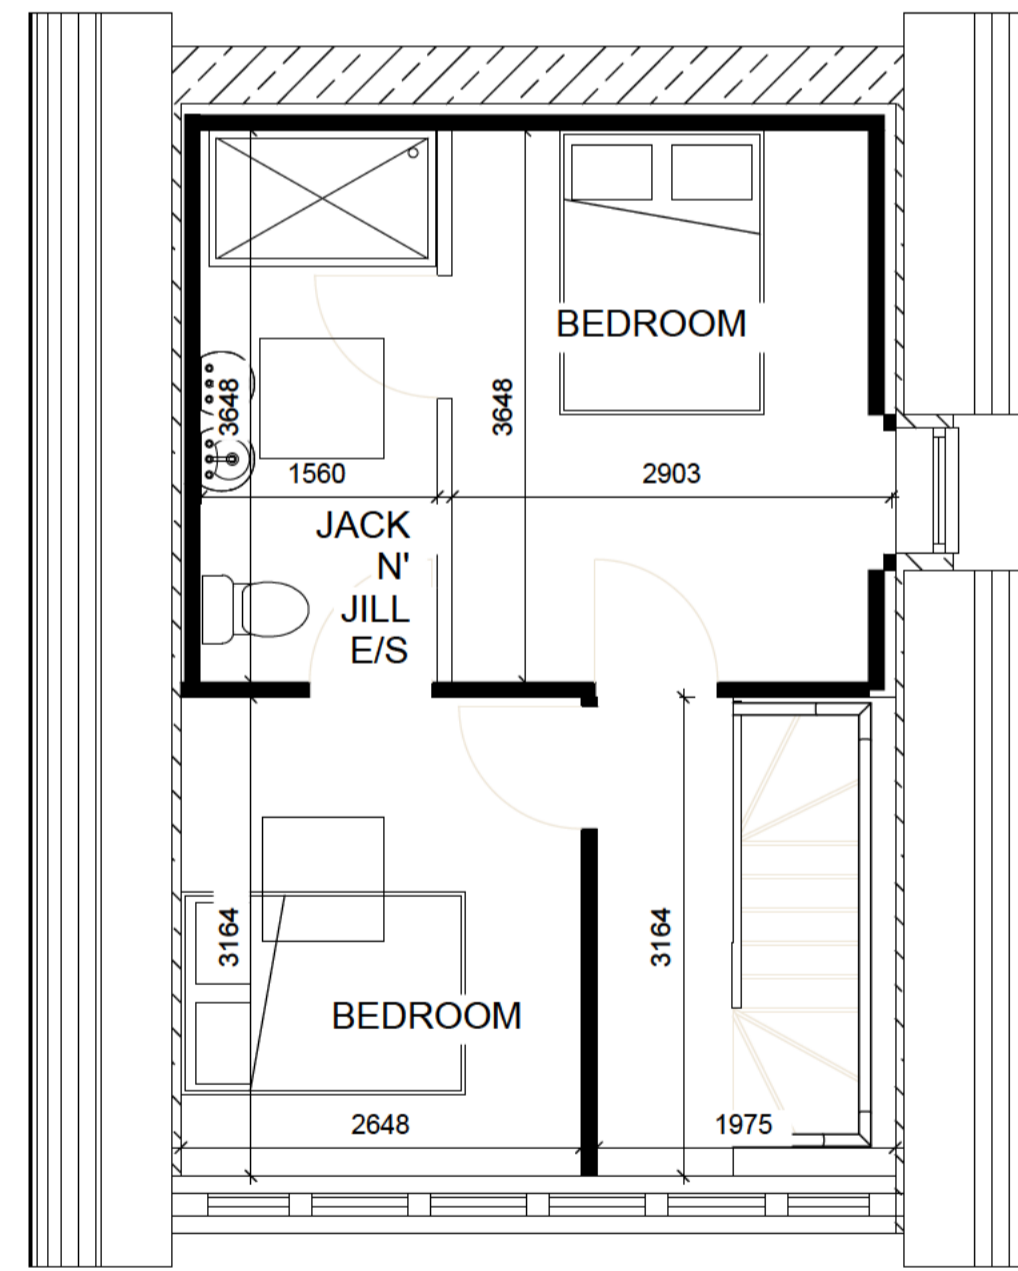

7 Mezzanine Level
1 : 50

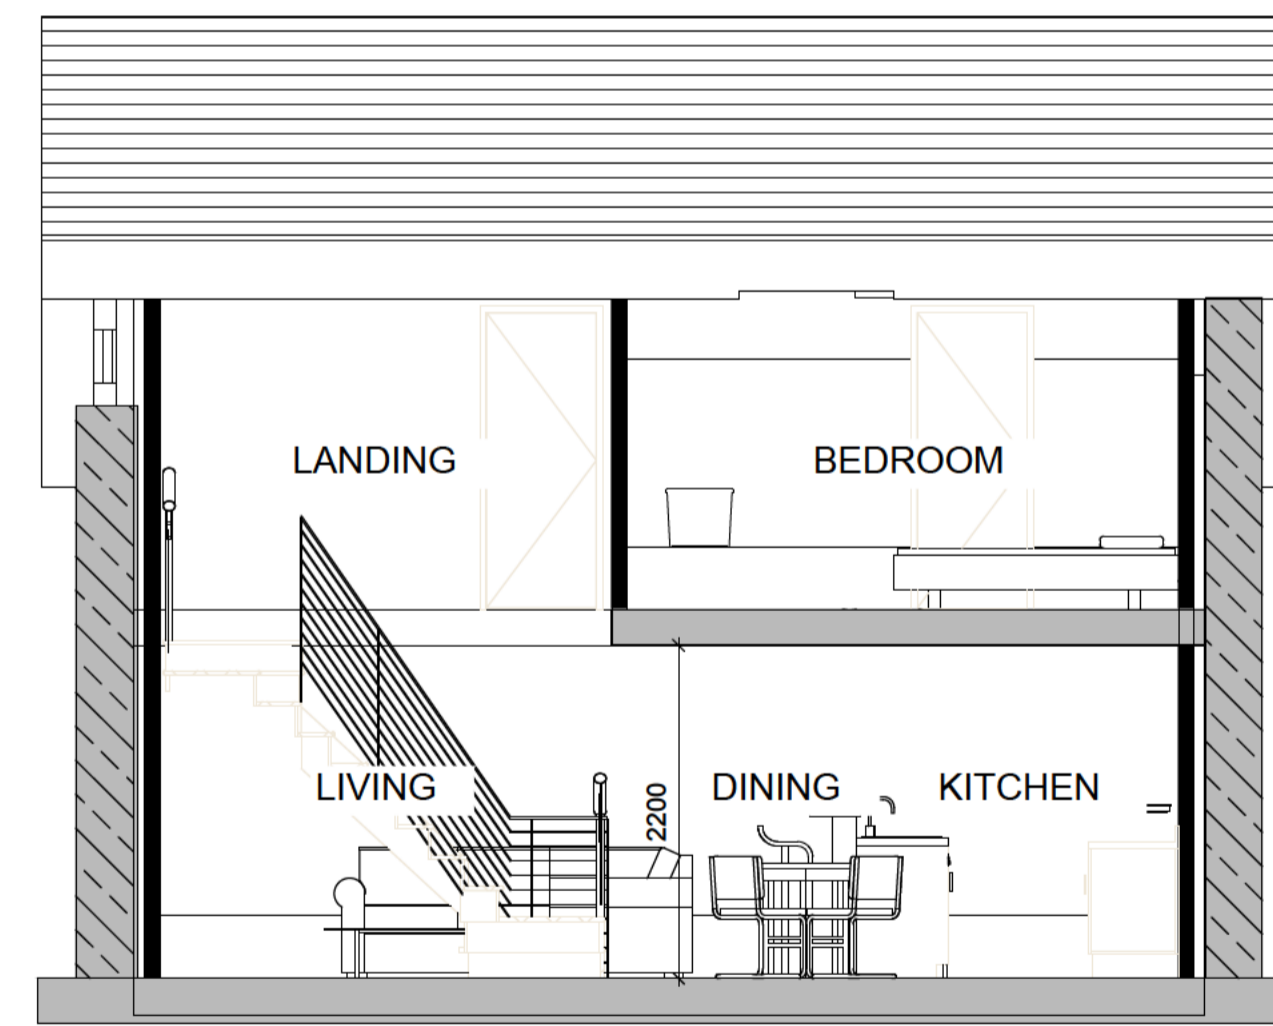

6 Section 1
1 : 50

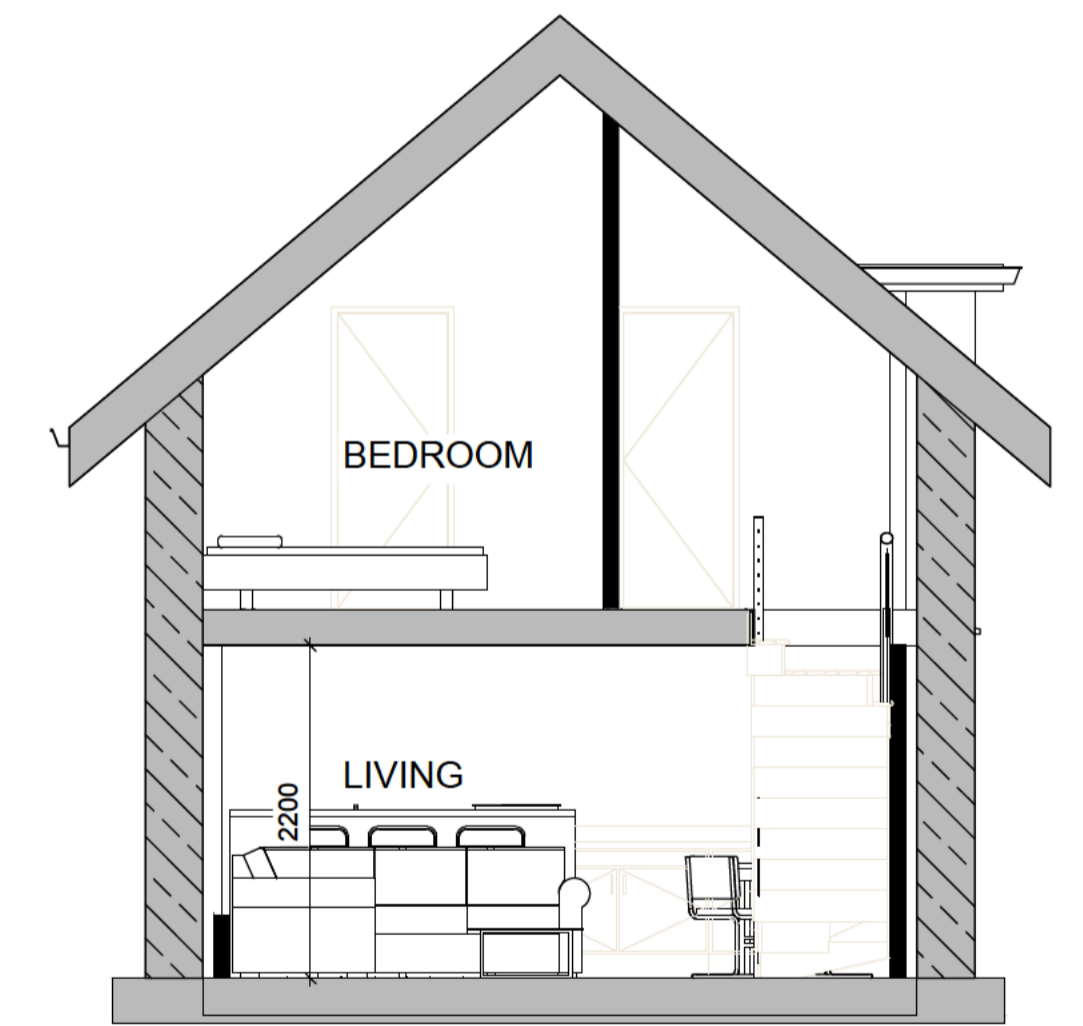

8 Section 2
1 : 50

PRELIMINARY

PLANNING

FOR CONSTRUCTION

FINAL/AS BUILT

Project	[REDACTED]	Client	Roger Hindle Financial Services Ltd
Drg title	EXTENT OF DEMOLITION PLAN	drawing number	2352- PR02
date	05/12/23	scale	A1 @ 1:50

Notes:
1. THIS DRAWING IS SUBJECT TO COPYRIGHT AND IS NOT TO BE REPRODUCED IN PART OR WHOLE WITHOUT APPROVAL

