
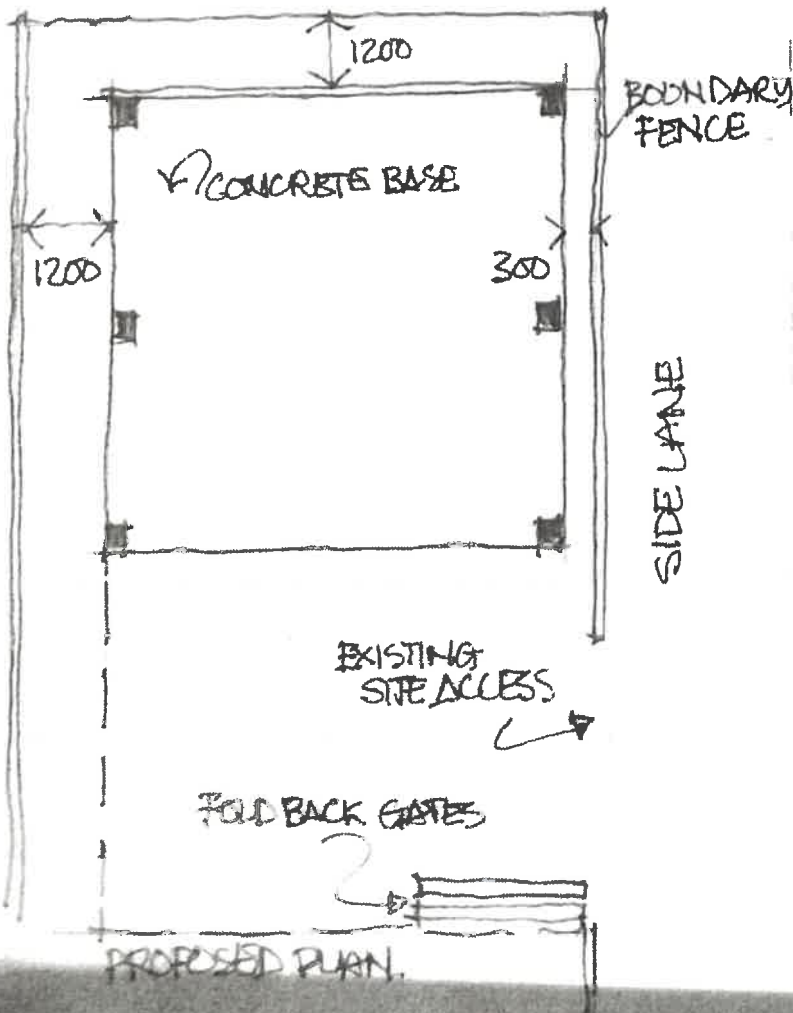
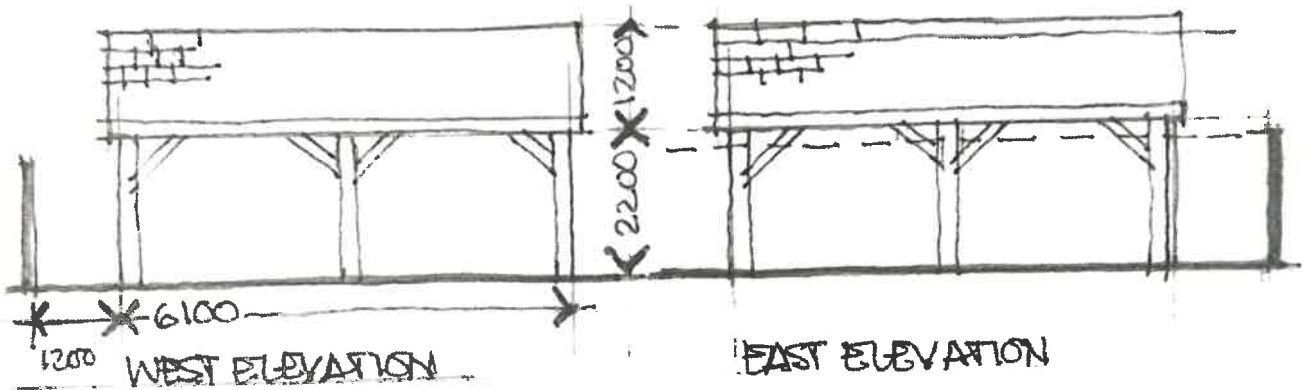


CONSTRUCTION NOTES

TILED ROOF

250x250 TIMBER STRUCTURE

HORIZONTAL TIMBER BOARDING  
TO NORTH + SOUTH ELEVATIONS.

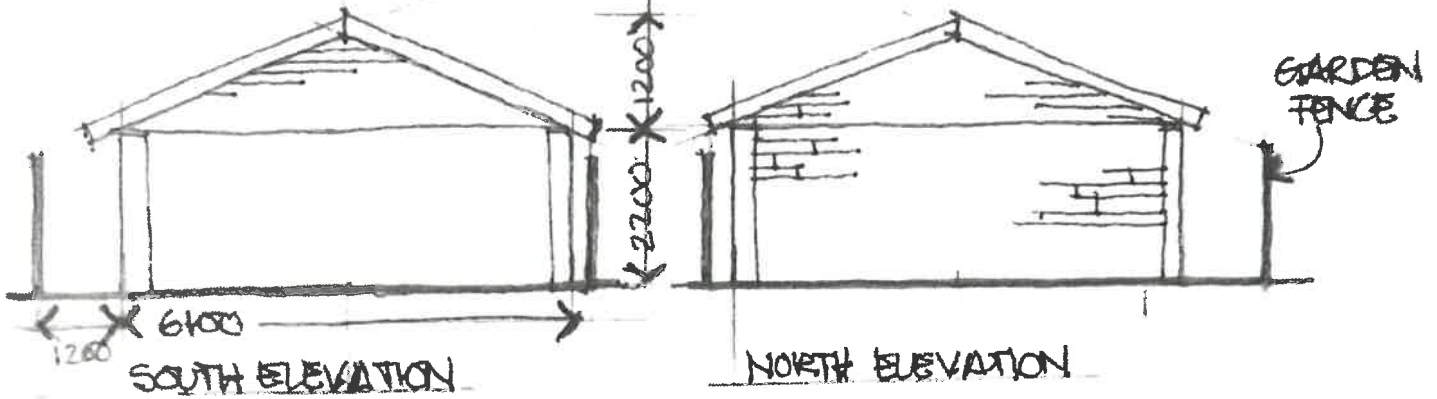

PROPOSED PLAN AND ELEVATIONS  
NEW TIMBER FRAMED GARAGE  
NO 2 GEORGE ST, WHARFUM  
MR + MRS. M. GIBSON  
SCALE 1:100 @ A4.