


GEORGE ST

AS EXISTING SITE PLAN
(PRE DEVELOPMENT)

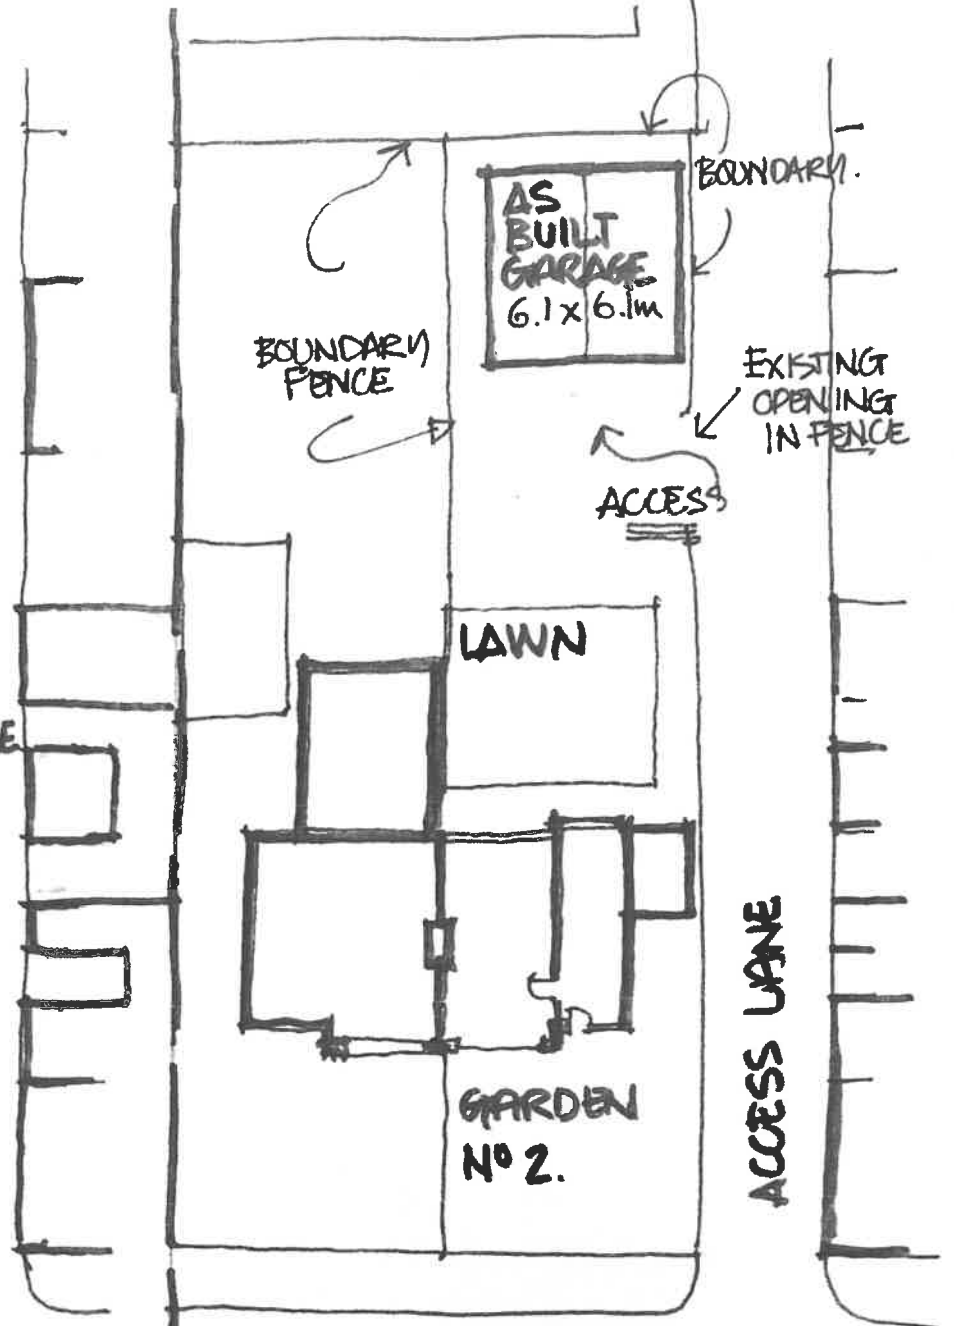

GEORGE ST

AS PROPOSED SITE PLAN.
(AS BUILT)

PRE CONSTRUCTION + AS BUILT
SITE PLAN.

NO 2 GEORGE ST WHALLEY
MR + MRS M. GIBSON
SCALE 1:200 @ A4.

DRG NO 02.