

Stanton Andrews do not accept liability for any loss or degradation of information held in the drawing resulting from the translation from the original file format to any other file format or from the recipient's reading of it in any other programme or on an earlier version of the programme. Stanton Andrews accepts no liability for use of this drawing by parties other than the party for whom it was prepared or for purposes other than those for which it was prepared.

This drawing must be printed in colour, if this text is not RED the drawing must be reprinted.



Do not scale, use figured dimensions only. All dimensions to be checked on site. This drawing should be printed and read at the original size, as stated in this block. Stanton Andrews accept no responsibility for errors that occur as a result of reviewing this drawing at any other size. Stanton Andrews to be notified of any discrepancies before proceeding.

DWG issues - when this drawing is issued in DWG format it is an uncontrolled version and is provided to enable the recipient to prepare its own documents/drawings for which it is solely responsible. It is based on background information current at the time of issue. Stanton Andrews accepts no liability for any alterations to, additions to or discrepancies arising out of changes to such background information which occur after it has been issued by Stanton Andrews.


As existing' drawings based on information provided by others - no measured survey of the property has been undertaken by the architect. This drawing is subject to copyright.

Drawing is to be read in conjunction with all relevant consultants and specialists drawings.


revision	date	note
A	07.05.2026	issued for planning following additional survey work

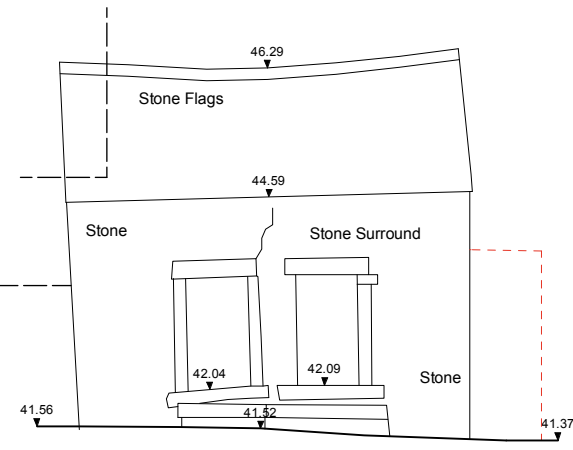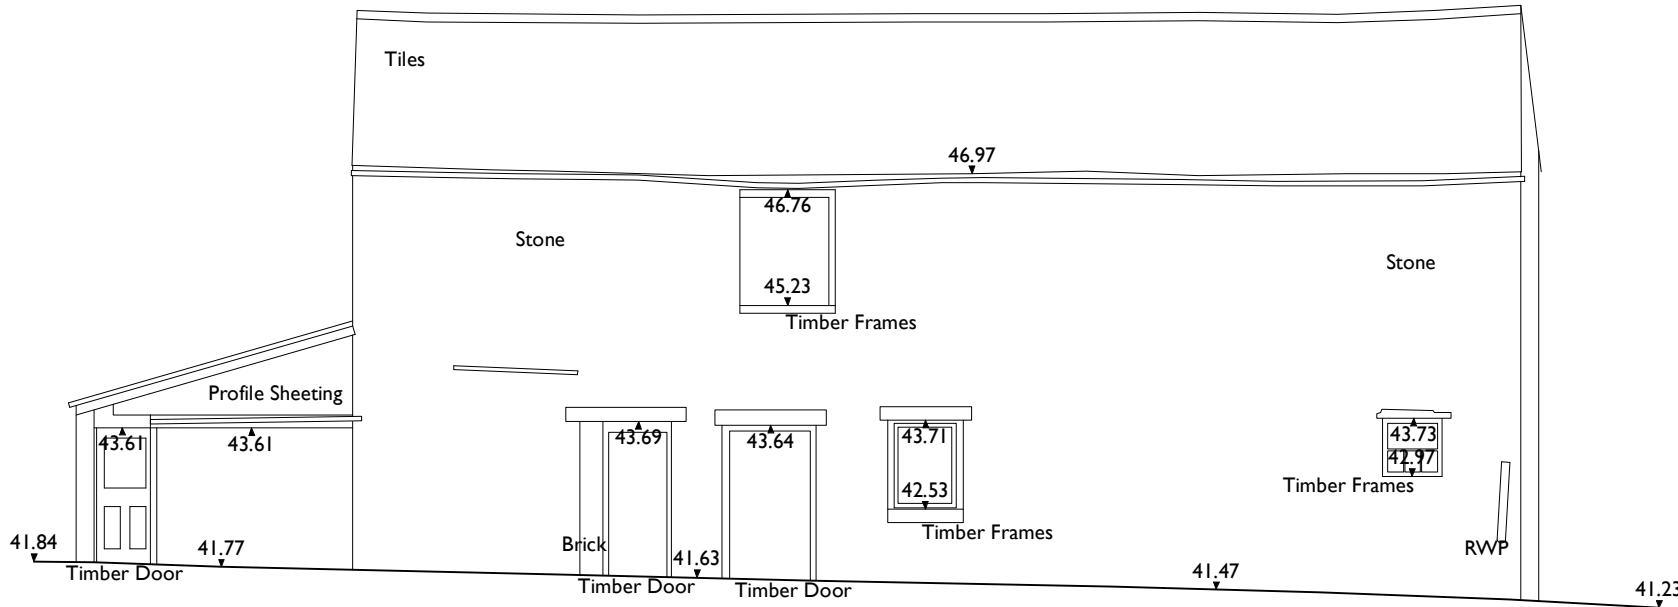

1 Barn 2 - South Elevation
Scale: 1:100

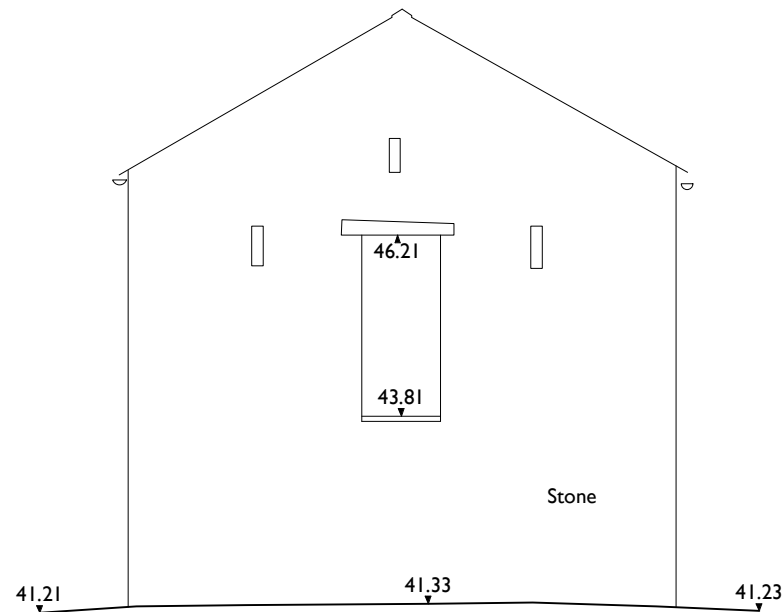


5 Barn 3 - South Elevation
Scale: 1:100

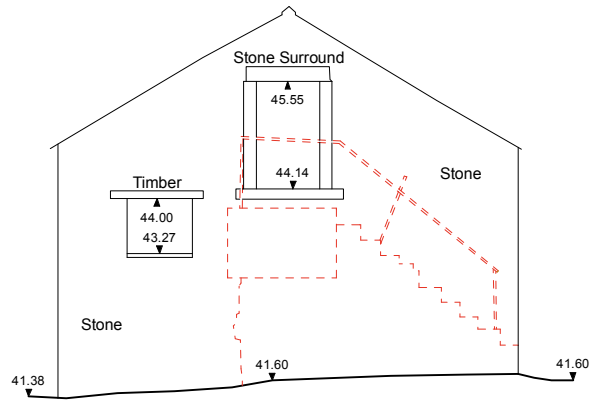


broken red lines to barn 3 elevations indicate original external stair that has been damaged and removed on safety grounds since initial submission in Feb 2026. existing stone stored on site and subject to further discussions with LPA regarding re-instatement/re-use as part of proposals.


2 Barn 2 - East Elevation
Scale: 1:100

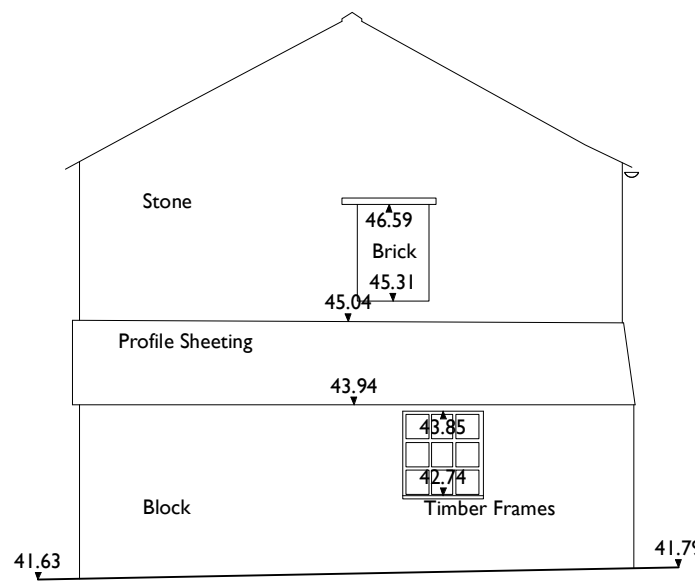


6 Barn 3 - East Elevation
Scale: 1:100

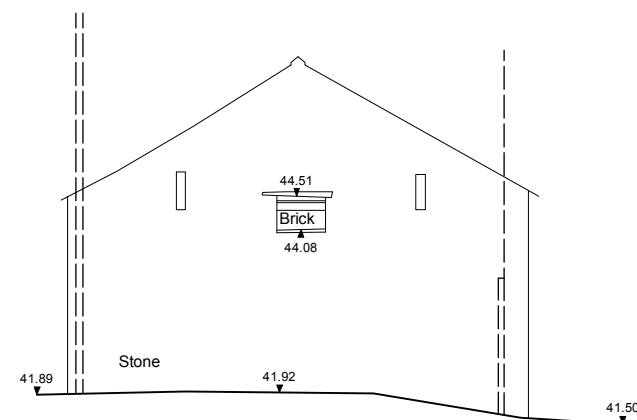

3 Barn 2 - West Elevation
Scale: 1:100

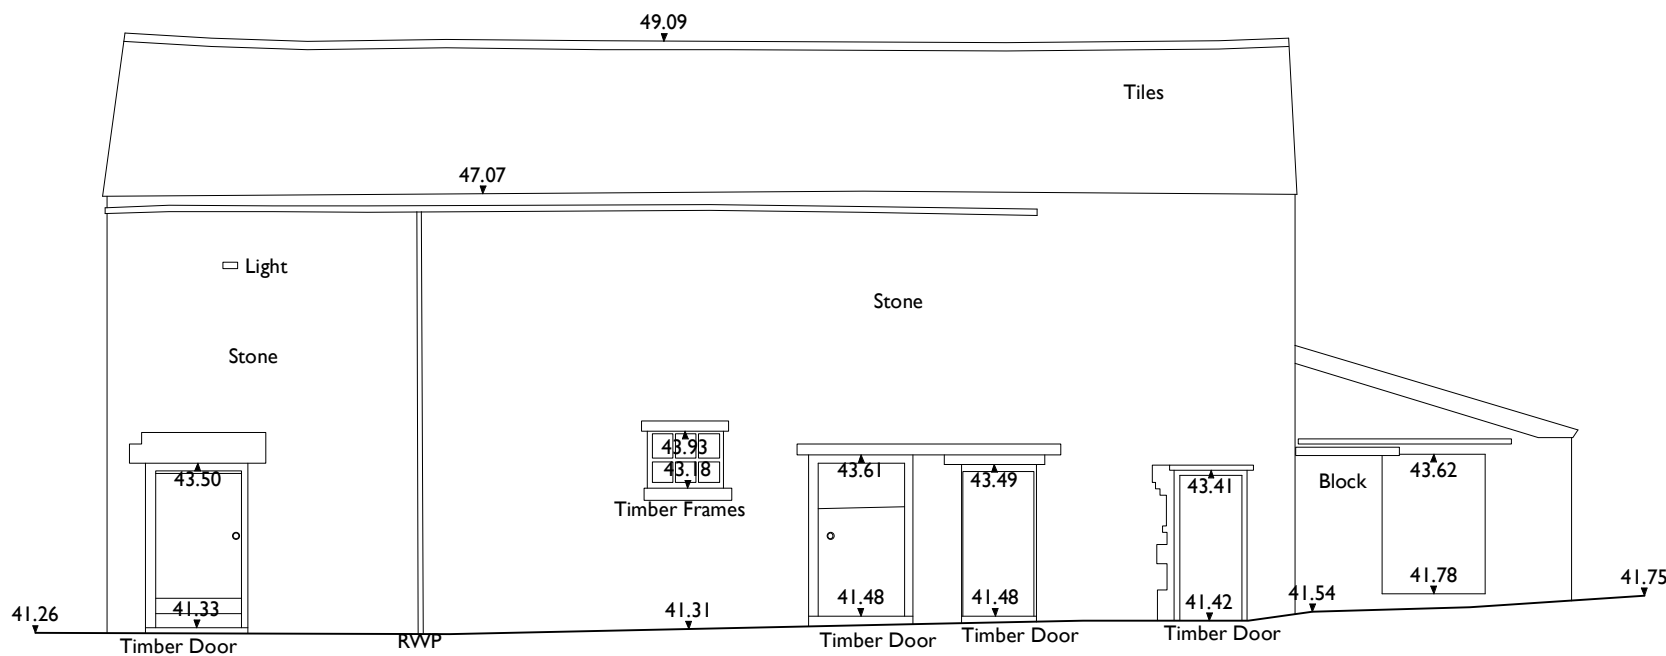

7 Barn 3 - West Elevation
Scale: 1:100

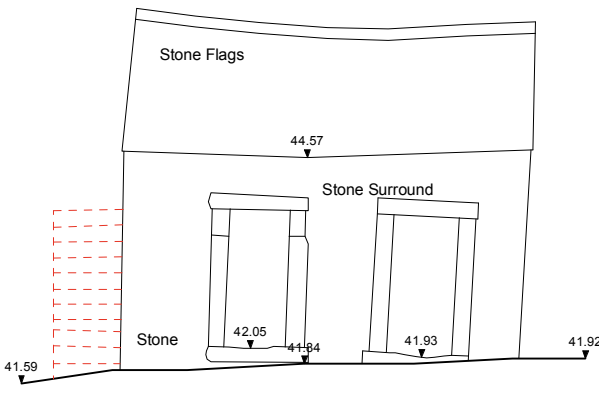

4 Barn 2 - North Elevation
Scale: 1:100

8 Barn 3 - North Elevation
Scale: 1:100

