

Marathon House
The Sidings Business Park
Whalley, BB7 9SE

01254 823 885

www.peterhitchenarchitects.co.uk

NOTES:
For Planning approval only.

No.	Description	Date

CLIENT: Orrells Coach Hire

For the Former Waste
Recycling Centre Langho,
BB5 8AB

PROJECT: The use of existing site as
a coach yard

SHEET: Proposed Floor plans and
Elevations

Project number PHA/1046

Date 15/09/2025

Drawn by LM


Checked by PH

A3.3

Scale 1 : 50

Sheet size A1

NORTH ELEVATION

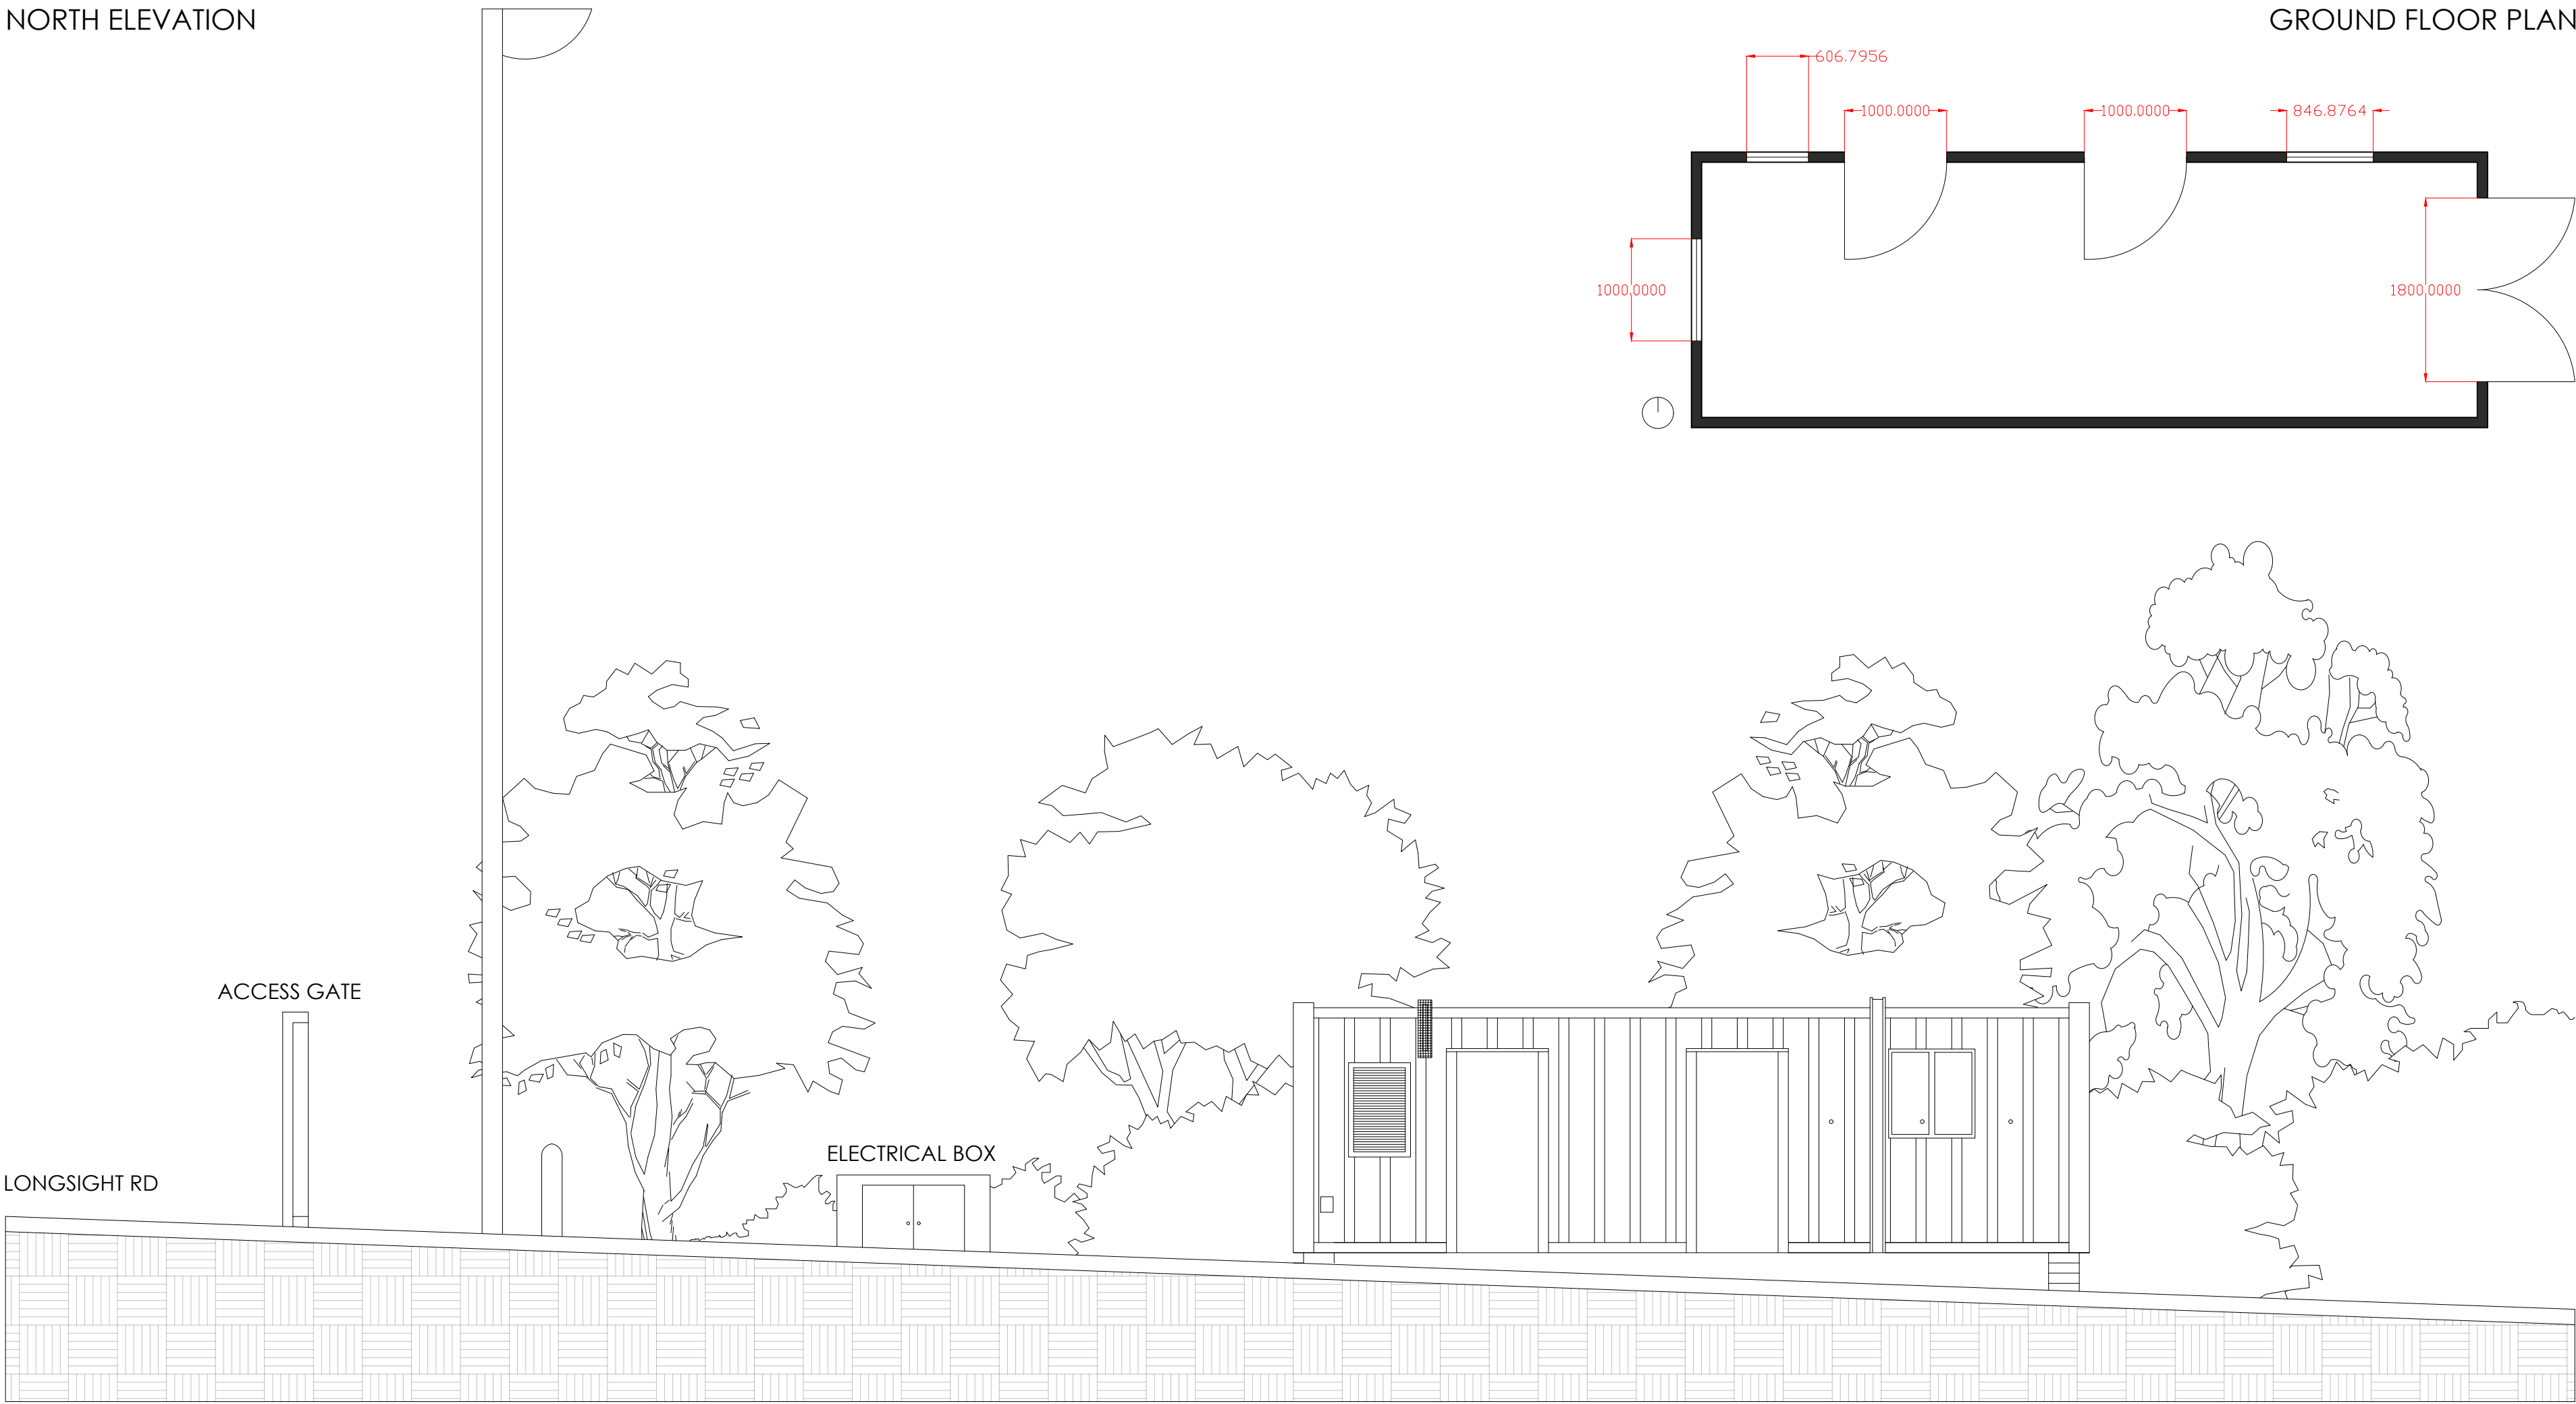

SOUTH ELEVATION

NORTH ELEVATION

SOUTH ELEVATION

EAST ELEVATION

WEST ELEVATION

