


BOUNDARY KEY ☹

- A - TIMBER FENCE 1800MM
- B - BRICK WALL UP TO 1100MM THEN TIMBER TOP FENCING 1500MM
- C - BRICK WALL UP TO 1100MM THEN TIMBER TOP FENCING 2000MM
- D - BRICK WALL, LEVEL CHANGE FROM EAST 100MM TO WEST 1300MM. TIMBER TOP FENCING 2000MM
- E - GRASS VERGE WITH TREES

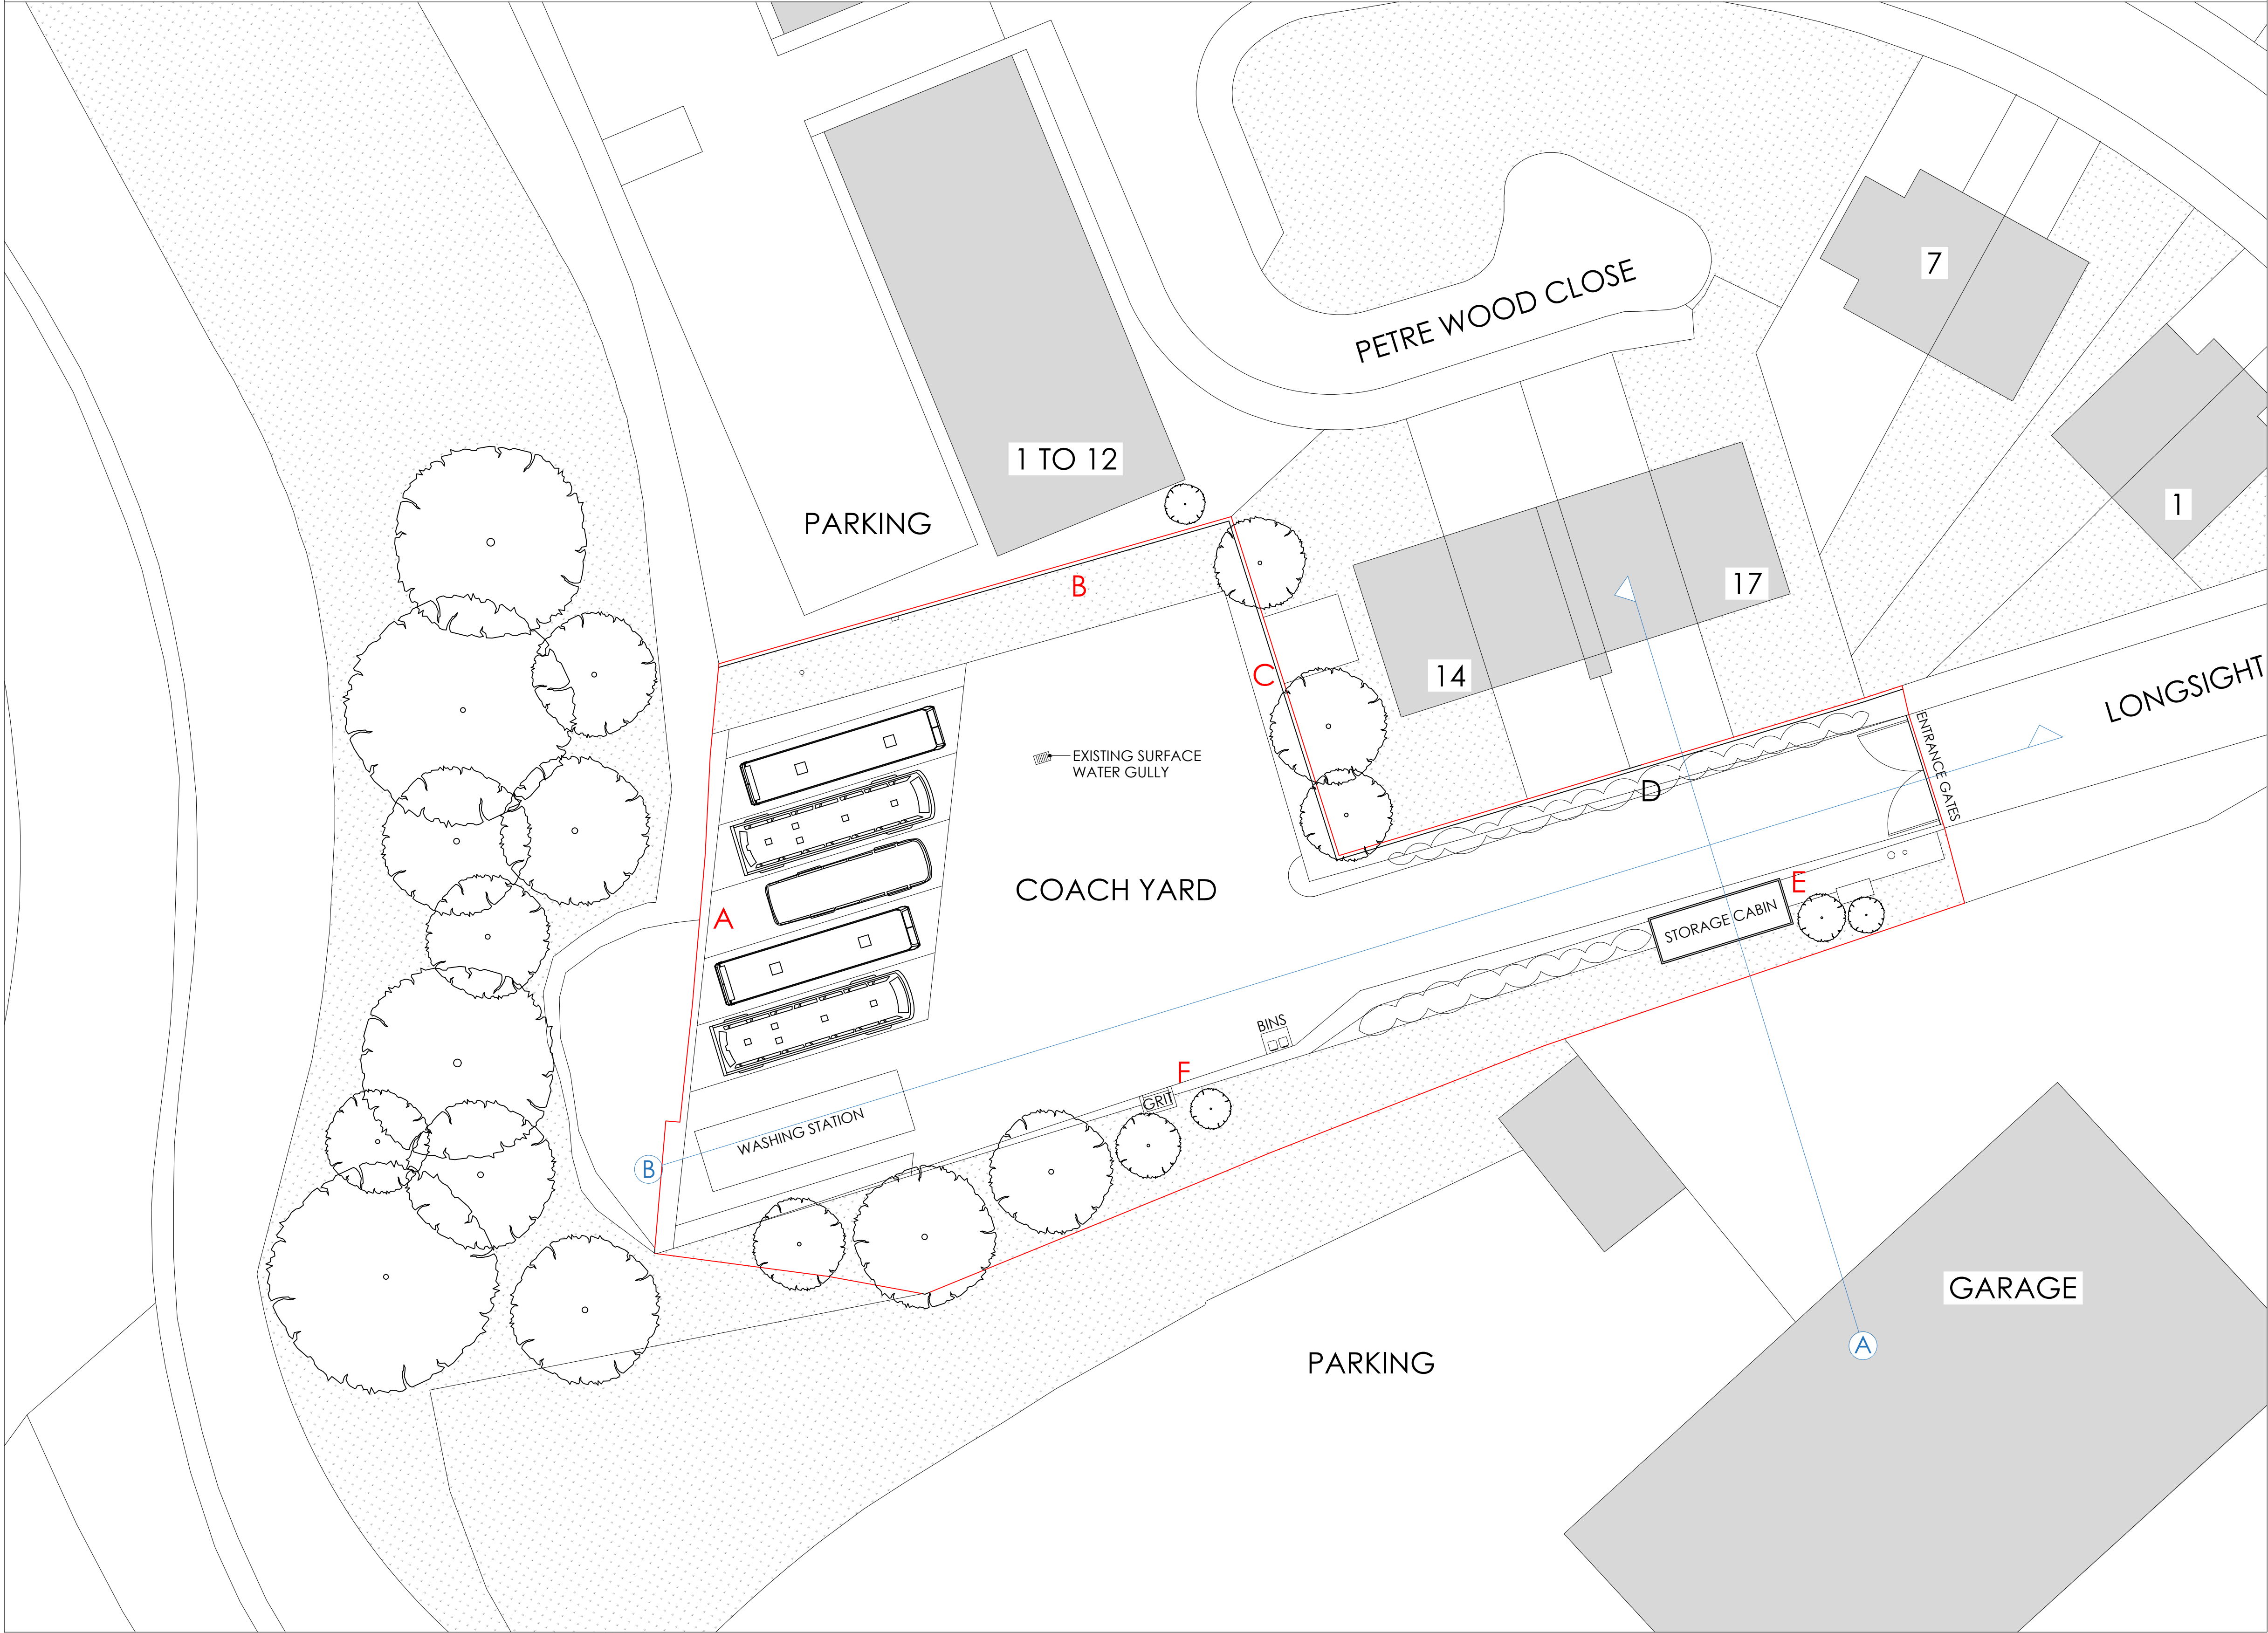

Marathon House
The Sidings Business Park
Whalley, BB7 9SE

01254 823 885

www.peterhitchenarchitects.co.uk

NOTES:
For Retrospective Planning Application.

Section A and B shown in blue to be read in conjunction with drawing A3.4

No.	Description	Date

CLIENT: Orrells Coach Hire

For the Former Waste Recycling Centre Langho, BB5 8AB

PROJECT: The use of existing site as a coach yard

SHEET: Proposed Site Plan

Project number PHA/1046

Date 13/02/2026

Drawn by LM

Checked by PH

A3.2

Scale 1 : 200

Sheet size A1