



PRE-EXISTING SITE SECTION

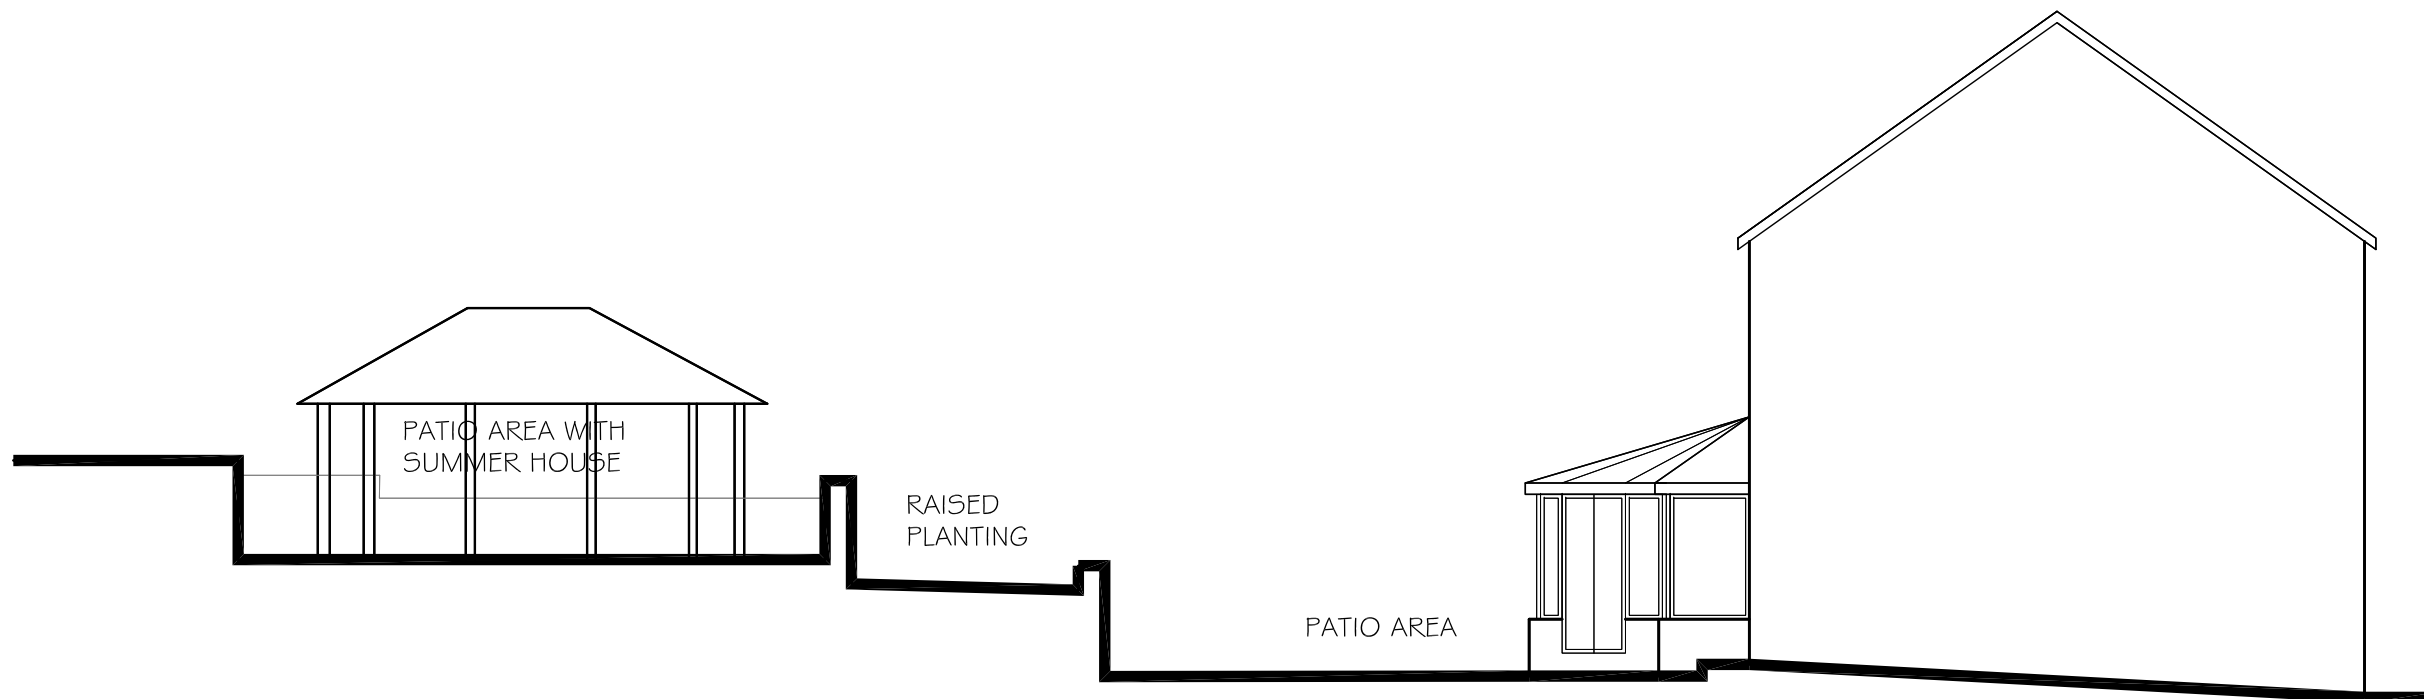

AS BUILT SITE SECTION

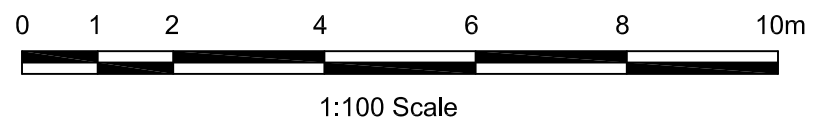

PSA Design Ltd
 The Old Bank House, 6 Berry Lane
 Longridge, Preston, PR3 3JA
 Tel. 01772 786066
 www.psadesign.co.uk
 mail@psadesign.co.uk

Client	Mr & Mrs Buchanan	Drawn	DME	Date	March '26	Scale 1:100	Sheet Size A3	Drwg No. A4693-PL09	Rev.
Job	High Beech House, Crow Trees Brow, Chatburn	Check							
Title	Site Sections	Appr.							