



SCALE 1:50

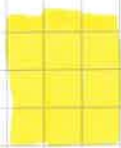


SIGN:

SIGN SIZE:
980mm x 800mm

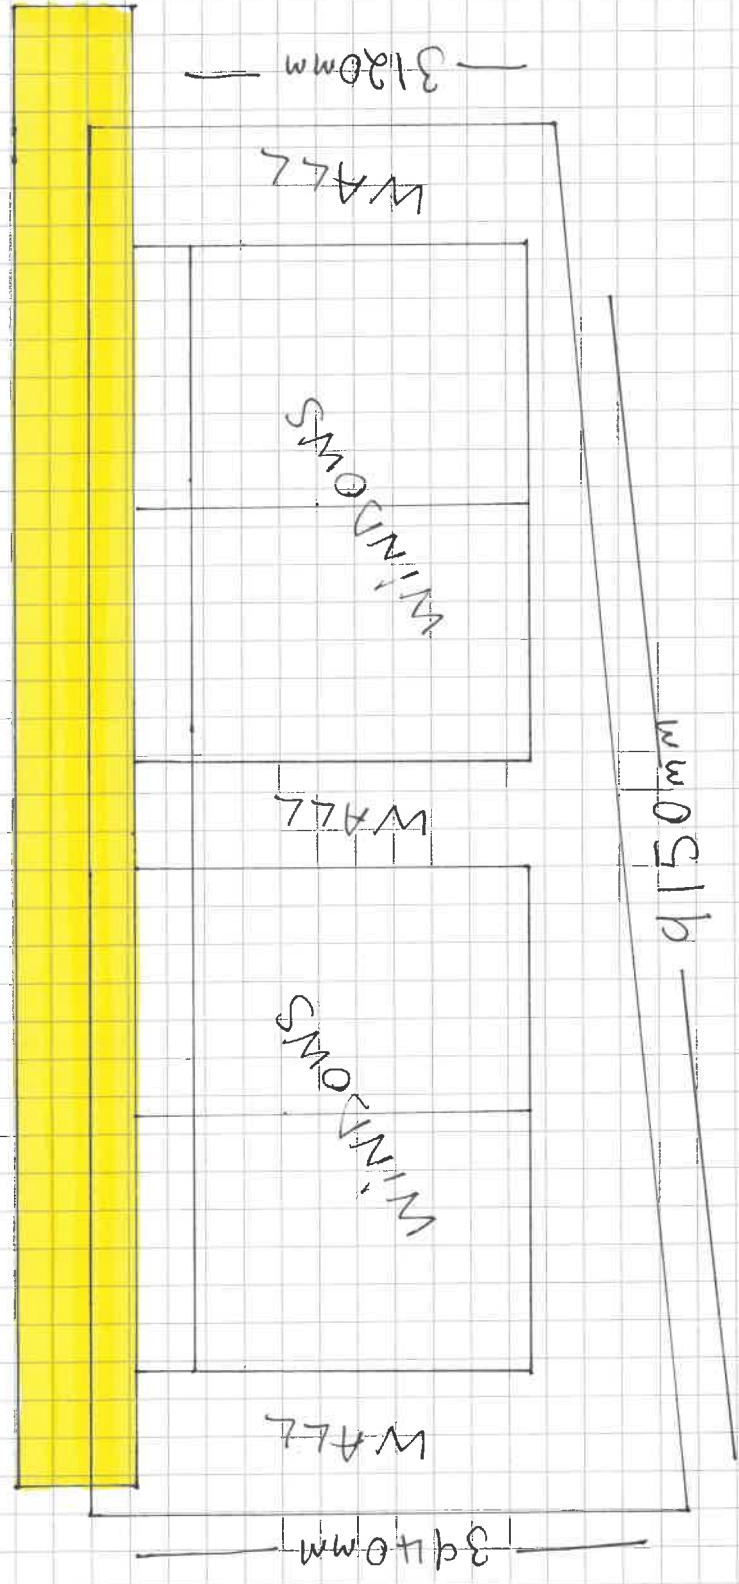

Scale 1:50

SIGN:

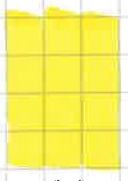

SIGN SIZE:
7000mm x 800mm

