



| A        |                              | B             |           | C        |          | D        |                | E             |           | F       |          |
|----------|------------------------------|---------------|-----------|----------|----------|----------|----------------|---------------|-----------|---------|----------|
| M.H. No. | INVERT LEVEL m               | COVER LEVEL m | GRID REF. | EASTING  | NORTHING | M.H. No. | INVERT LEVEL m | COVER LEVEL m | GRID REF. | EASTING | NORTHING |
| 50       |                              |               | U7        |          |          | 252      |                |               | P5        |         |          |
| 51       |                              |               | S7        |          |          | 253      |                |               | N6        |         |          |
| 52       |                              |               | S8        |          |          | 255      |                |               | T13       |         |          |
| 53       | 87.221                       |               | R8        |          |          | 256      |                |               | S13       |         |          |
| 54       |                              |               | R9        |          |          | 266      |                |               | P7        |         |          |
| 55       | 87.001                       |               | R9        |          |          | 267      |                |               | P6        |         |          |
| 56       |                              |               | S10       |          |          | 269      |                |               | M7        |         |          |
| 57       |                              |               | S10       |          |          |          |                |               |           |         |          |
| 58       | 87.935                       |               | S10       |          |          |          |                |               |           |         |          |
| 59       | 86.648                       |               | S10       |          |          |          |                |               |           |         |          |
| 60       |                              |               | S9        |          |          |          |                |               |           |         |          |
| 61       |                              |               | S8        |          |          |          |                |               |           |         |          |
| 62       |                              |               | R8        |          |          |          |                |               |           |         |          |
| 63       |                              |               | R8        |          |          |          |                |               |           |         |          |
| 64       |                              |               | T7        |          |          |          |                |               |           |         |          |
| 65       |                              |               | R8        |          |          |          |                |               |           |         |          |
| 68       |                              |               | Q9        |          |          |          |                |               |           |         |          |
| 69       |                              |               | Q9        |          |          |          |                |               |           |         |          |
| 77       | 84.228                       |               | S11       |          |          |          |                |               |           |         |          |
| 79       | 82.329                       |               | Q13       |          |          |          |                |               |           |         |          |
| 80       |                              |               | S11       |          |          |          |                |               |           |         |          |
| 85       | 81.96                        | 83.958        | Q12       |          |          |          |                |               |           |         |          |
| 86       | 81.725                       | 83.562        | N12       |          |          |          |                |               |           |         |          |
| 87       | 81.47                        | 83.135        | M12       |          |          |          |                |               |           |         |          |
| 88       | 80.77                        | 82.468        | L11       |          |          |          |                |               |           |         |          |
| 106      |                              |               | R7        |          |          |          |                |               |           |         |          |
| 107      |                              |               | R8        |          |          |          |                |               |           |         |          |
| 125      |                              |               | N11       |          |          |          |                |               |           |         |          |
| 126      |                              |               | M12       |          |          |          |                |               |           |         |          |
| 152      |                              |               | S10       |          |          |          |                |               |           |         |          |
| 154      | 79.784                       | 81.583        | F10       |          |          |          |                |               |           |         |          |
| 207      |                              |               | K11       |          |          |          |                |               |           |         |          |
| 208      |                              |               | H10       |          |          |          |                |               |           |         |          |
| 214      |                              |               | S13       |          |          |          |                |               |           |         |          |
| 235      |                              |               | M7        |          |          |          |                |               |           |         |          |
| 236      | 82.309                       |               | L7        | 937.985  | 1048.883 |          |                |               |           |         |          |
| 237      | 82.031                       |               | K7        | 146.522  | 1029.781 |          |                |               |           |         |          |
| 238      | 81.403                       |               | J8        | 994.394  | 1029.372 |          |                |               |           |         |          |
| 239      | 81.374                       |               | J9        |          |          |          |                |               |           |         |          |
| 240      | 81.131                       |               | J8        |          |          |          |                |               |           |         |          |
| 241      | 80.957                       |               | H9        | 1007.371 | 1002.597 |          |                |               |           |         |          |
| 242      | 82.152                       |               | J6        |          |          |          |                |               |           |         |          |
| 243      | 81.535                       |               | H7        |          |          |          |                |               |           |         |          |
| 244      | 81.117                       |               | H8        |          |          |          |                |               |           |         |          |
| 245      | 80.653                       |               | H9        |          | 1002.452 |          |                |               |           |         |          |
| 246      | 80.219(#150)<br>80.082(#225) |               | H10       |          | 1000.036 |          |                |               |           |         |          |
| 249      |                              |               | M6        |          |          |          |                |               |           |         |          |
| 250      |                              |               | N13       |          |          |          |                |               |           |         |          |
| 251      |                              |               | N12       |          |          |          |                |               |           |         |          |

National Grid sheet reference at centre  
of this Superplan: SD7442  
Centre Coordinates: 374636 442997

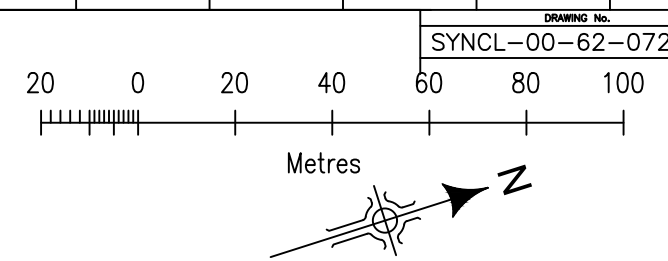

- NOTE
1. MANHOLE 214 IS ALSO USED FOR STORMWATER.  
SEE NOTE 03. ON DRAWING No. SYNCL-00-62-07229.
  2. NATIONAL GRID SHEET REFERENCE AT THE CENTRE  
OF THIS SUPERPLAN: SD7442  
CENTRE COORDINATES: 374636 442997.
  3. THE INFORMATION RECORDED ON DRG. Nos.  
00310-21-61-04776 & 00310-21-61-04778 IS WRONG.
  4. THE INFORMATION ON THIS DRAWING IS TAKEN FROM MARKED UP COPIES  
OF DRG. Nos. 00310-21-61-04776 & 00310-21-61-04778.  
THE COPIES ARE ALMOST ILLEGIBLE.
  5. MAN HOLE COVERS & IDENTIFICATION PLATES  
TO BE PAINTED:-  
DULUX GOLD CUP 1178-Y16R BS08E51. U/C GOLD.
  6. MH154 IS ALSO ON DRG. No. SYNCL-00-62-07229.

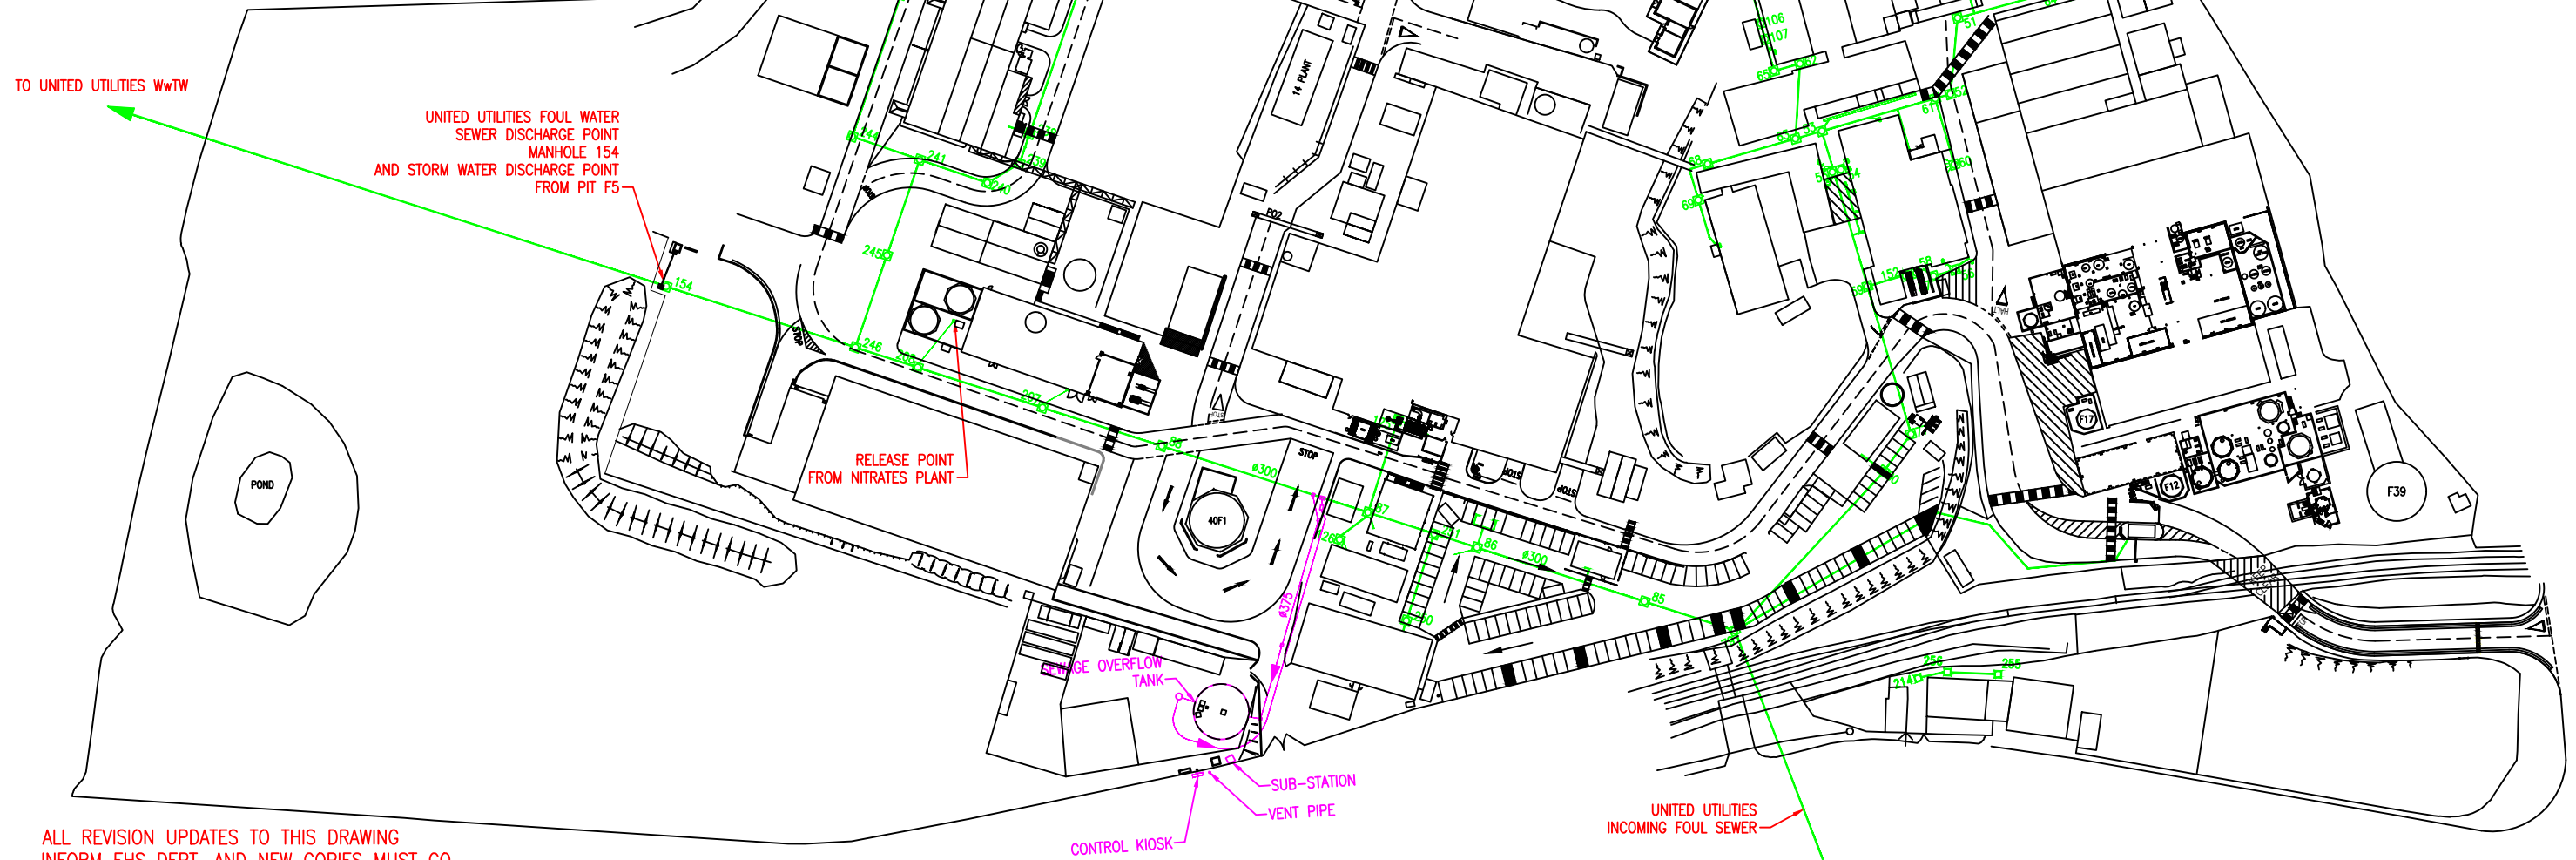

ALL REVISION UPDATES TO THIS DRAWING  
INFORM EHS DEPT. AND NEW COPIES MUST GO  
TO FARMHOUSE COMAH ROOM AND AN ELECTRONIC  
COPY TO CLITHEROE FIRE STATION

[illegible]