


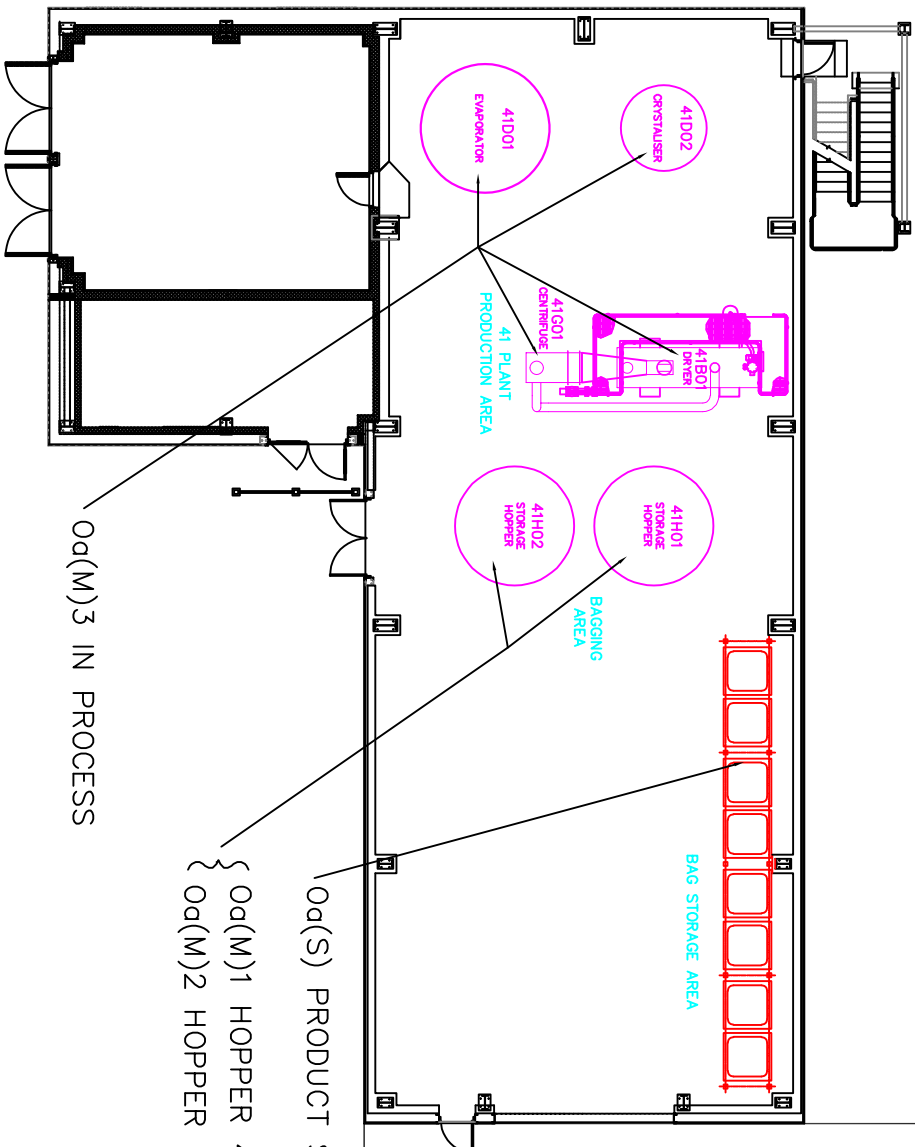

D	11270 HATCHED AREA REMOVED.	S.T.SCOTT	A.BREITHERICK	A.PENMAN	23.6.2026
C	10248 41F02 & 41H03(S) REMOVED. TITLE CHANGED.	S.T.SCOTT	A.BREITHERICK	A.PENMAN	7.4.2021
B	BROUGHT INTO LINE WITH MARKED-UP PRINT	S.T.SCOTT	A.BREITHERICK	A.PENMAN	28.8.2020
A	1st. ISSUE.	S.T.SCOTT	A.BREITHERICK	A.PENMAN	16.7.2014
ISSUE	REVISION	GRID	CHECKED	APPROVED	DATE

NOTES

DRG. TITLE:

HSE HAZARDOUS SUBSTANCES CONSENT POTASSIUM OR SODIUM NITRATE DETAIL CHANGES.

PROJECT No:

WORKS CUTHEROE

BUILDING: K92

PLAN:

MOD. No.:

SCALE:

1:100

DRG TYPE:

DO LOC CUTHEROE

CHECKED:

DATE:

16.7.2014

APPROVED:

DATE:

THIS DRAWING IS THE PROPERTY OF JOHNSON MATTHEY IT MUST NOT BE COPIED OR LENT WITHOUT THE CONSENT OF JOHNSON MATTHEY AND MUST BE RETURNED ON REQUEST TO JOHNSON MATTHEY PO BOX 1 BILLSWIM CLEVELAND TS23 1TB BRADN.

DRAWING No.

DRG. SIZE

A2

REF. DRG. No.

REFERENCE DRAWING TITLE

SYNCL-41-13-21036

D