




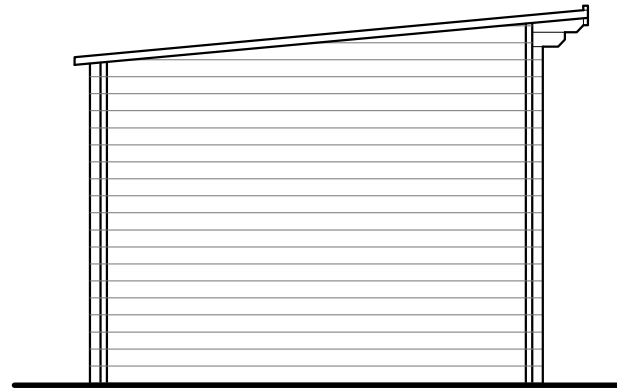


**OUTBUILDING
NORTH ELEVATION**
Scale 1:50

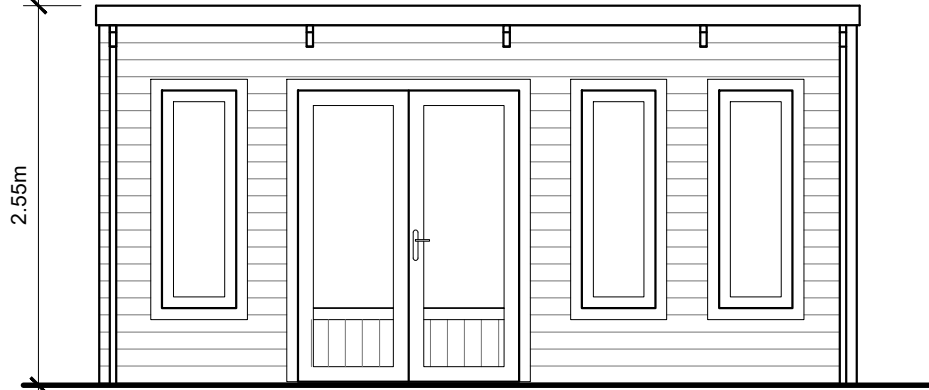


**OUTBUILDING
WEST ELEVATION**
Scale 1:50

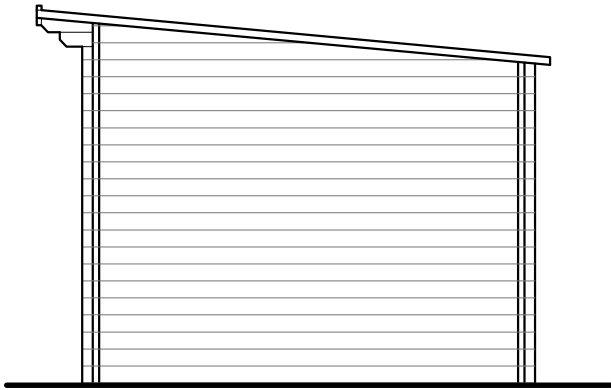


**OUTBUILDING
SOUTH ELEVATION**
Scale 1:50

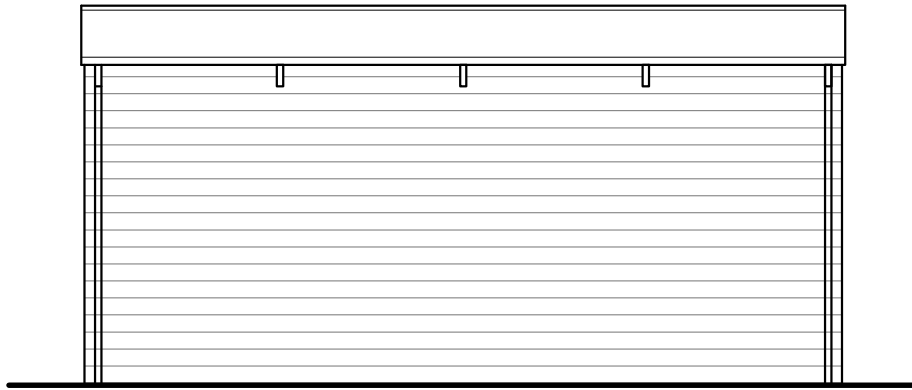


**OUTBUILDING
EAST ELEVATION**
Scale 1:50

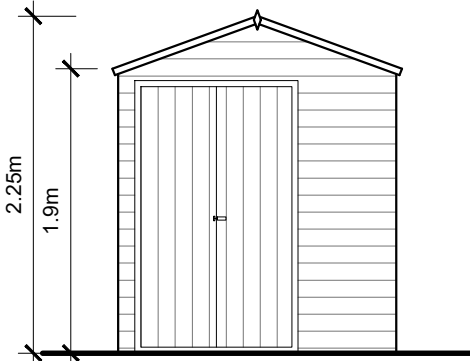


**SHED
WEST ELEVATION**
Scale 1:50

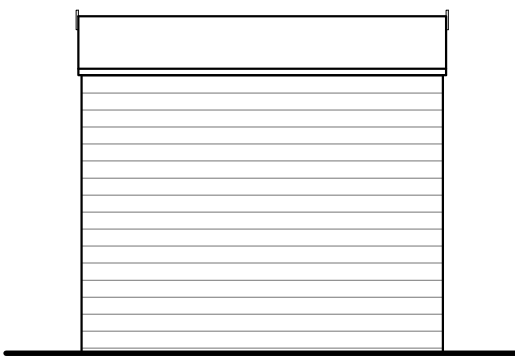


**SHED
NORTH ELEVATION**
Scale 1:50

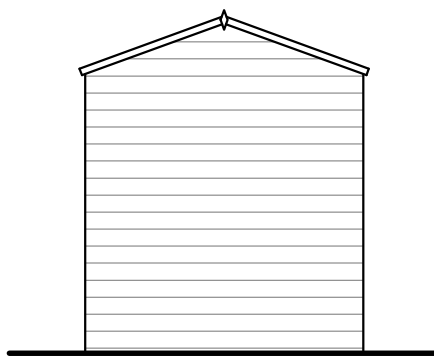


**SHED
EAST ELEVATION**
Scale 1:50

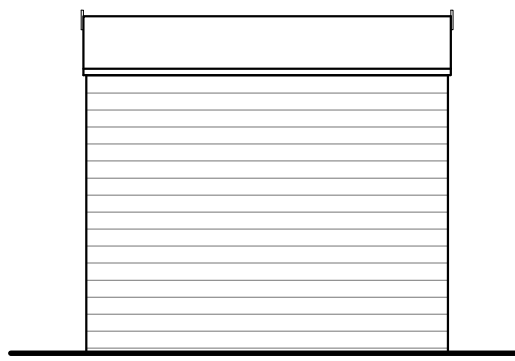


**SHED
SOUTH ELEVATION**
Scale 1:50

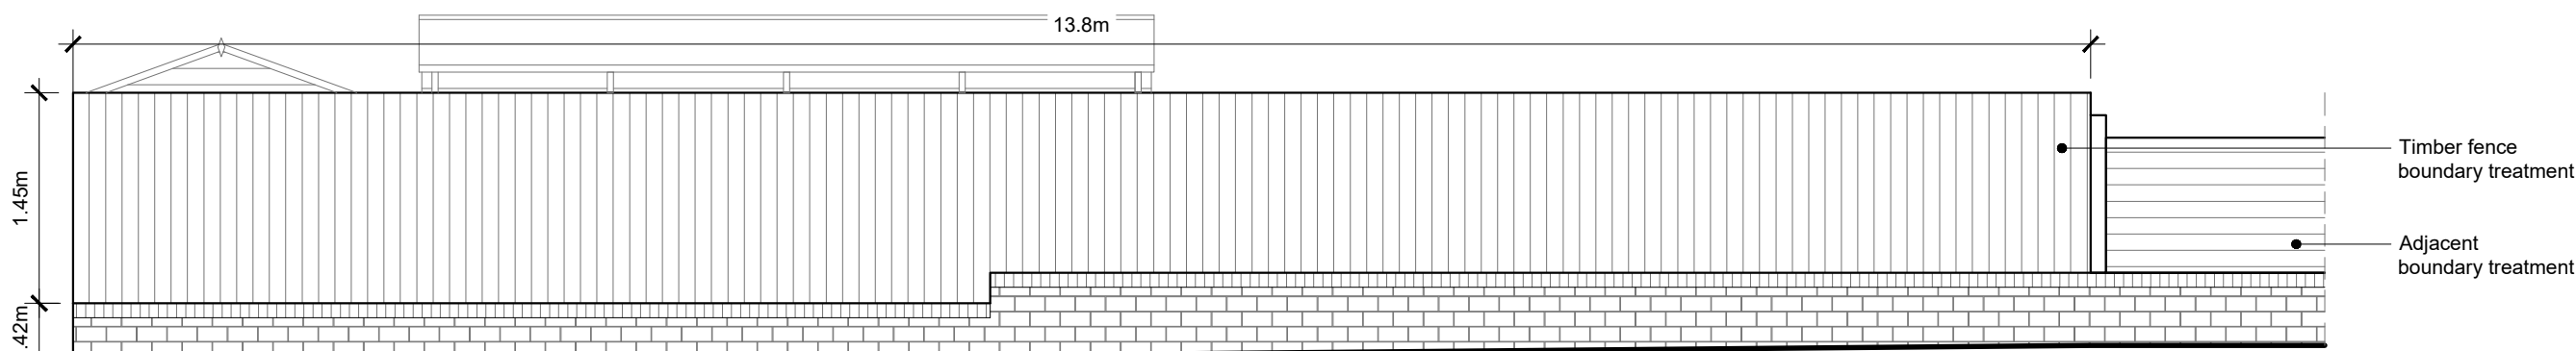

STREET SCENE
Scale 1:50

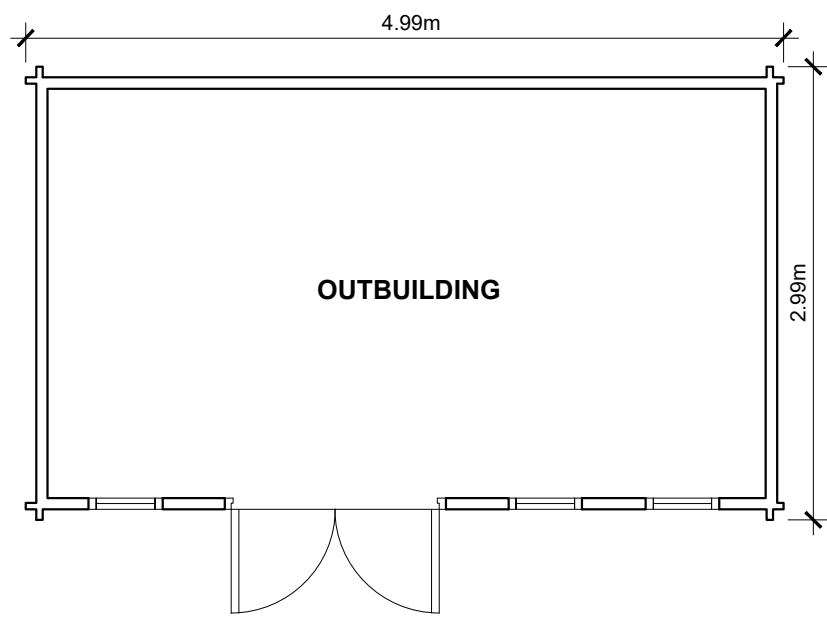

OUTBUILDING
Scale 1:50

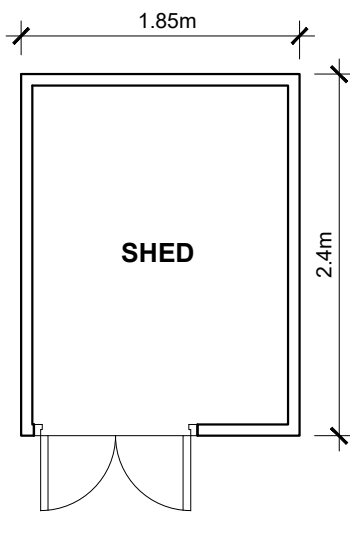

SHED
Scale 1:50



PRE - EXISTING SITE PLAN
Scale 1:200



EXISTING (AS BUILT) SITE PLAN
Scale 1:200