

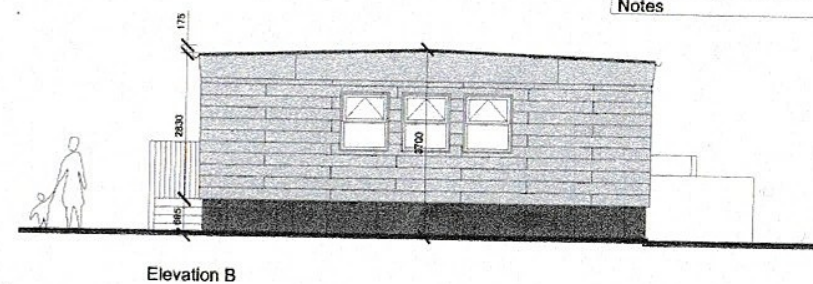
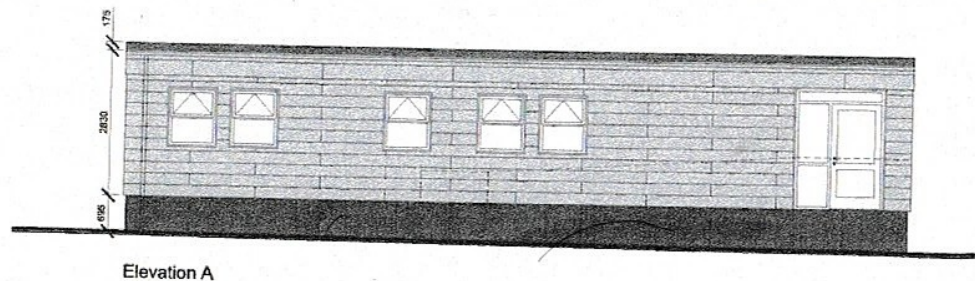



Notes

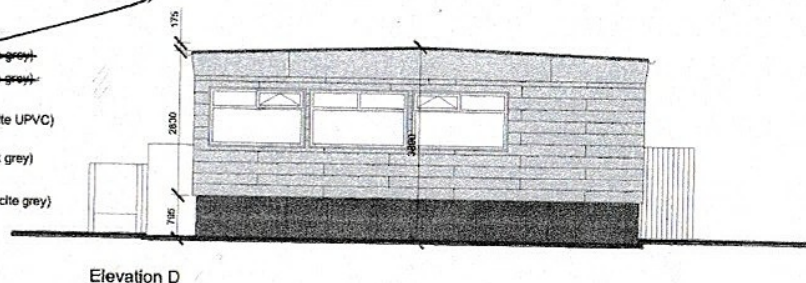

CLADDING TO BE ELEGASIA LIGHT OAK

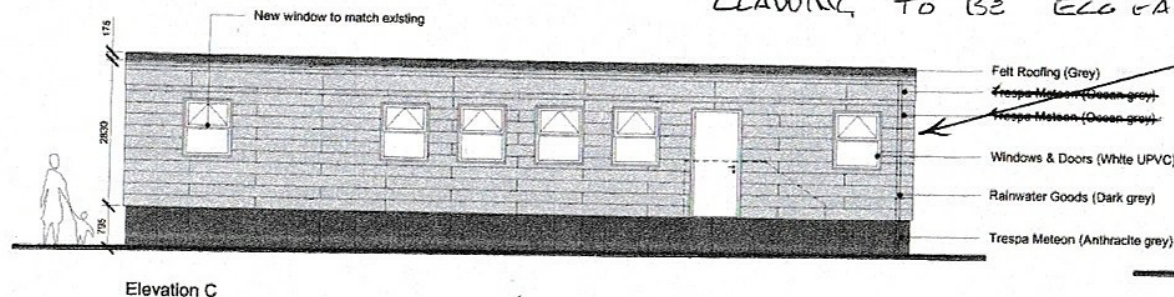

- Felt Roofing (Grey)
- ~~Trespa Mateon (Ocean grey)~~
- ~~Trespa Mateon (Ocean grey)~~
- Windows & Doors (White UPVC)
- Rainwater Goods (Dark grey)
- Trespa Mateon (Anthracite grey)

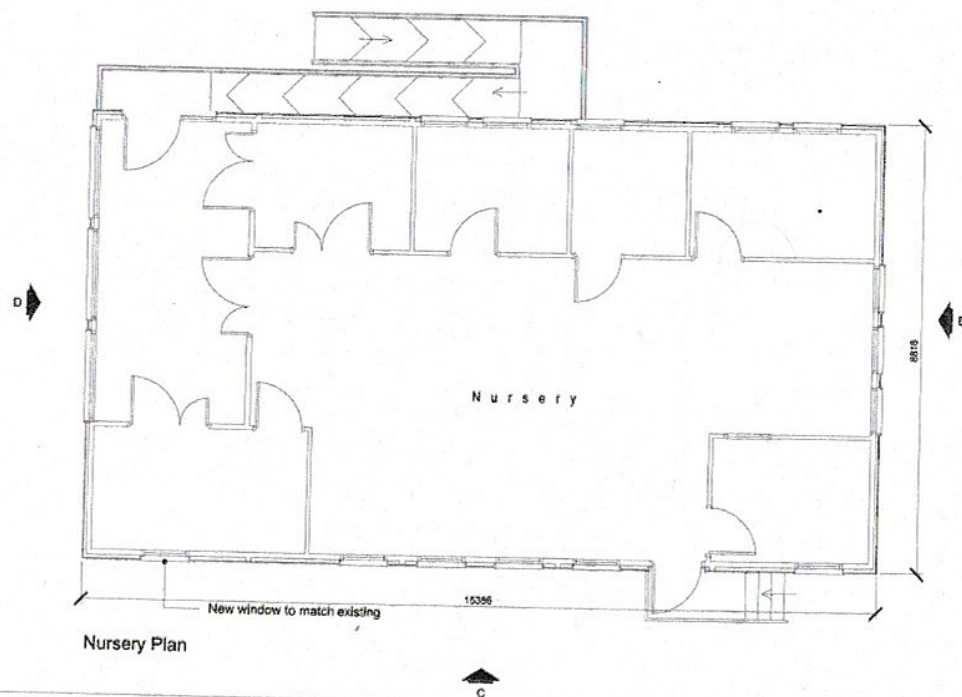

- Prefabricated Building - External Materials Upgrade
- Roof Finish: Felt Membrane (Grey)
- Walls / Fascia: Trespa Mateon (Ocean Grey Strips - Fixed with polytop screws)
- Skirting: Trespa Mateon (Anthracite Grey - Fixed with polytop screws)
- Windows: UPVC (White)
- Doors: UPVC (White)
- Rainwater Goods: UPVC (Dark Grey)

A 23/06/2018 Dimensions added
Rev Date Revision Notes

ERIC WRIGHT
FACILITIES MANAGEMENT

Eric Wright Ltd
Ruscombe House - Sneyd Road
Barnesley - Rotherham S68 6AT
Tel: 01772 604622
Fax: 01772 604611
www.ericwright.co.uk

Project
Nursery Building Refurbishment
Longridge C of E Primary School
Berry Lane Longridge PR3 3JA

Client
Longridge C of E Primary School

Drawing Title
Proposed Plan & Elevations

Drawing Status
Planning

Date
May 2018

Scale
1:100

Drawing Ref
0629/LS/P02

Rev
A

