


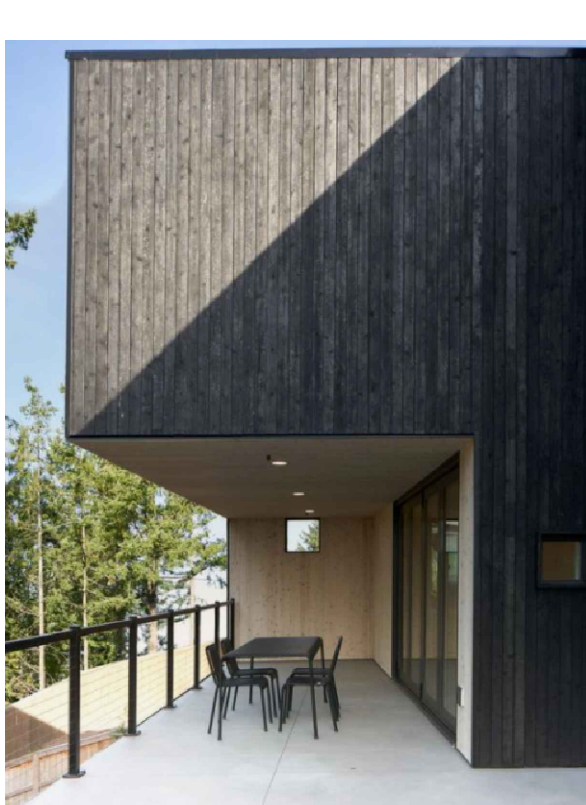
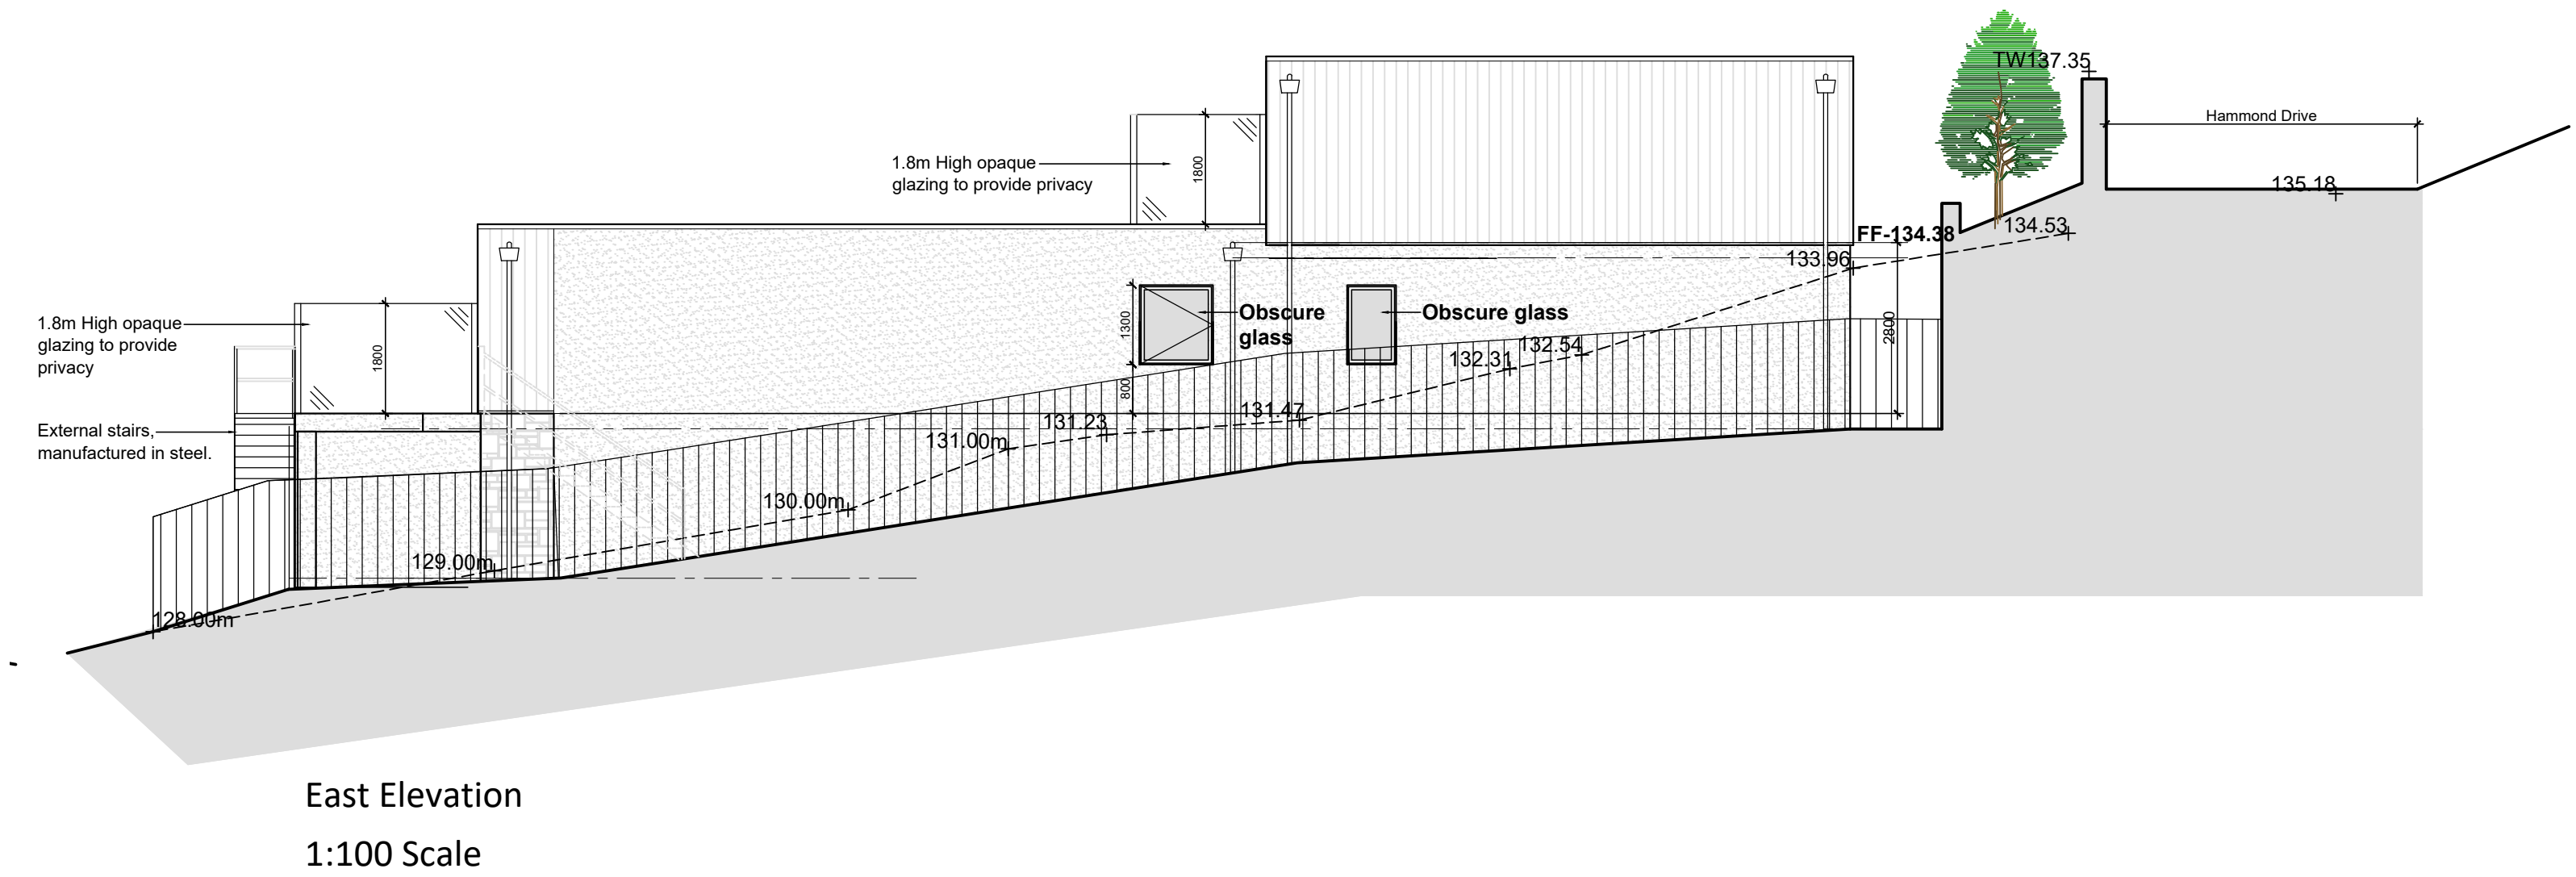
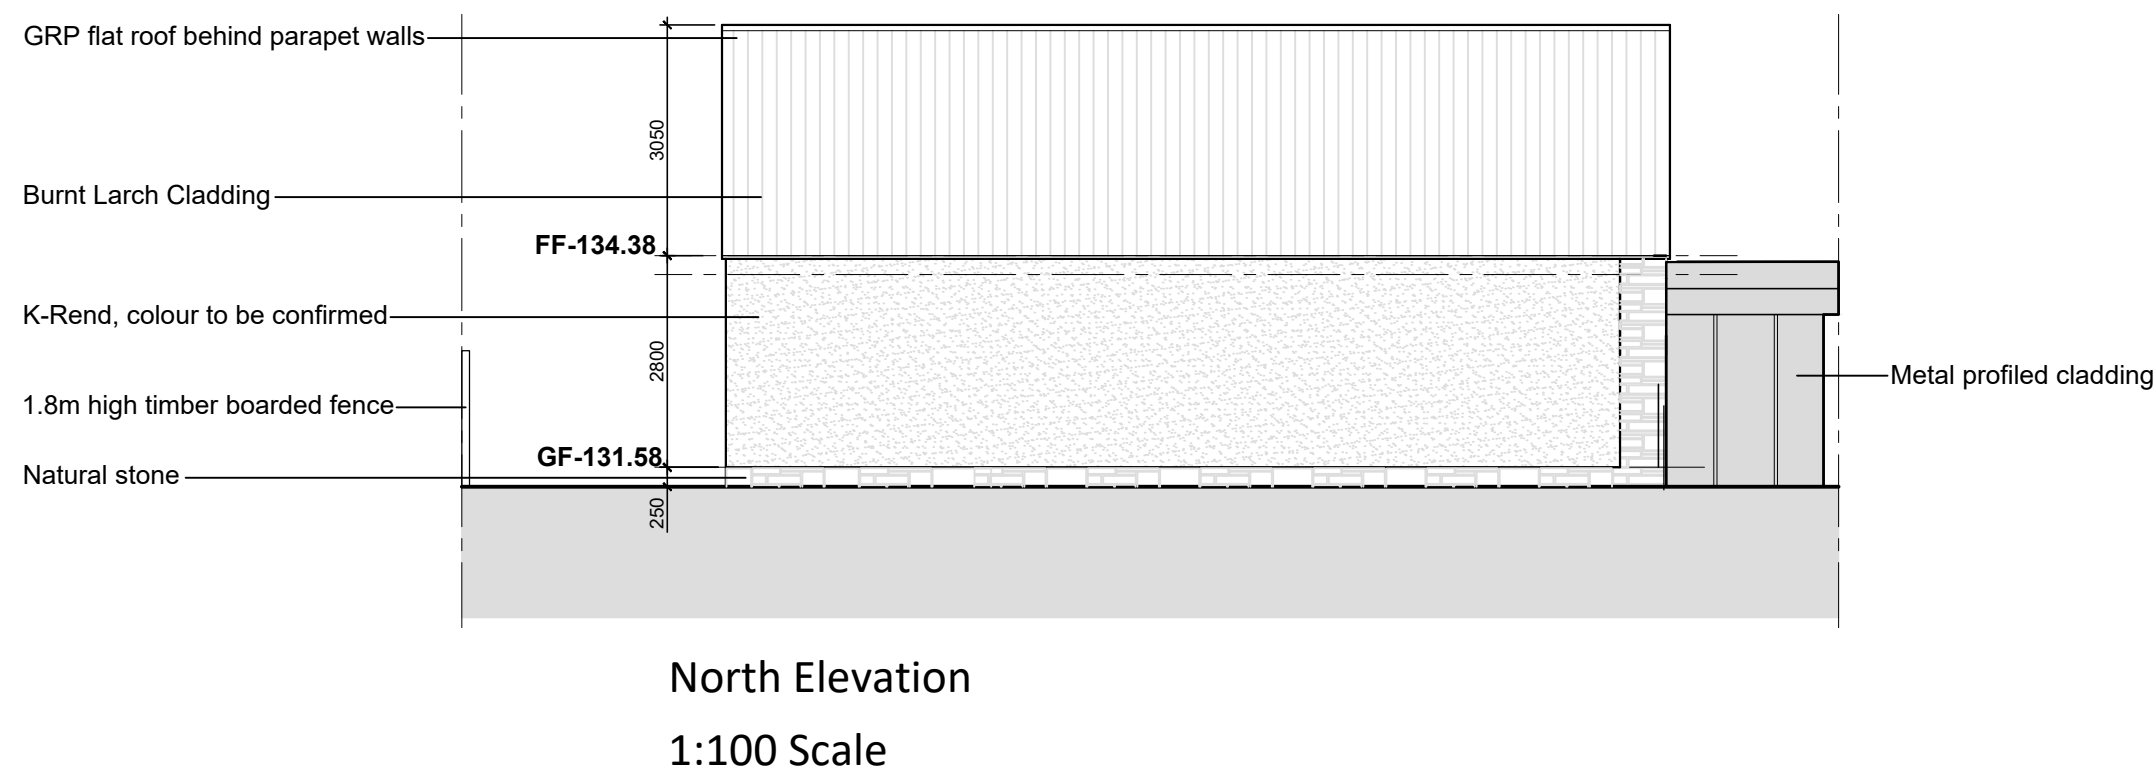
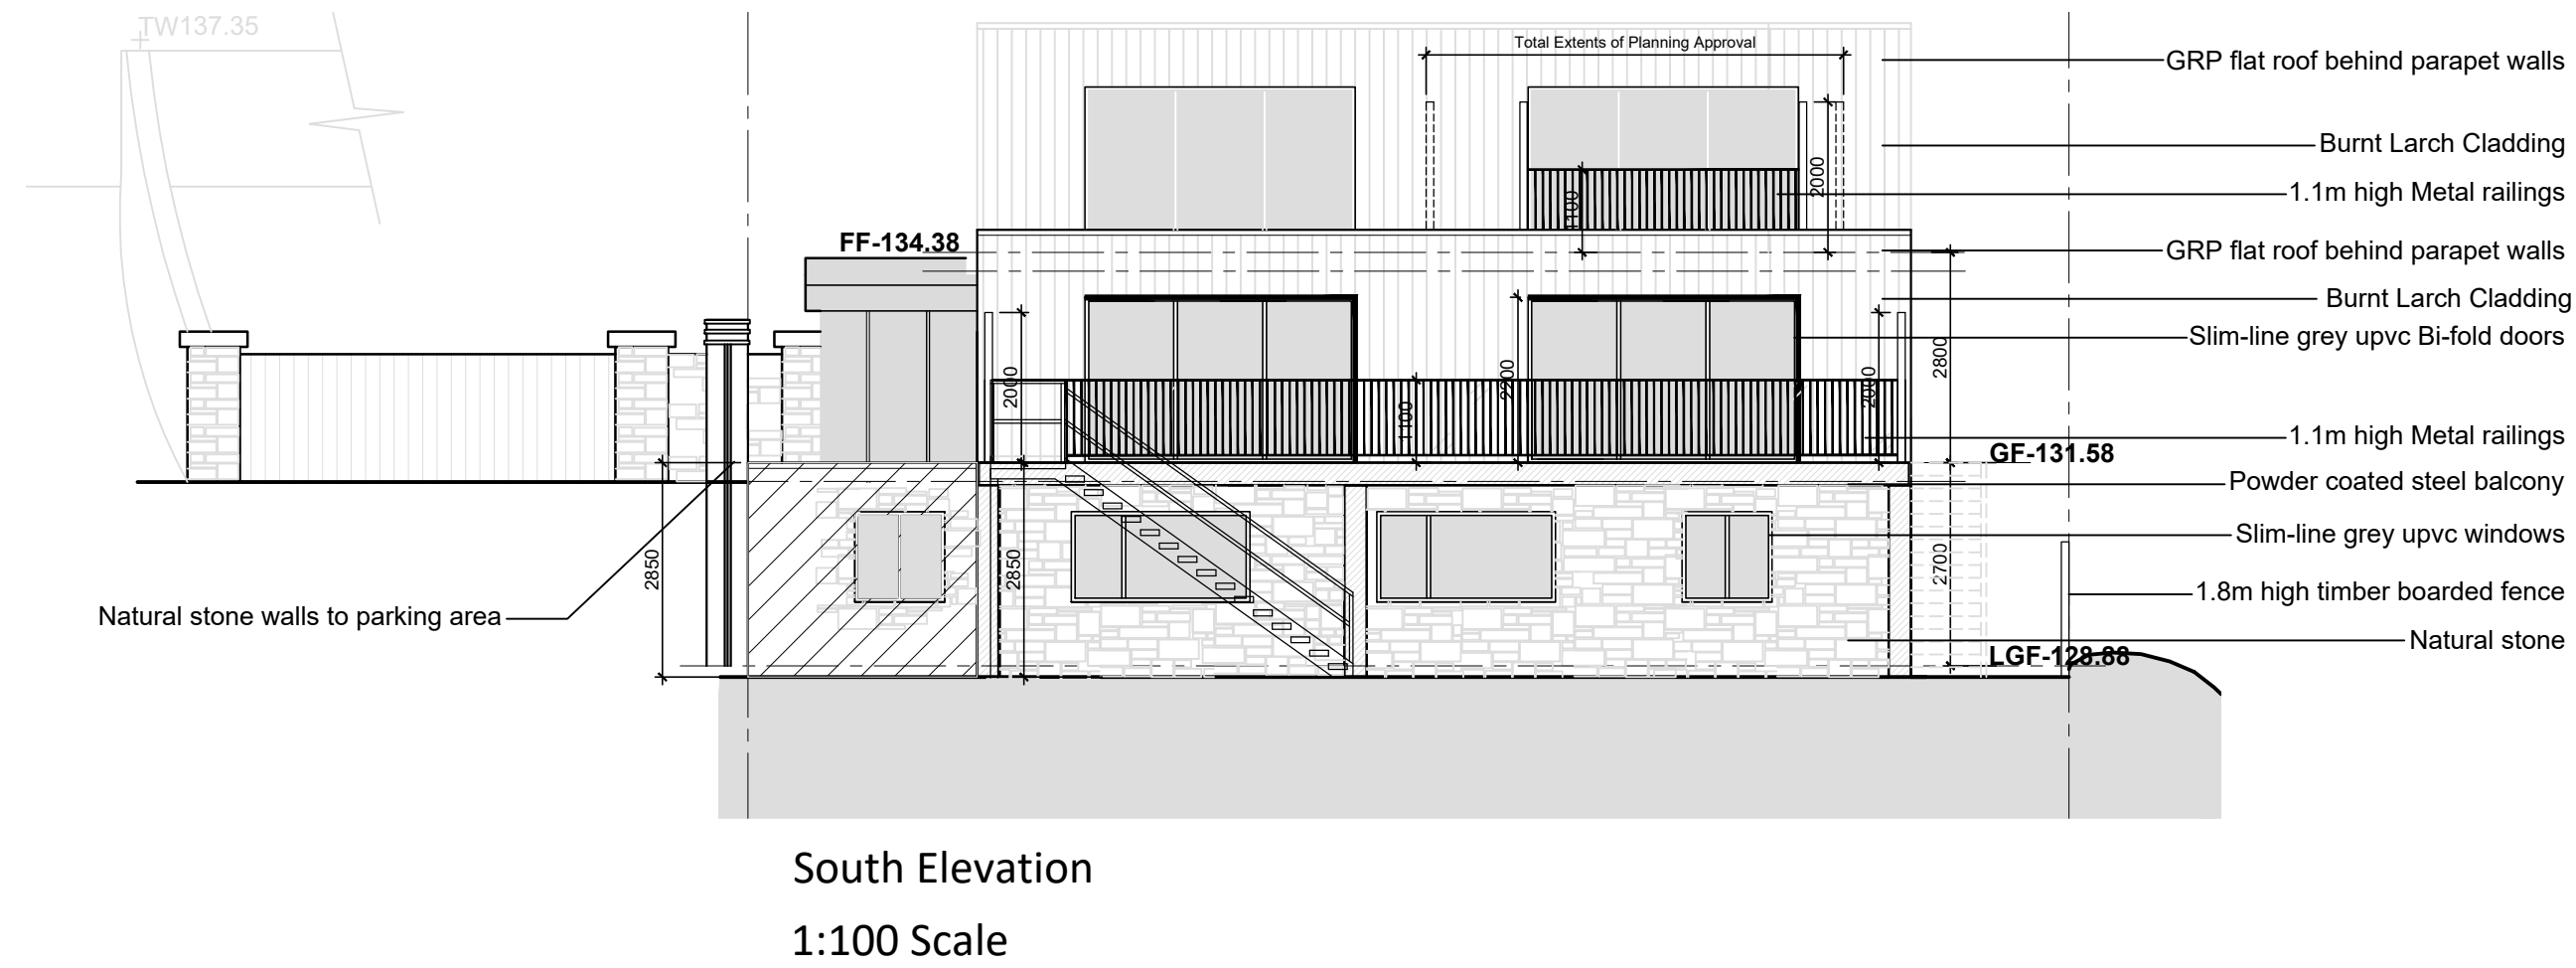
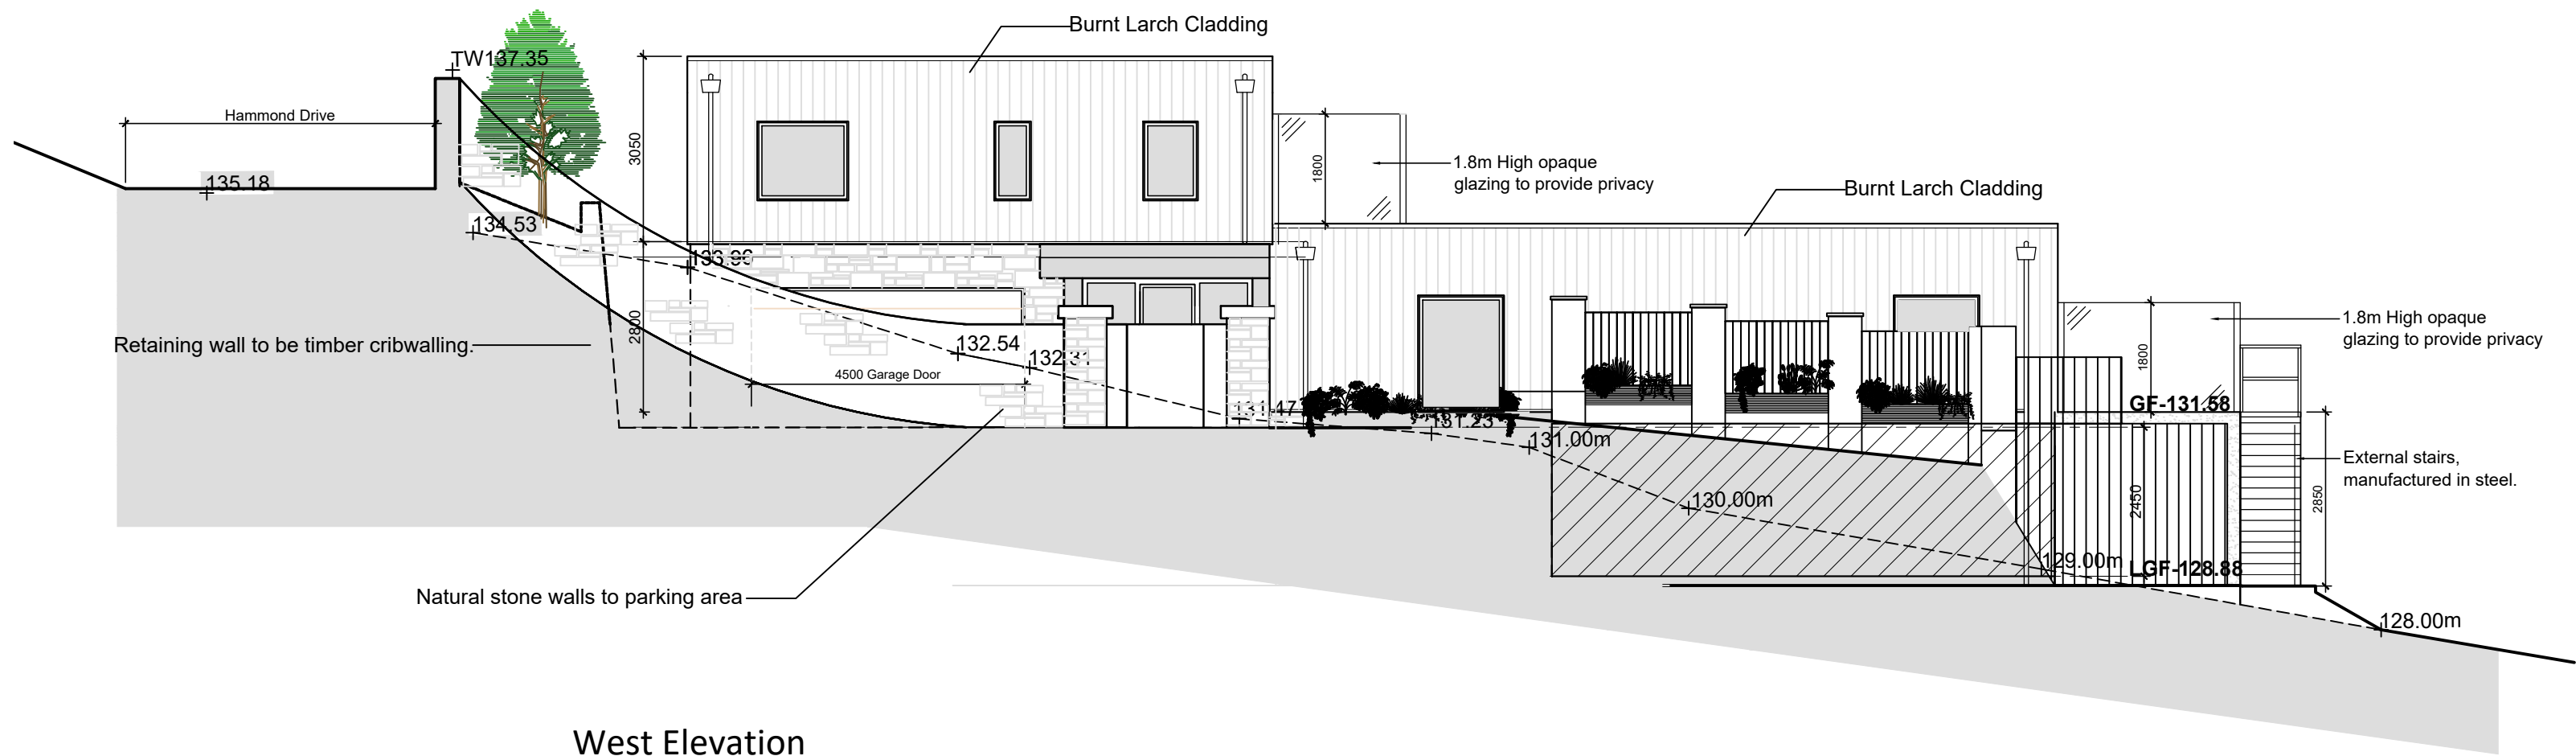


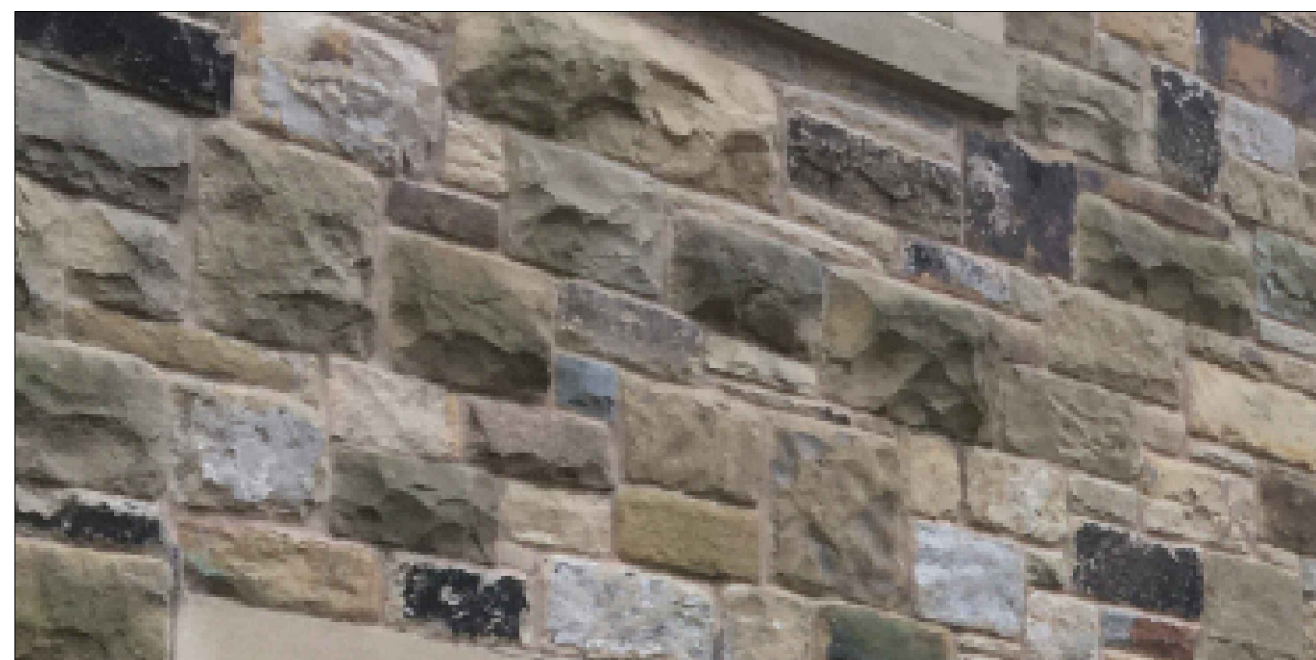

Burnt Larch Cladding

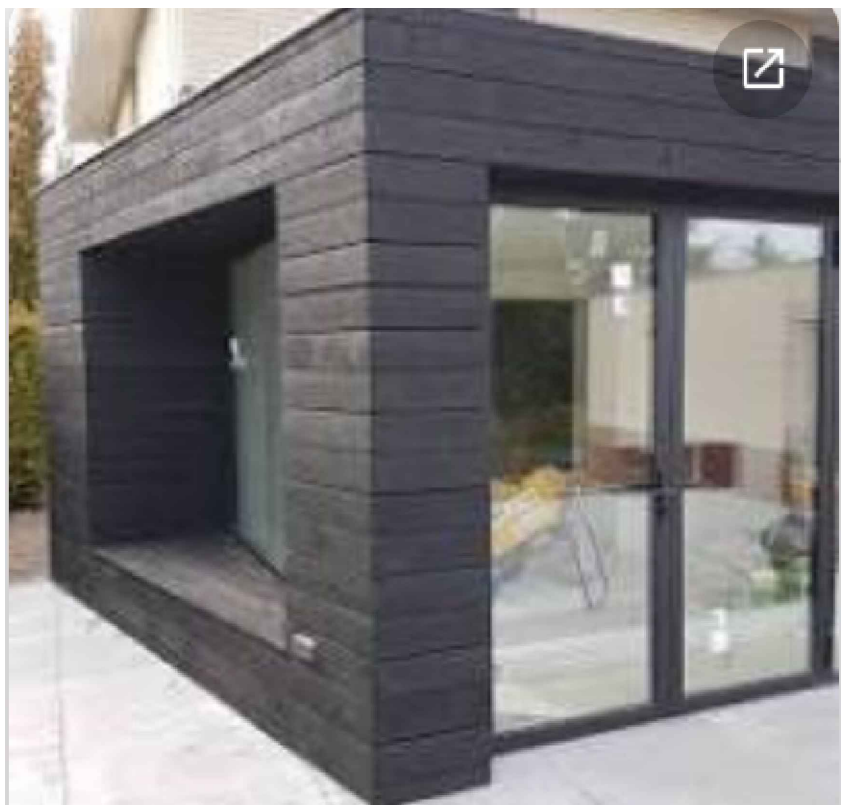


Natural stone

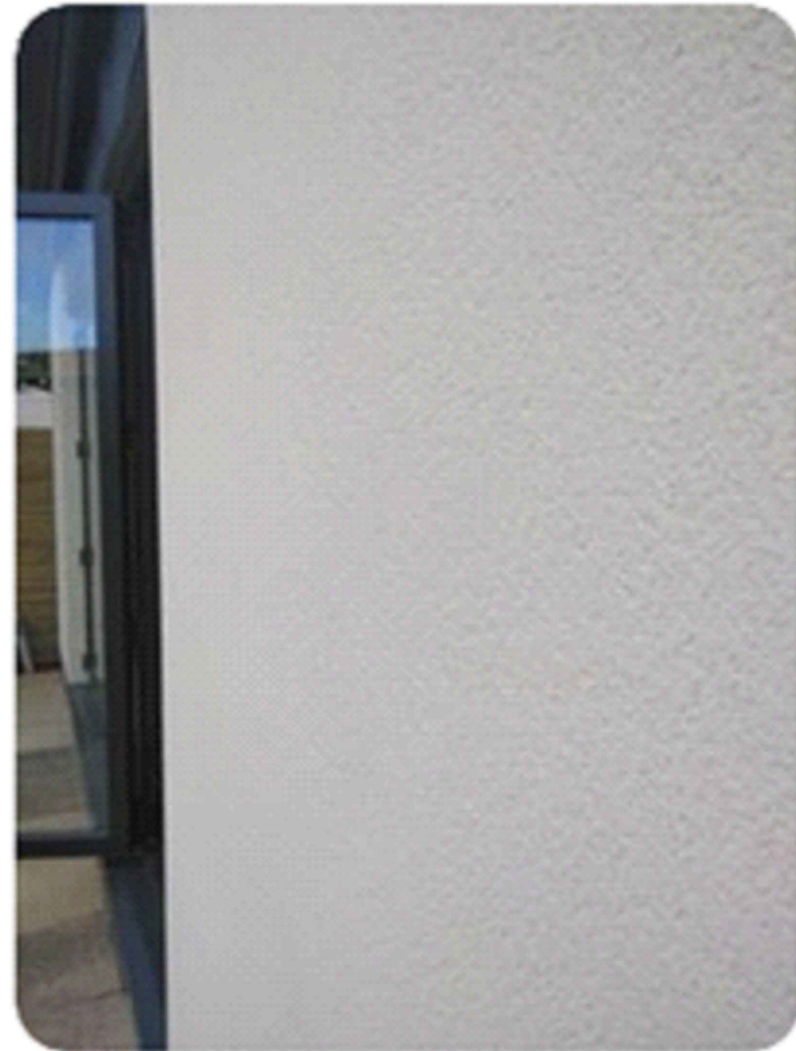

K-Rend Scaped Finish Render



Wall cladding: Catnic - SSR2 Standing Seam Cladding - To Entrance Canopy, steel colour coated (colour tbc).

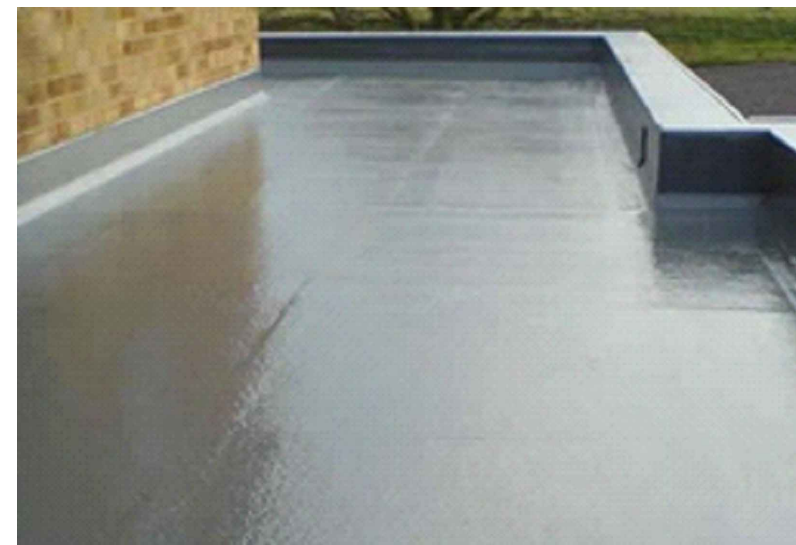

Polyroof GRP Flat Roof - Colour Dark Battleship Grey

Rev J: Opaque glass to sides of balcony/terrace, railings to rear to remain, external stairs moved to rear (previously on side). 27.07.2025, Craig Harrison
Rev I: Updated to As Built (in progress). 08.12.2025, Craig Harrison

Client
Mr John Houston
Job Title
Proposed Alterations to 8 Hammond Drive Read

Drawing Title
Proposed Elevations
Scale
1:100 @ A1
Date
March 2021
Drawn
Craig Harrison

spa
SUNDERLAND PEACOCK & ASSOCIATES LTD.
HAZELMERE, PRALICO ROAD, CLITHEROE
LANCASHIRE, BB7 2AG
T 01200 423178 F 01200 427328
E info@sunderlandpeacock.com
www.sunderlandpeacock.com



6219 - P01J