
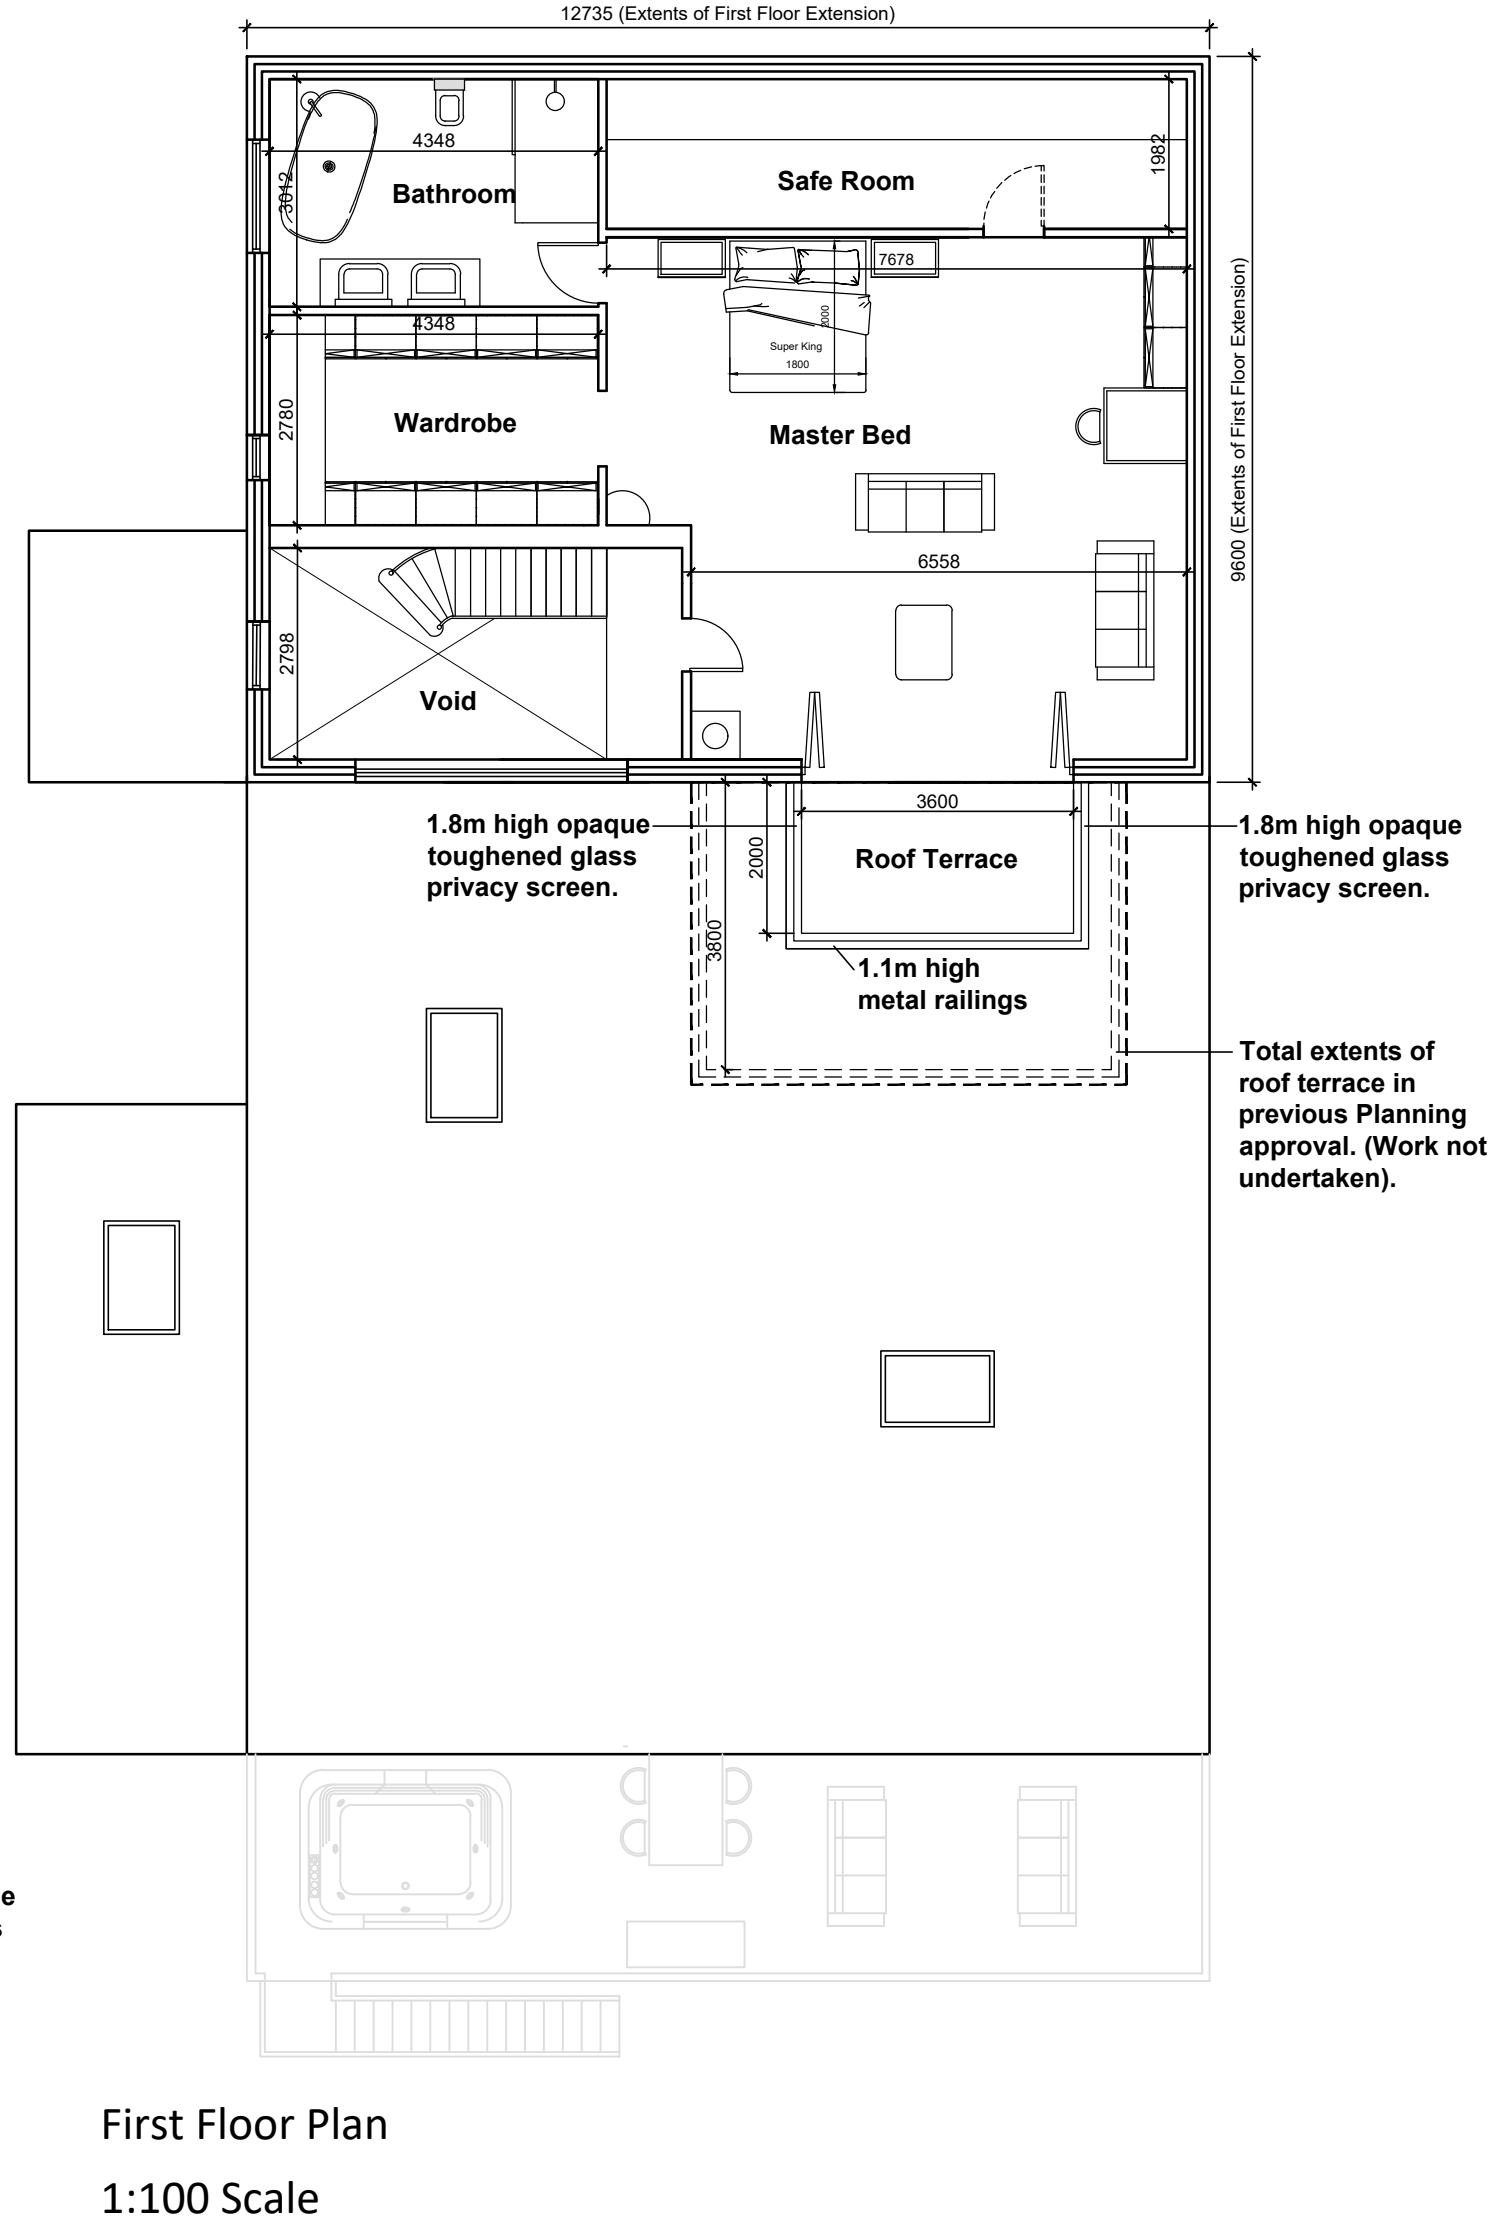
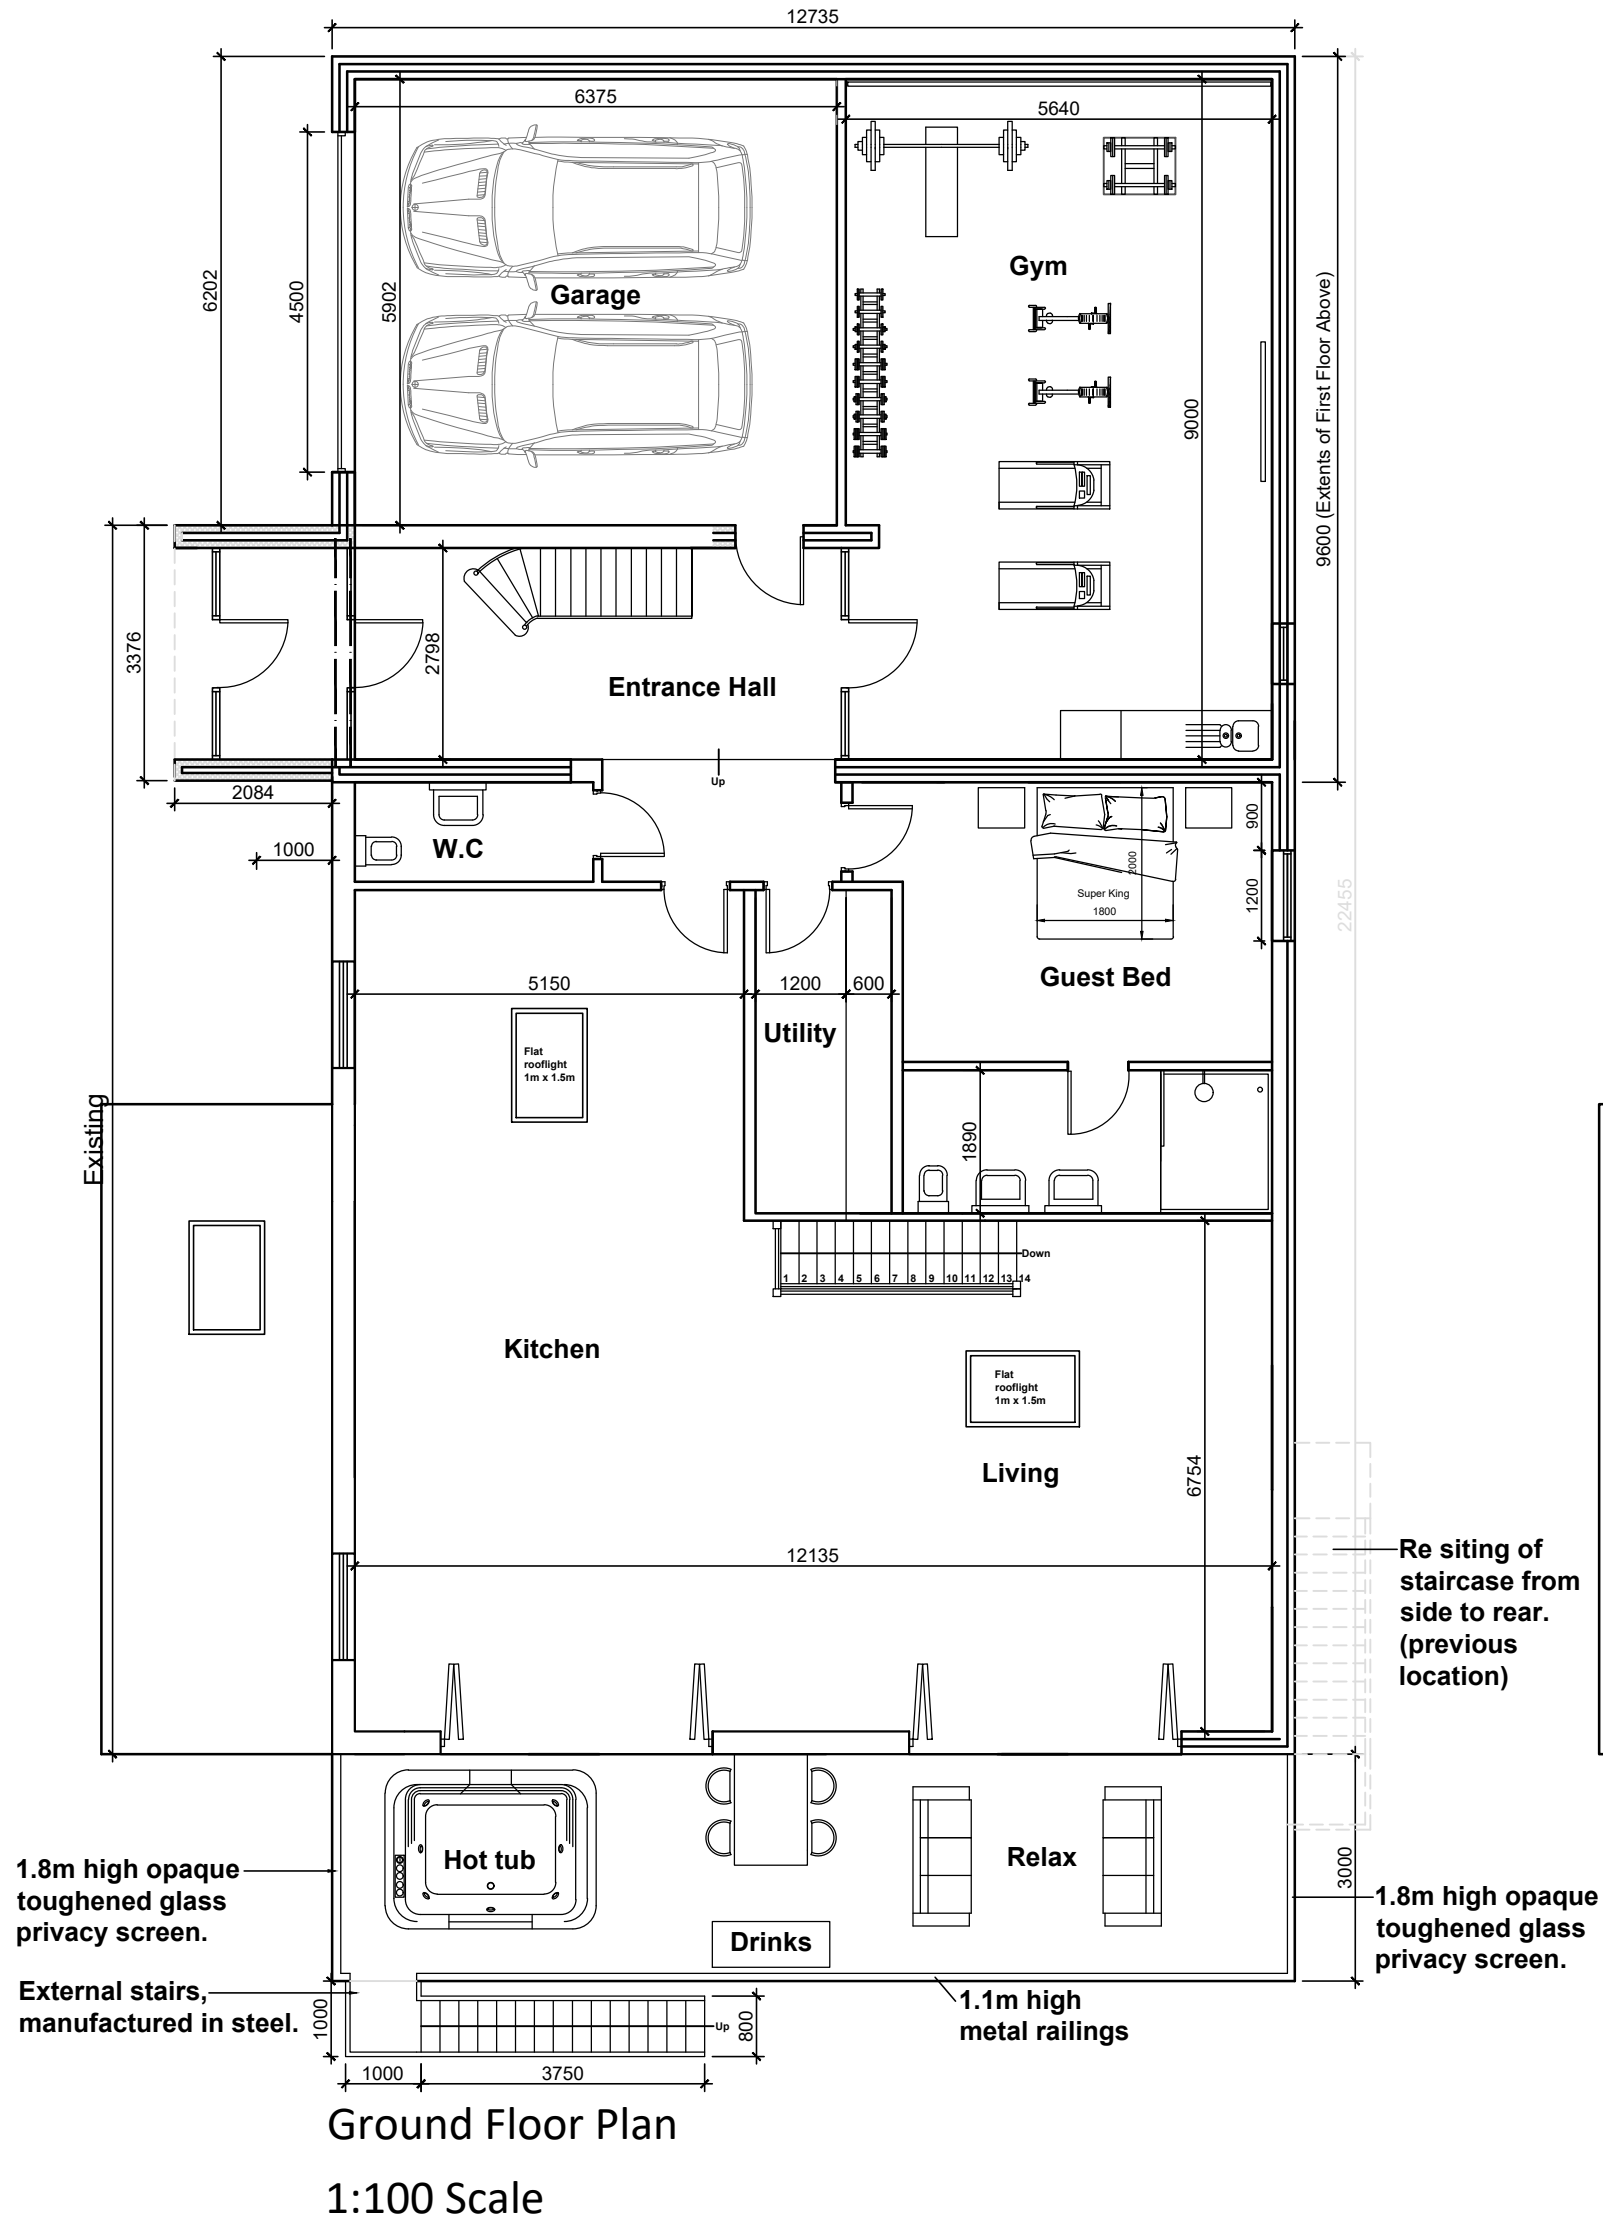


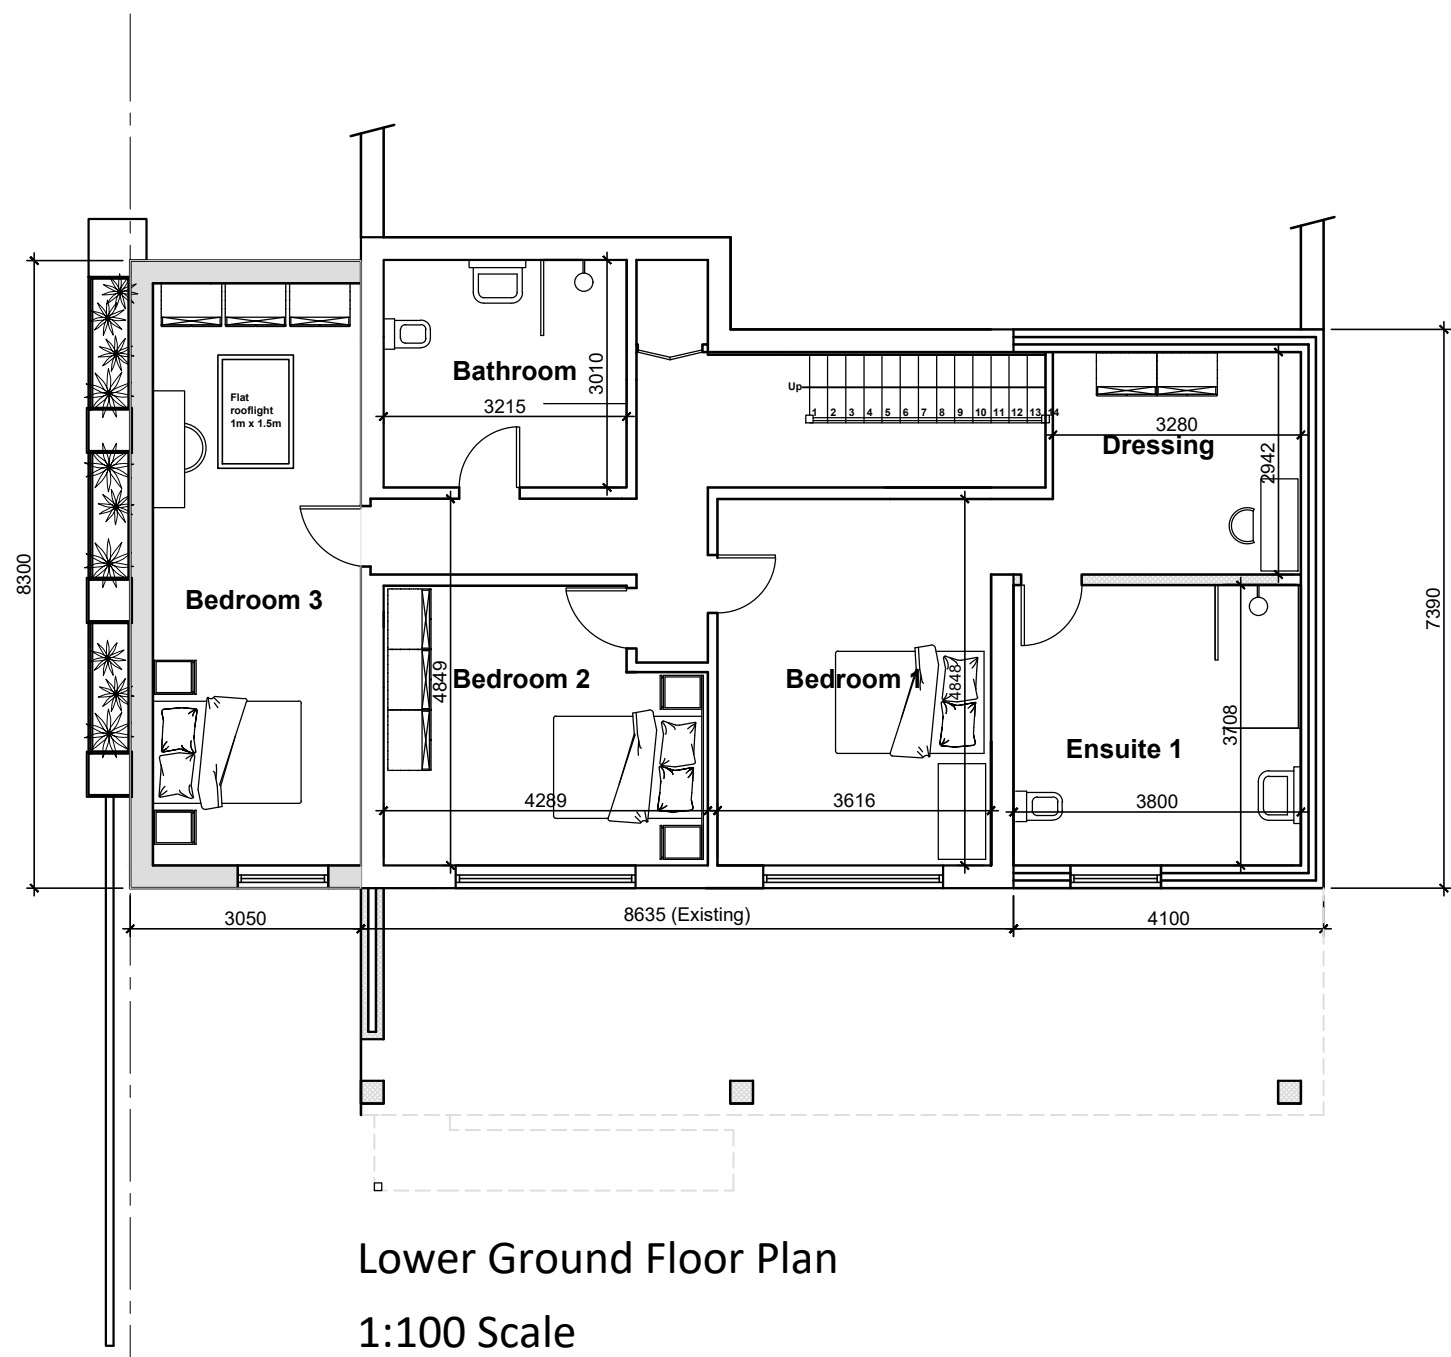

Rev J: Opaque glass to sides of balcony/terrace, railings to rear to remain, external stairs moved to rear (previously on side). 27.07.2025. Craig Harrison
Rev I: Updated to As Built (in progress). 08.12.2025. Craig Harrison
Rev G: Window included to Guest Bedroom. 14.02.2023. Craig Harrison
Rev F: Client amendments, to layout to suit new kitchen, rooflights added etc, width of whole house increased by 300mm as instructed by Client. 22.11.2021. Craig Harrison

Client
Mr John Houston

Job Title
Proposed Alterations to
8 Hammond Drive
Read

Drawing Title
Proposed Floor Plans

Scale
1:100 @ A1

Date
April 2021

Drawn
Craig Harrison