



This drawing is to be read in conjunction with all relevant Architect, consultants' and specialists' drawings and specifications. The Architect is to be notified of any discrepancies before proceeding. Do not scale from this drawing. All dimensions and levels are to be checked on site. This drawing is subject to copyright. All work carried out before Planning and Building Permission has been granted is at the contractor's risk.

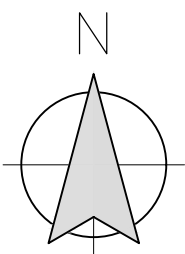

1:100 Scale

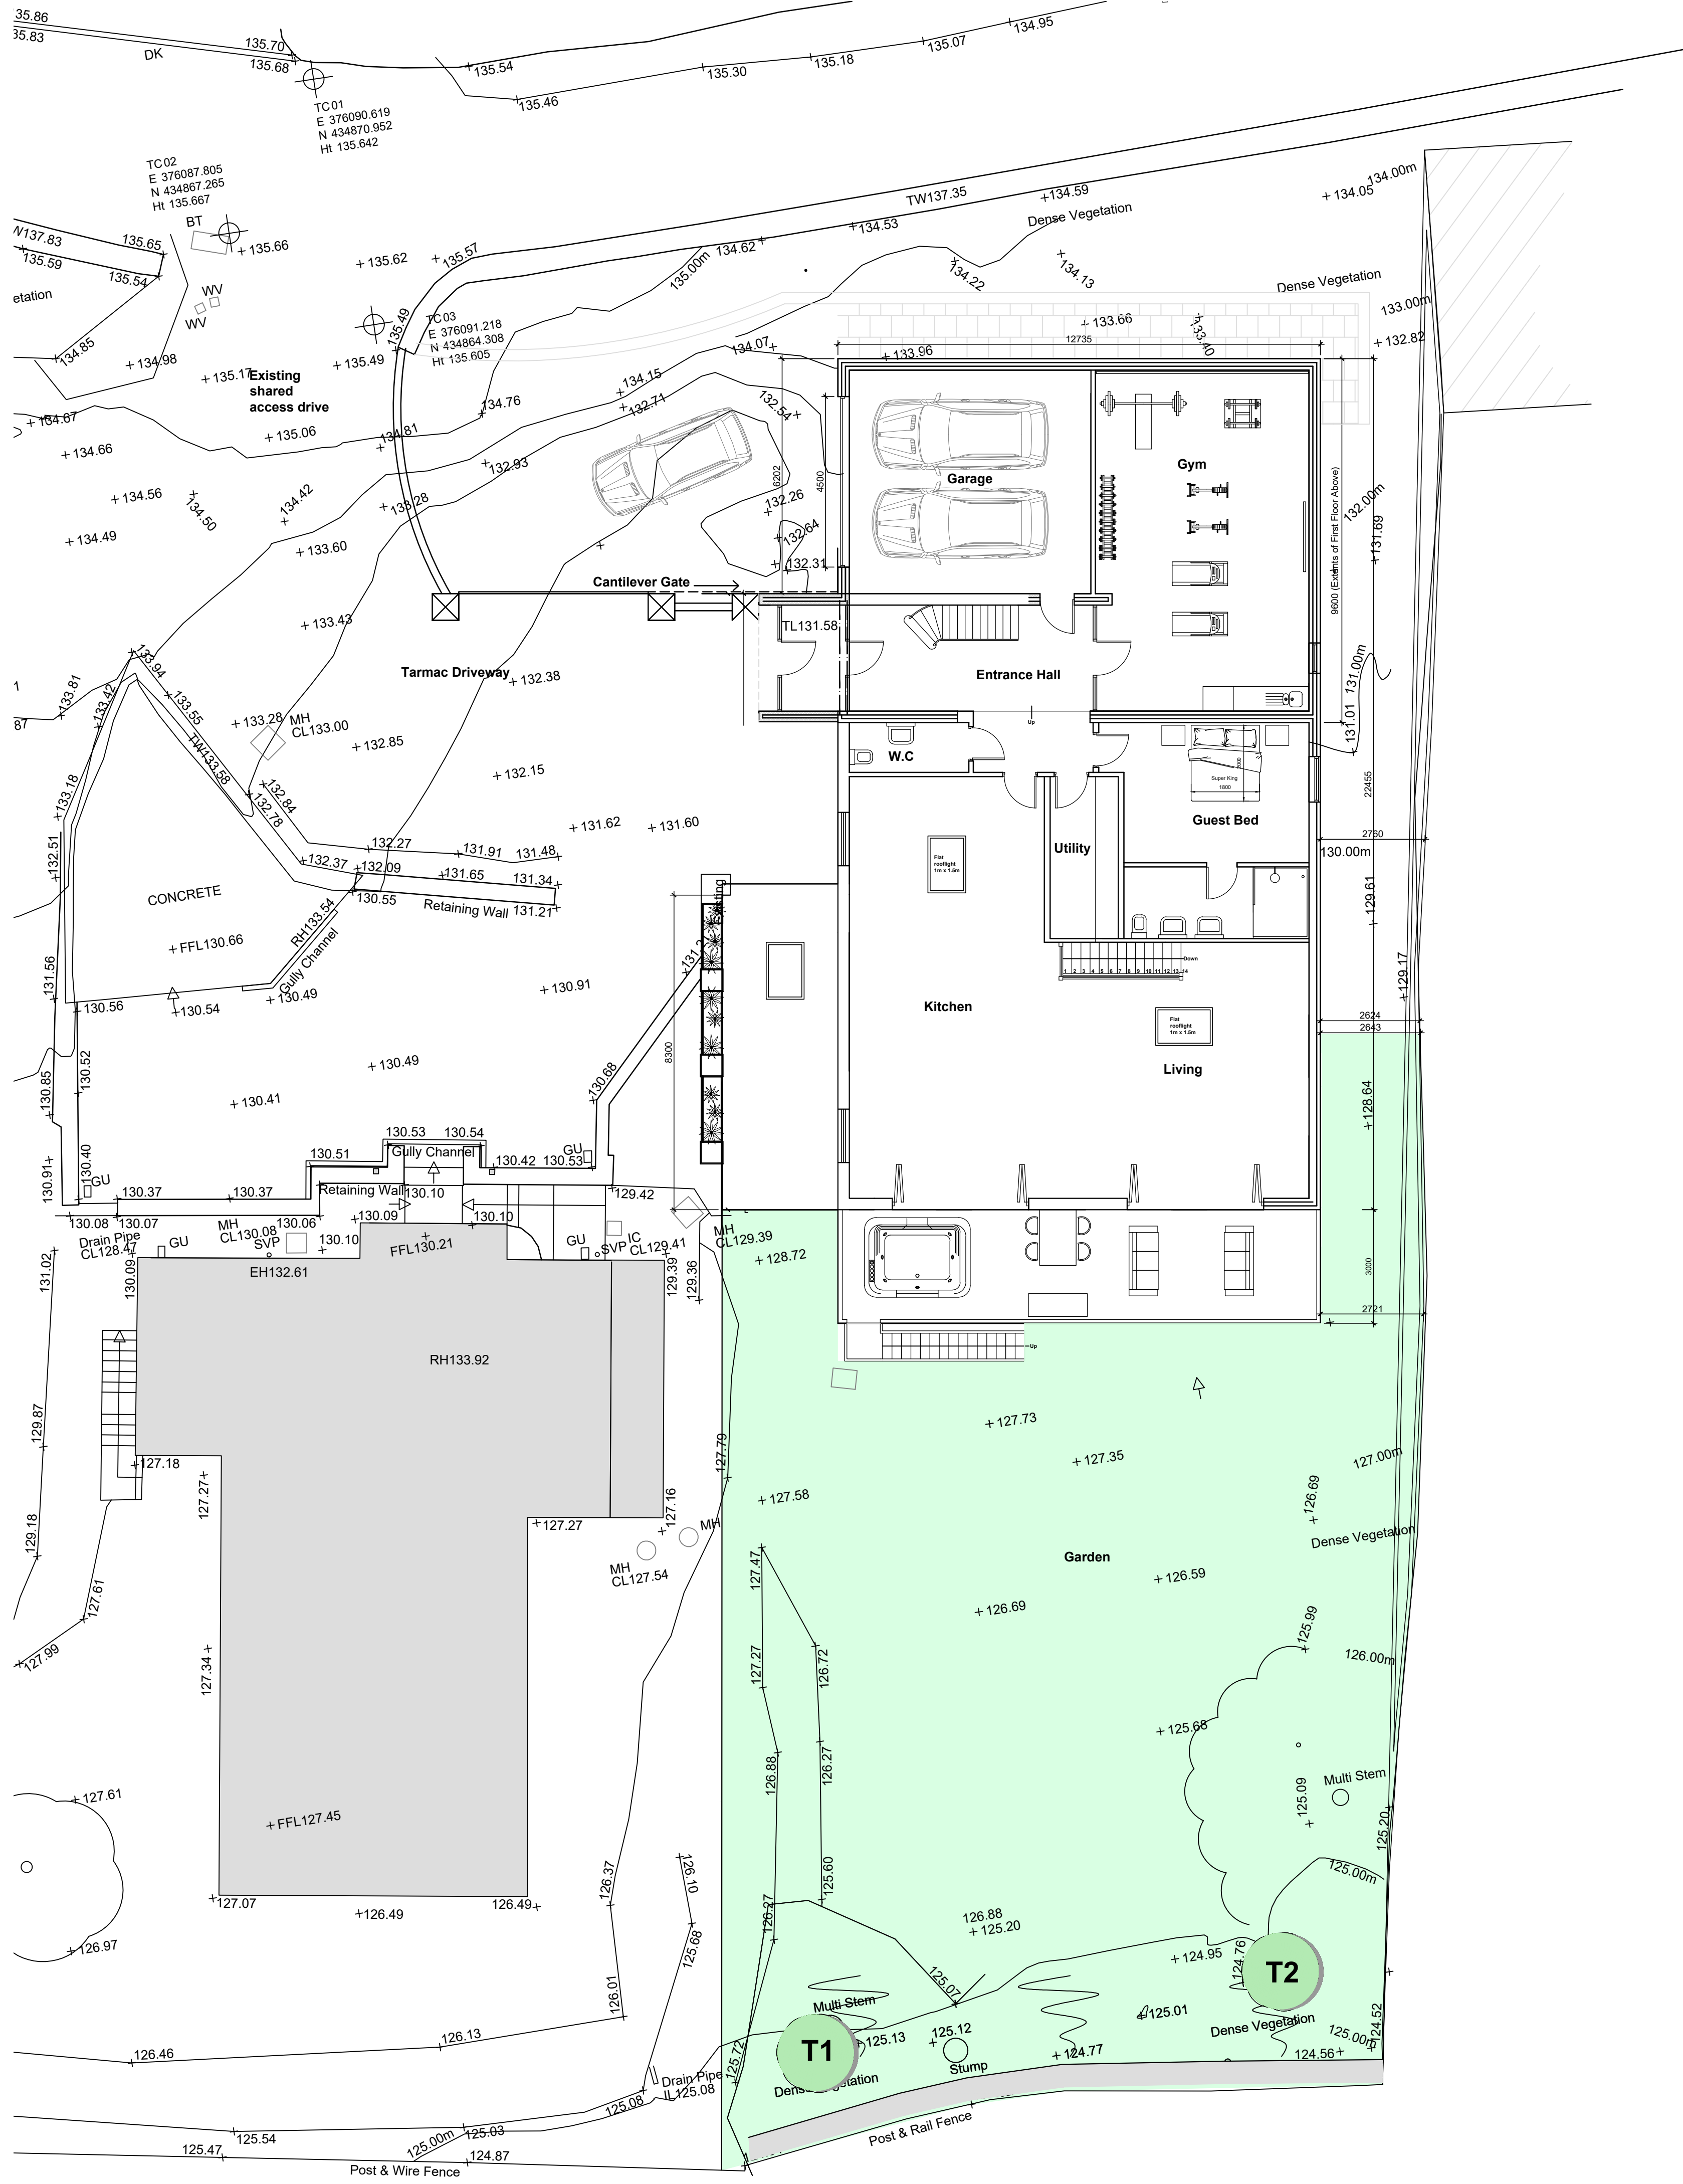

Rev I: Opaque glass to sides of balcony/terrace, railings to rear to remain, external stairs moved to rear (previously on side), 27.07.2025, Craig Harrison
Rev H: Updated to As Built (in progress), 08.12.2025, Craig Harrison

Client
Mr John Houston

Job Title
Proposed Alterations to
8 Hammond Drive
Read

Drawing Title
Proposed Site Plan

Scale
1:100 @ A1

Date
March 2021

Drawn
Craig Harrison

spa

SUNDERLAND PEACOCK ARCHITECTS
SUNDERLAND PEACOCK & ASSOCIATES LTD.
HAZELMERE, PRALICO ROAD, CLITHEROE
LANCASHIRE, BB7 2AG
T 01200 423178 F 01200 427328
E info@sunderlandpeacock.com
www.sunderlandpeacock.com



6219 - P03I