






4
EXISTING WEST
1 : 50

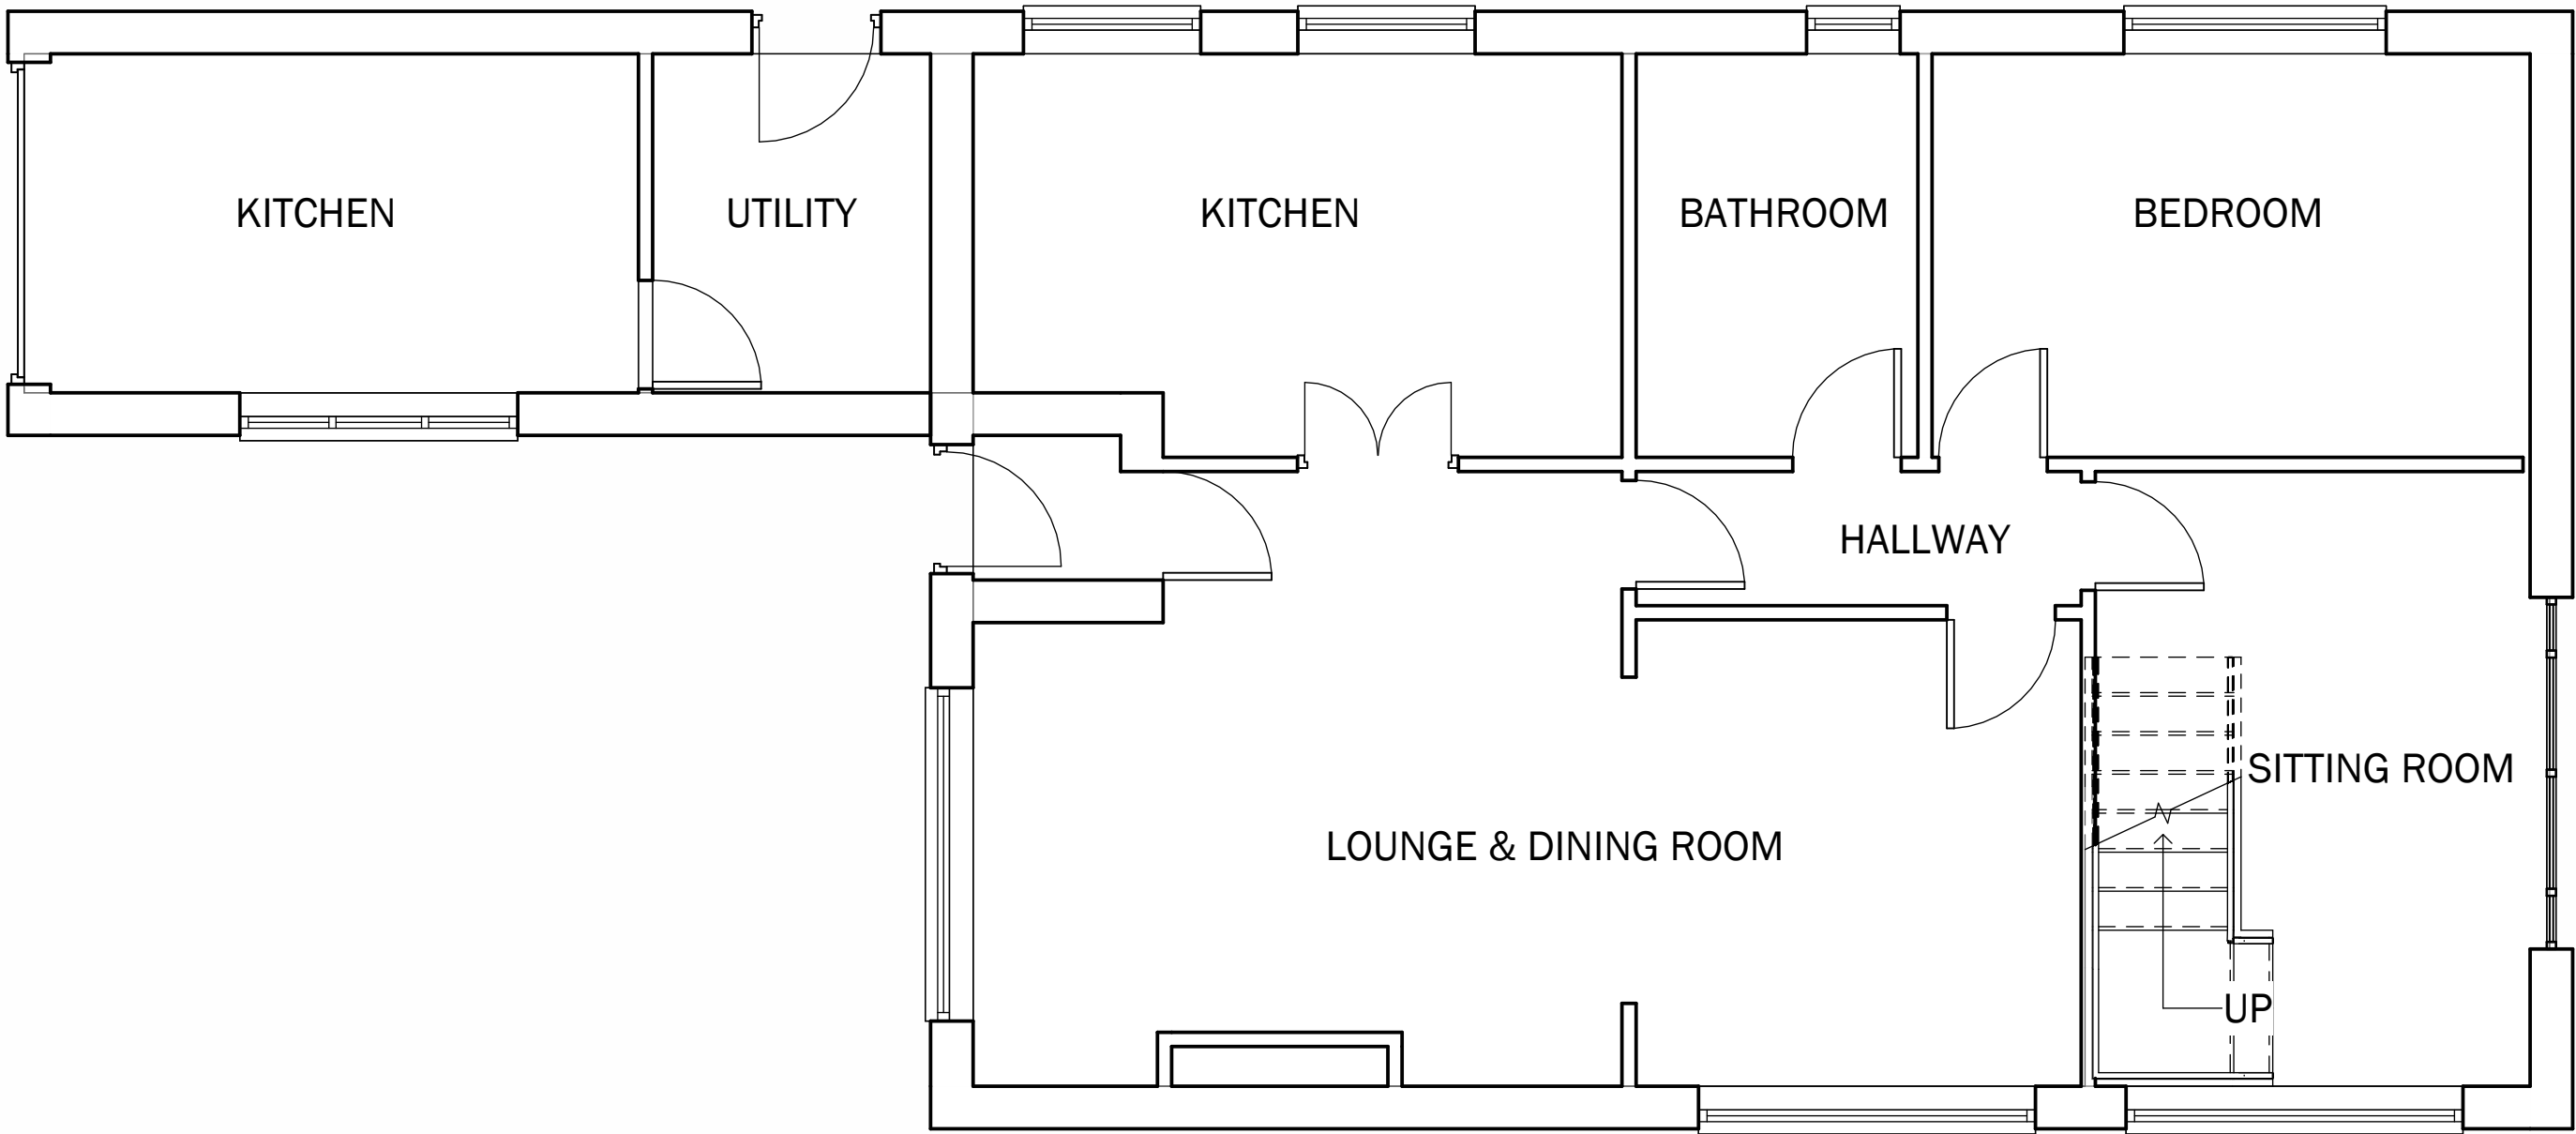


5
0 GROUND FLOOR
1 : 50

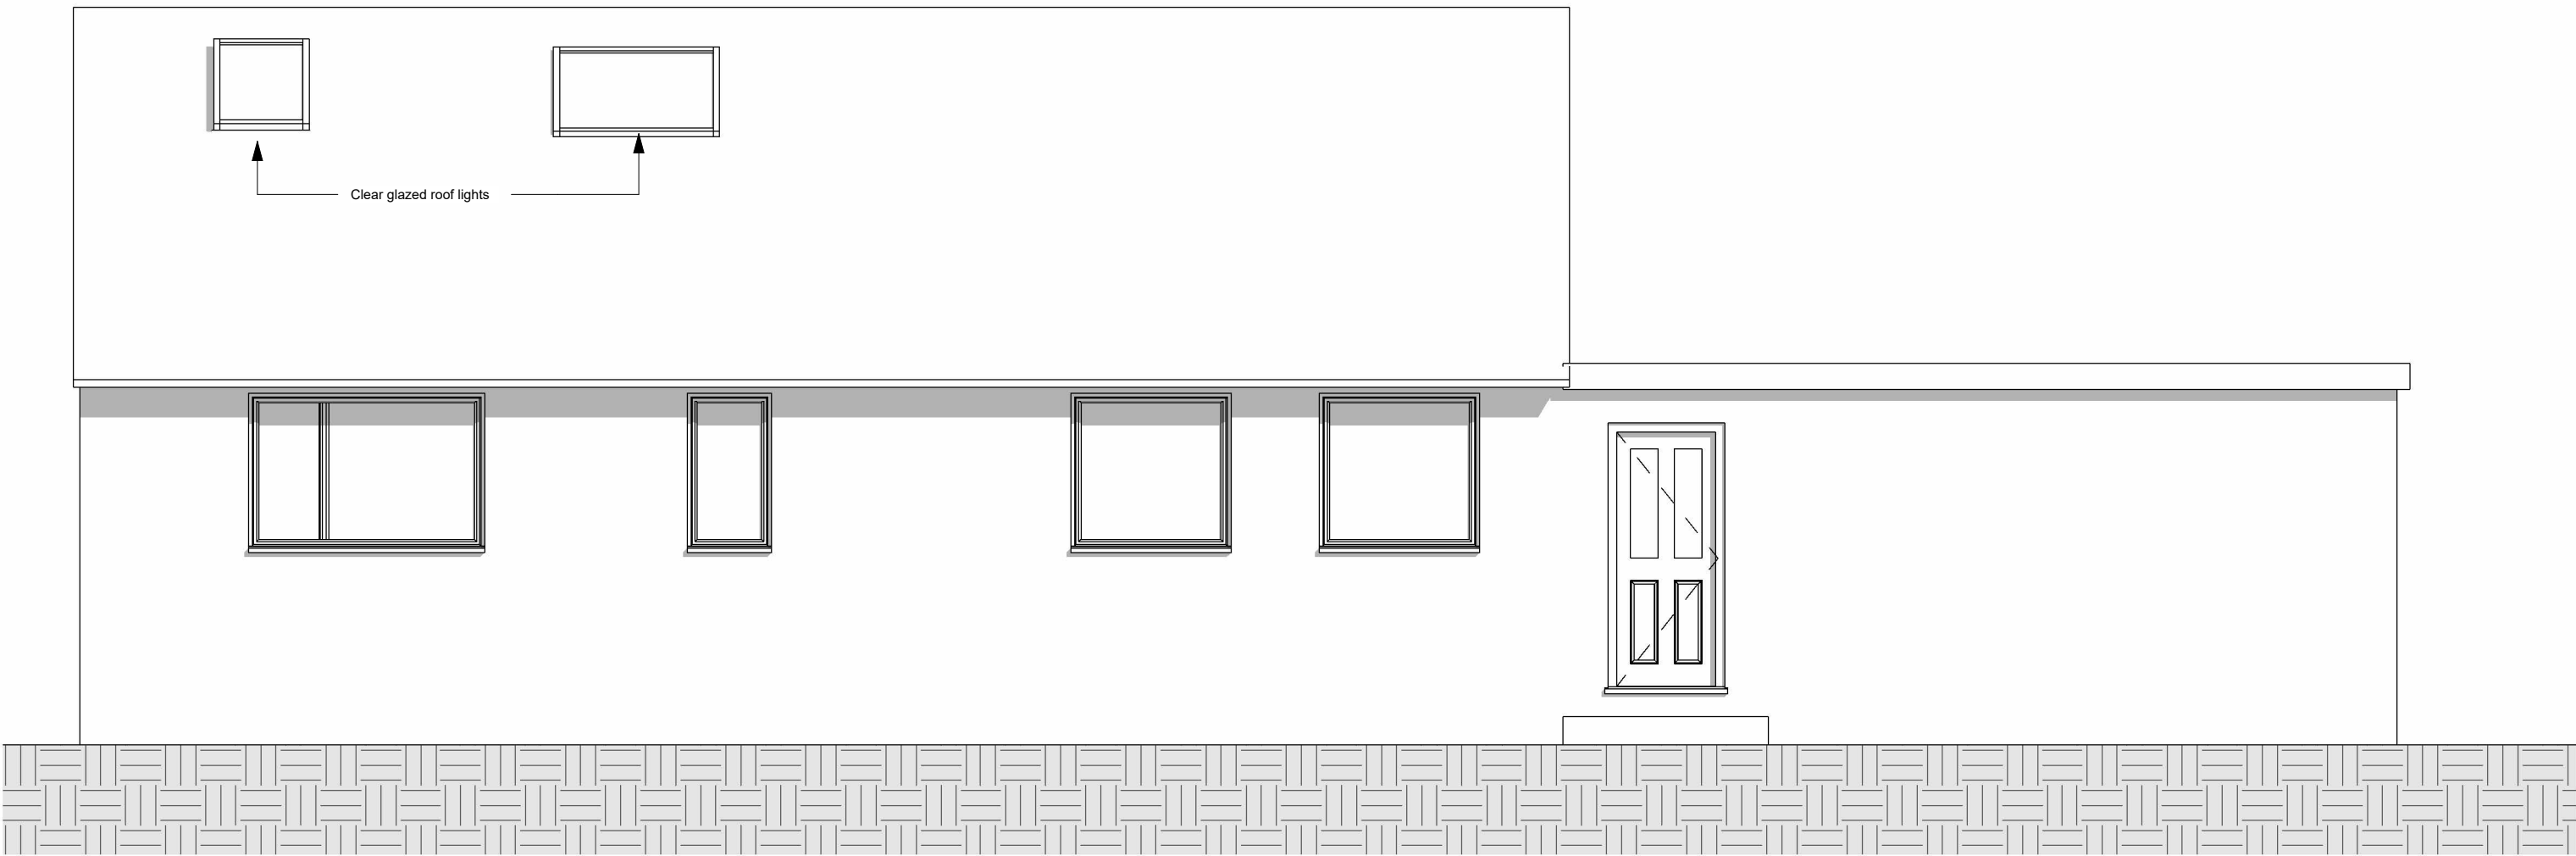


2
EXISTING NORTH
1 : 50

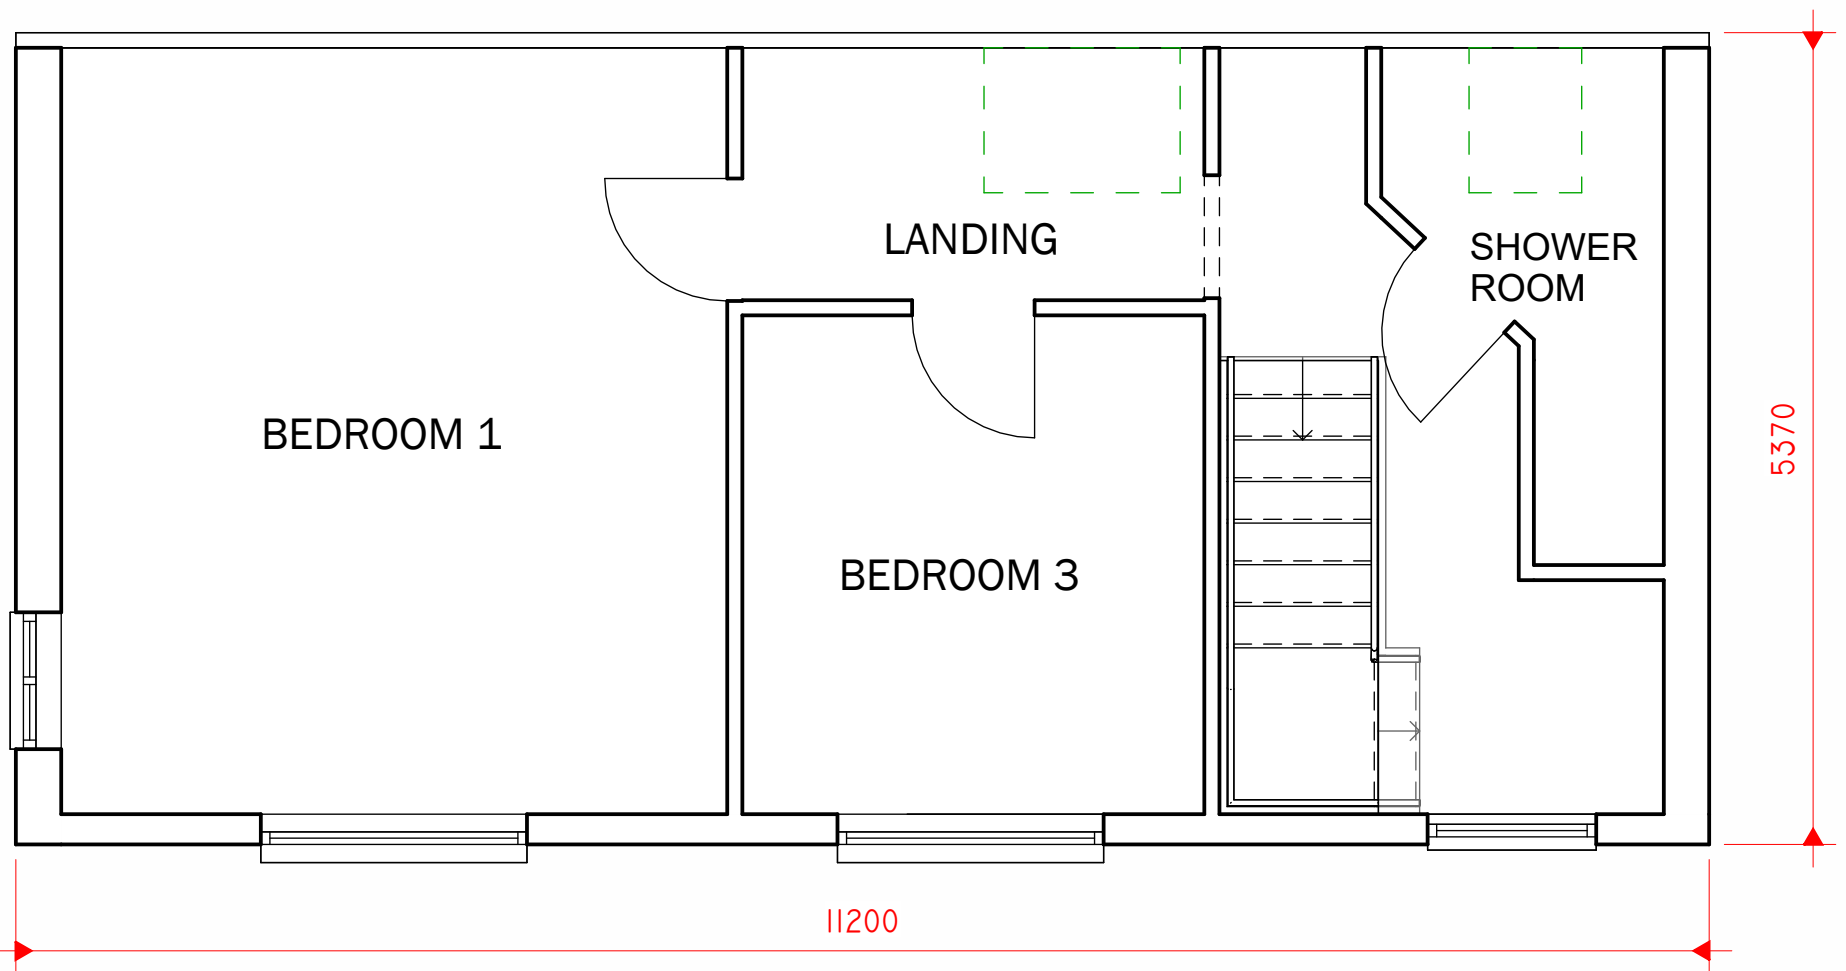

6
1 FIRST FLOOR
1 : 50

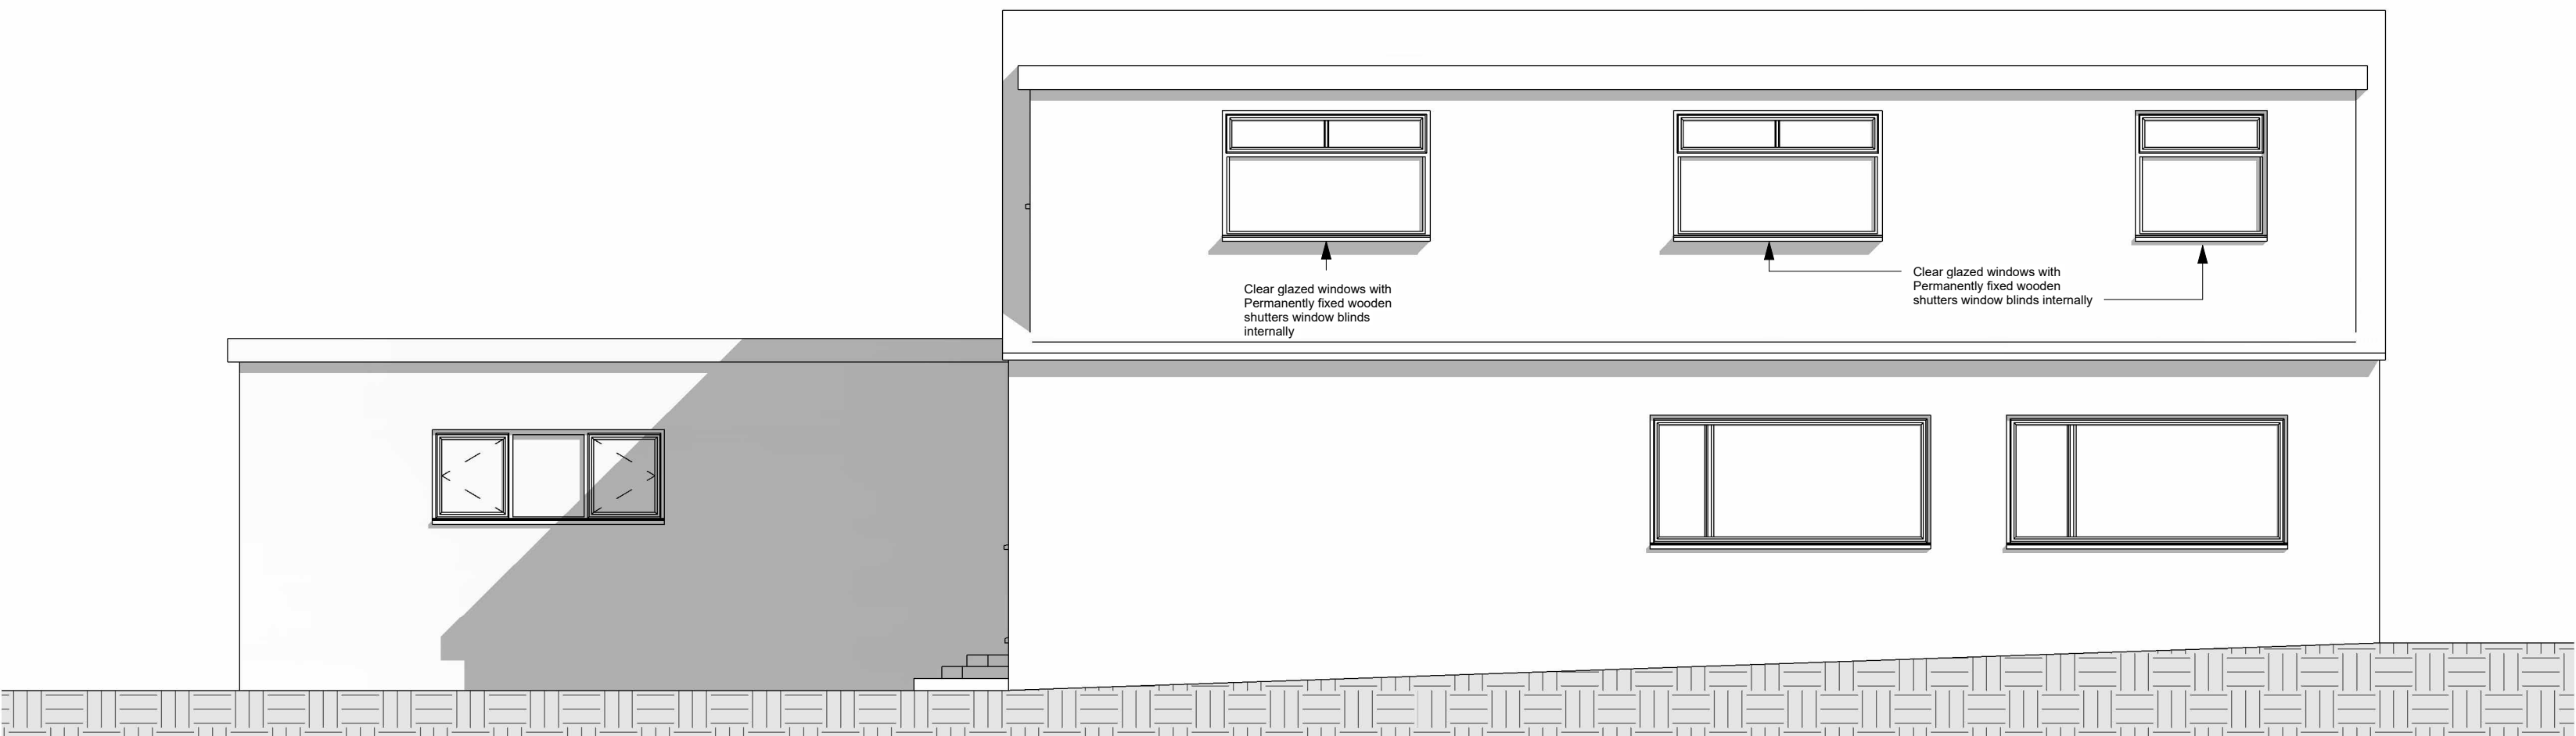

3
EXISTING SOUTH
1 : 50

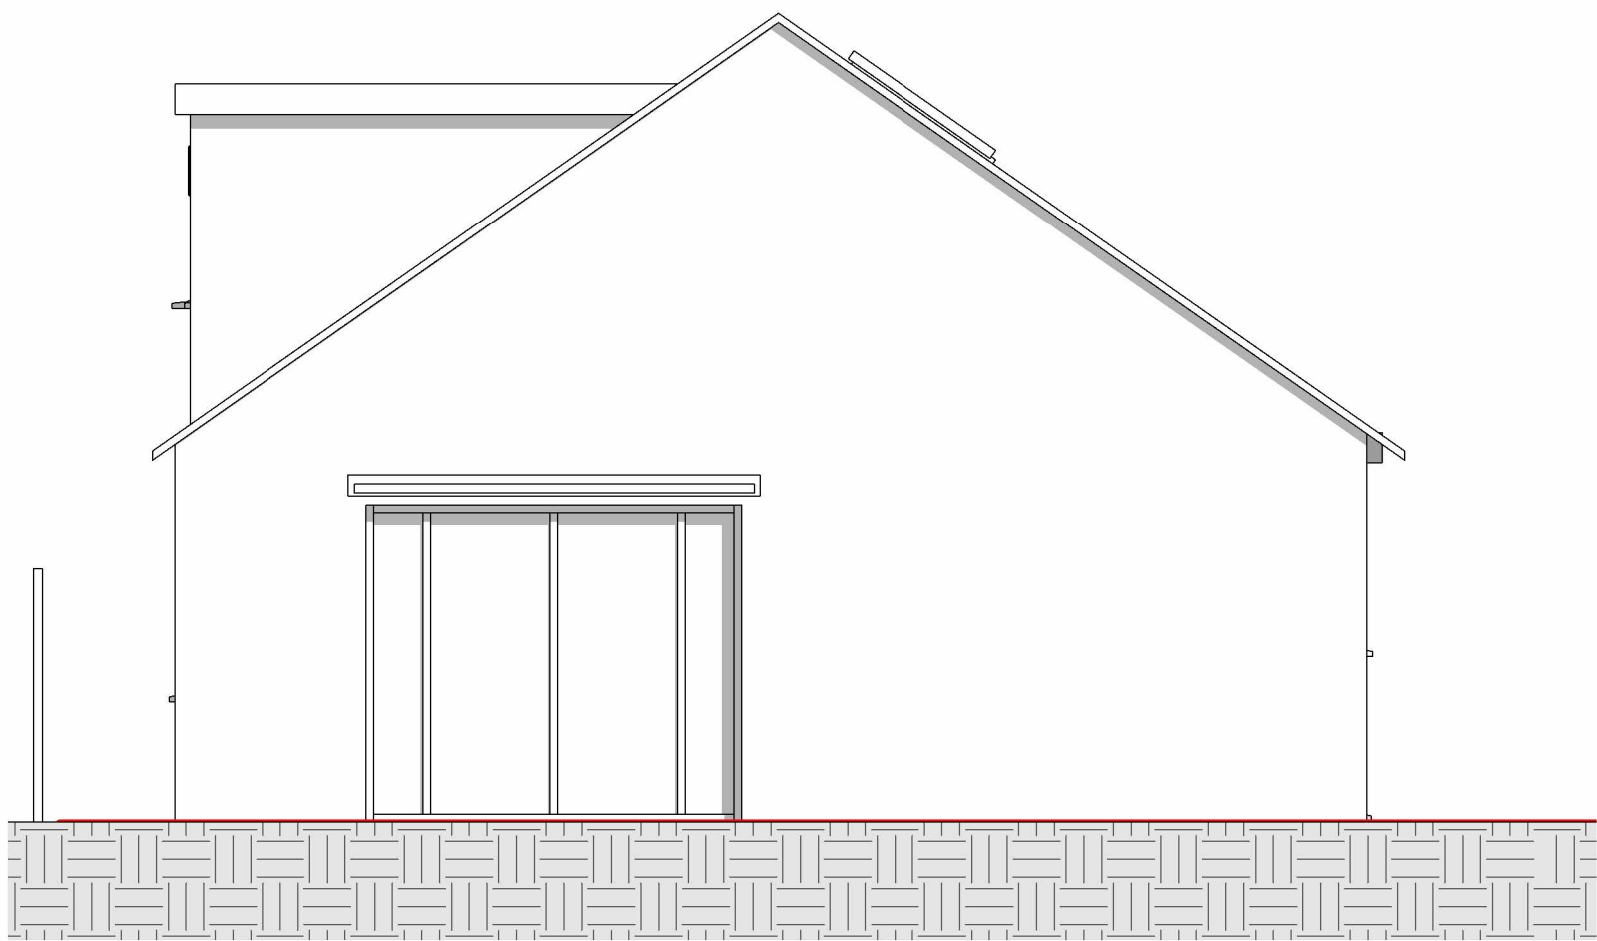

1
EXISTING EAST
1 : 50

Peter Hitchen
Architects

Marathon House
The Sidings Business Park
Whalley, BB7 9SE

01254 823 885

www.peterhitchenarchitects.co.uk

NOTES:

No.	Description	Date

CLIENT: Mark Woodcock
29 Chatbrun Park Drive
Clitheroe
BB7 2AY

PROJECT: As- Built Dormer Windows and
Rooflights

SHEET: AS-BUILT FLOOR PLANS
AND ELEVATIONS

Project number PHA/1161

Date 11/08/2026

Drawn by DH

Checked by PH

A2.1

Scale 1 : 50

Sheet size A1