


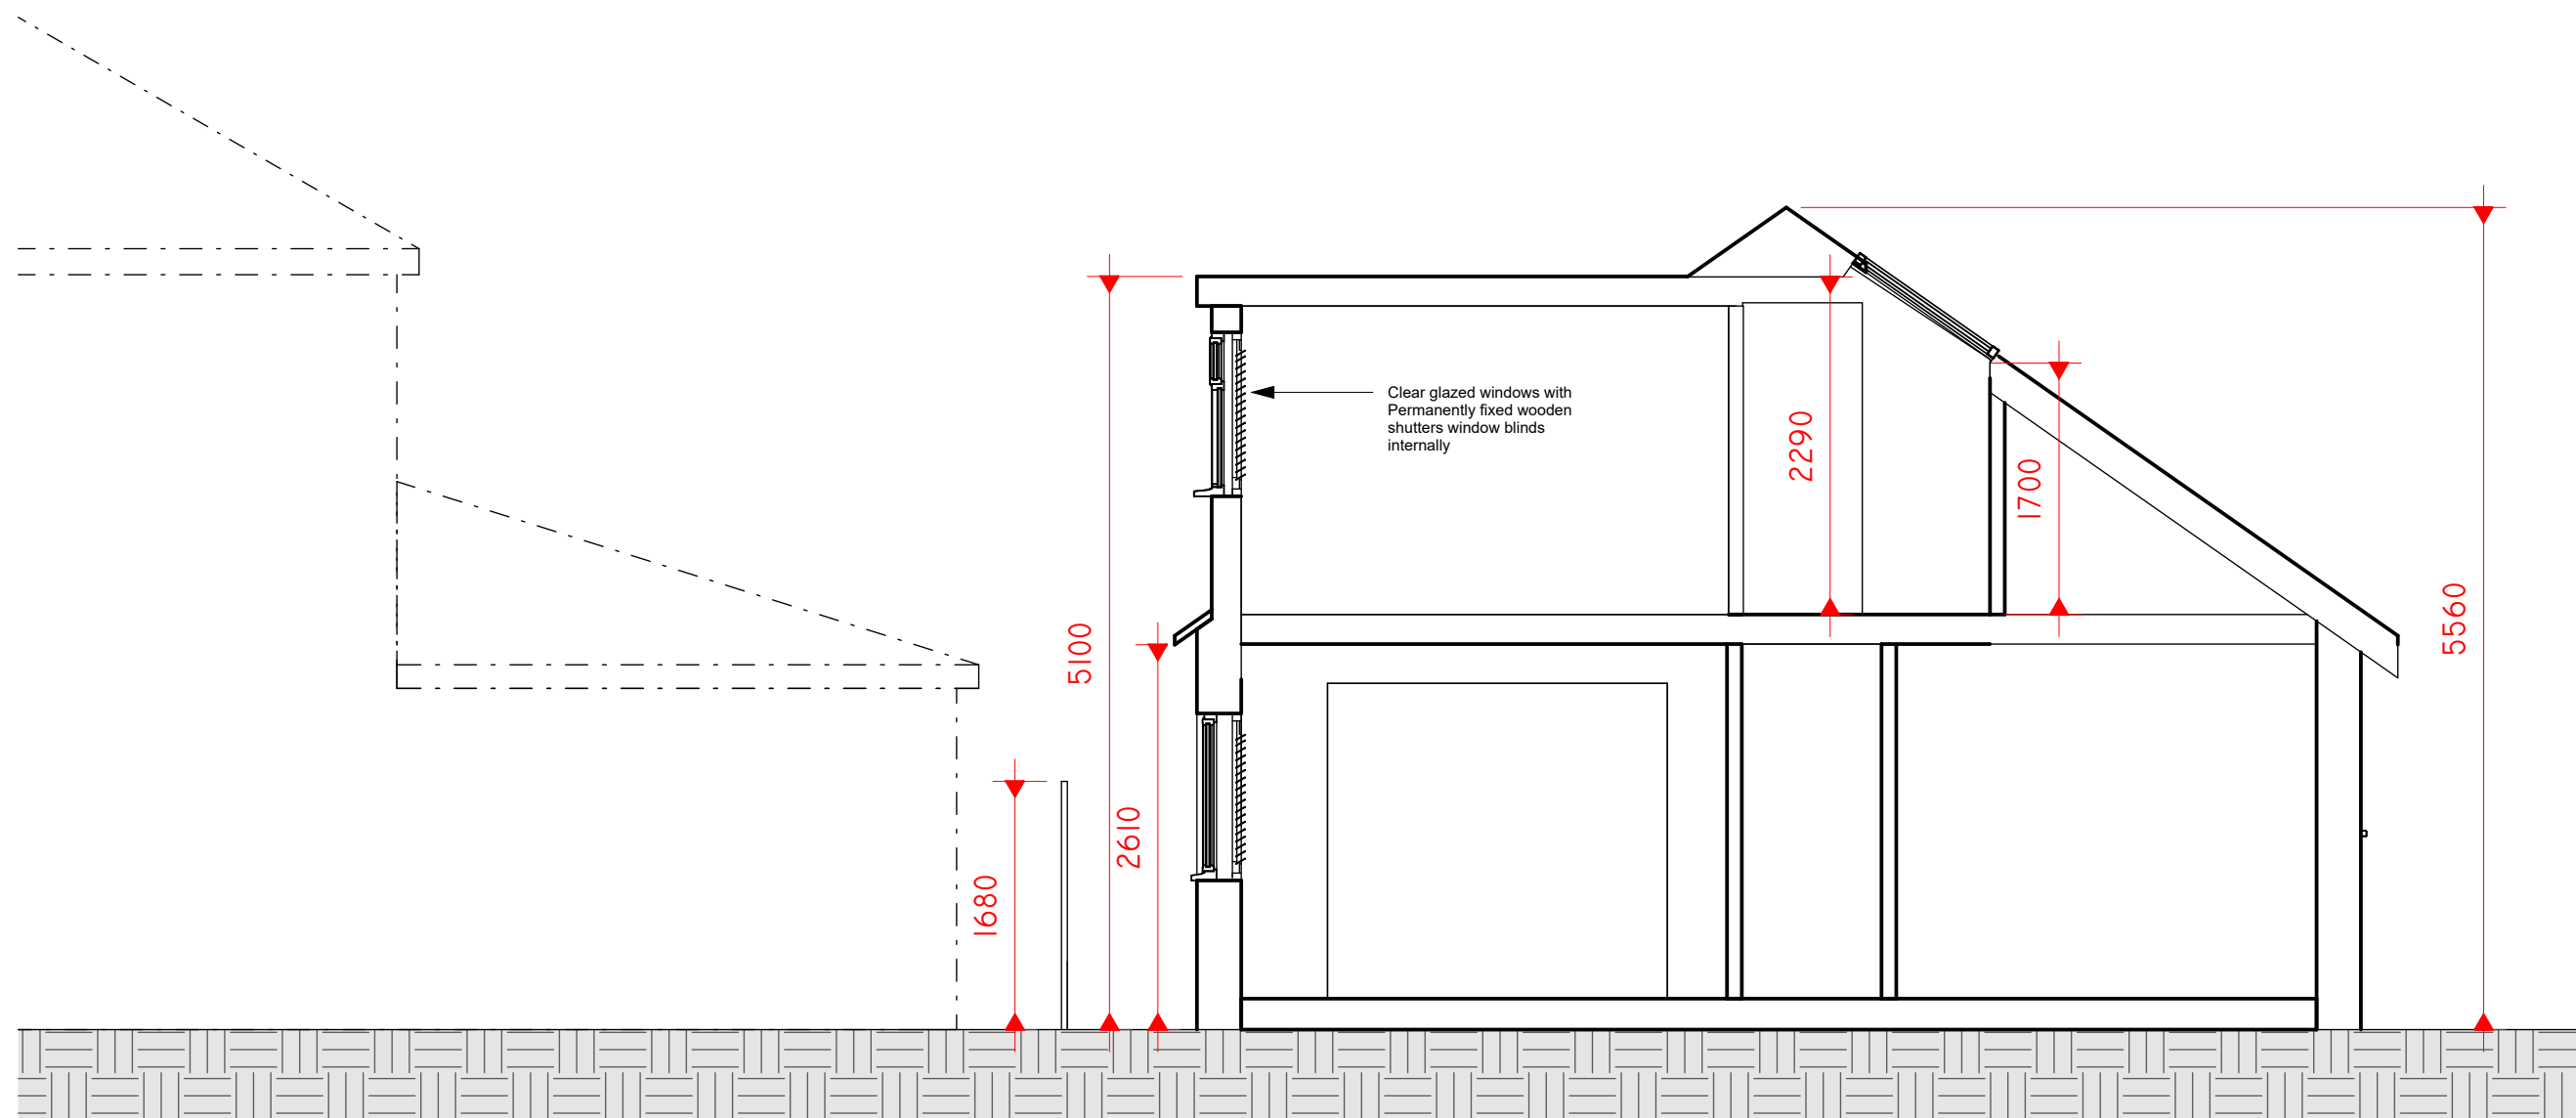

1

Section 1

1 : 50

|  |
|--|
|  |
|  |
| No. | Description | Date |
|-----|-------------|------|
|     |             |      |
|     |             |      |
|                                    |                                                                 |                         |                         |                                    |                                |
|------------------------------------|-----------------------------------------------------------------|-------------------------|-------------------------|------------------------------------|--------------------------------|
| <div>Peter HitchenArchitects</div> | PROJECT ADDRESS: 29 Chatbrun Park Drive<br>Clitheroe<br>BB7 2AY |                         | CLIENT<br>Mark Woodcock |                                    |                                |
|                                    |                                                                 |                         | Date<br>11/08/2026      | Project number<br>PHA/1161         | Scale (@ A3)<br>1 : 50         |
| CODE                               | STATUS                                                          | SUITABILITY DESCRIPTION | PURPOSE OF ISSUE        | SHEET<br>AS-BUILT SECTIONS A3      |                                |
|                                    |                                                                 |                         |                         | Drawn by<br>LW<br>Checked by<br>PH | DRAWING NUMBER<br>A2.3.<br>REV |