



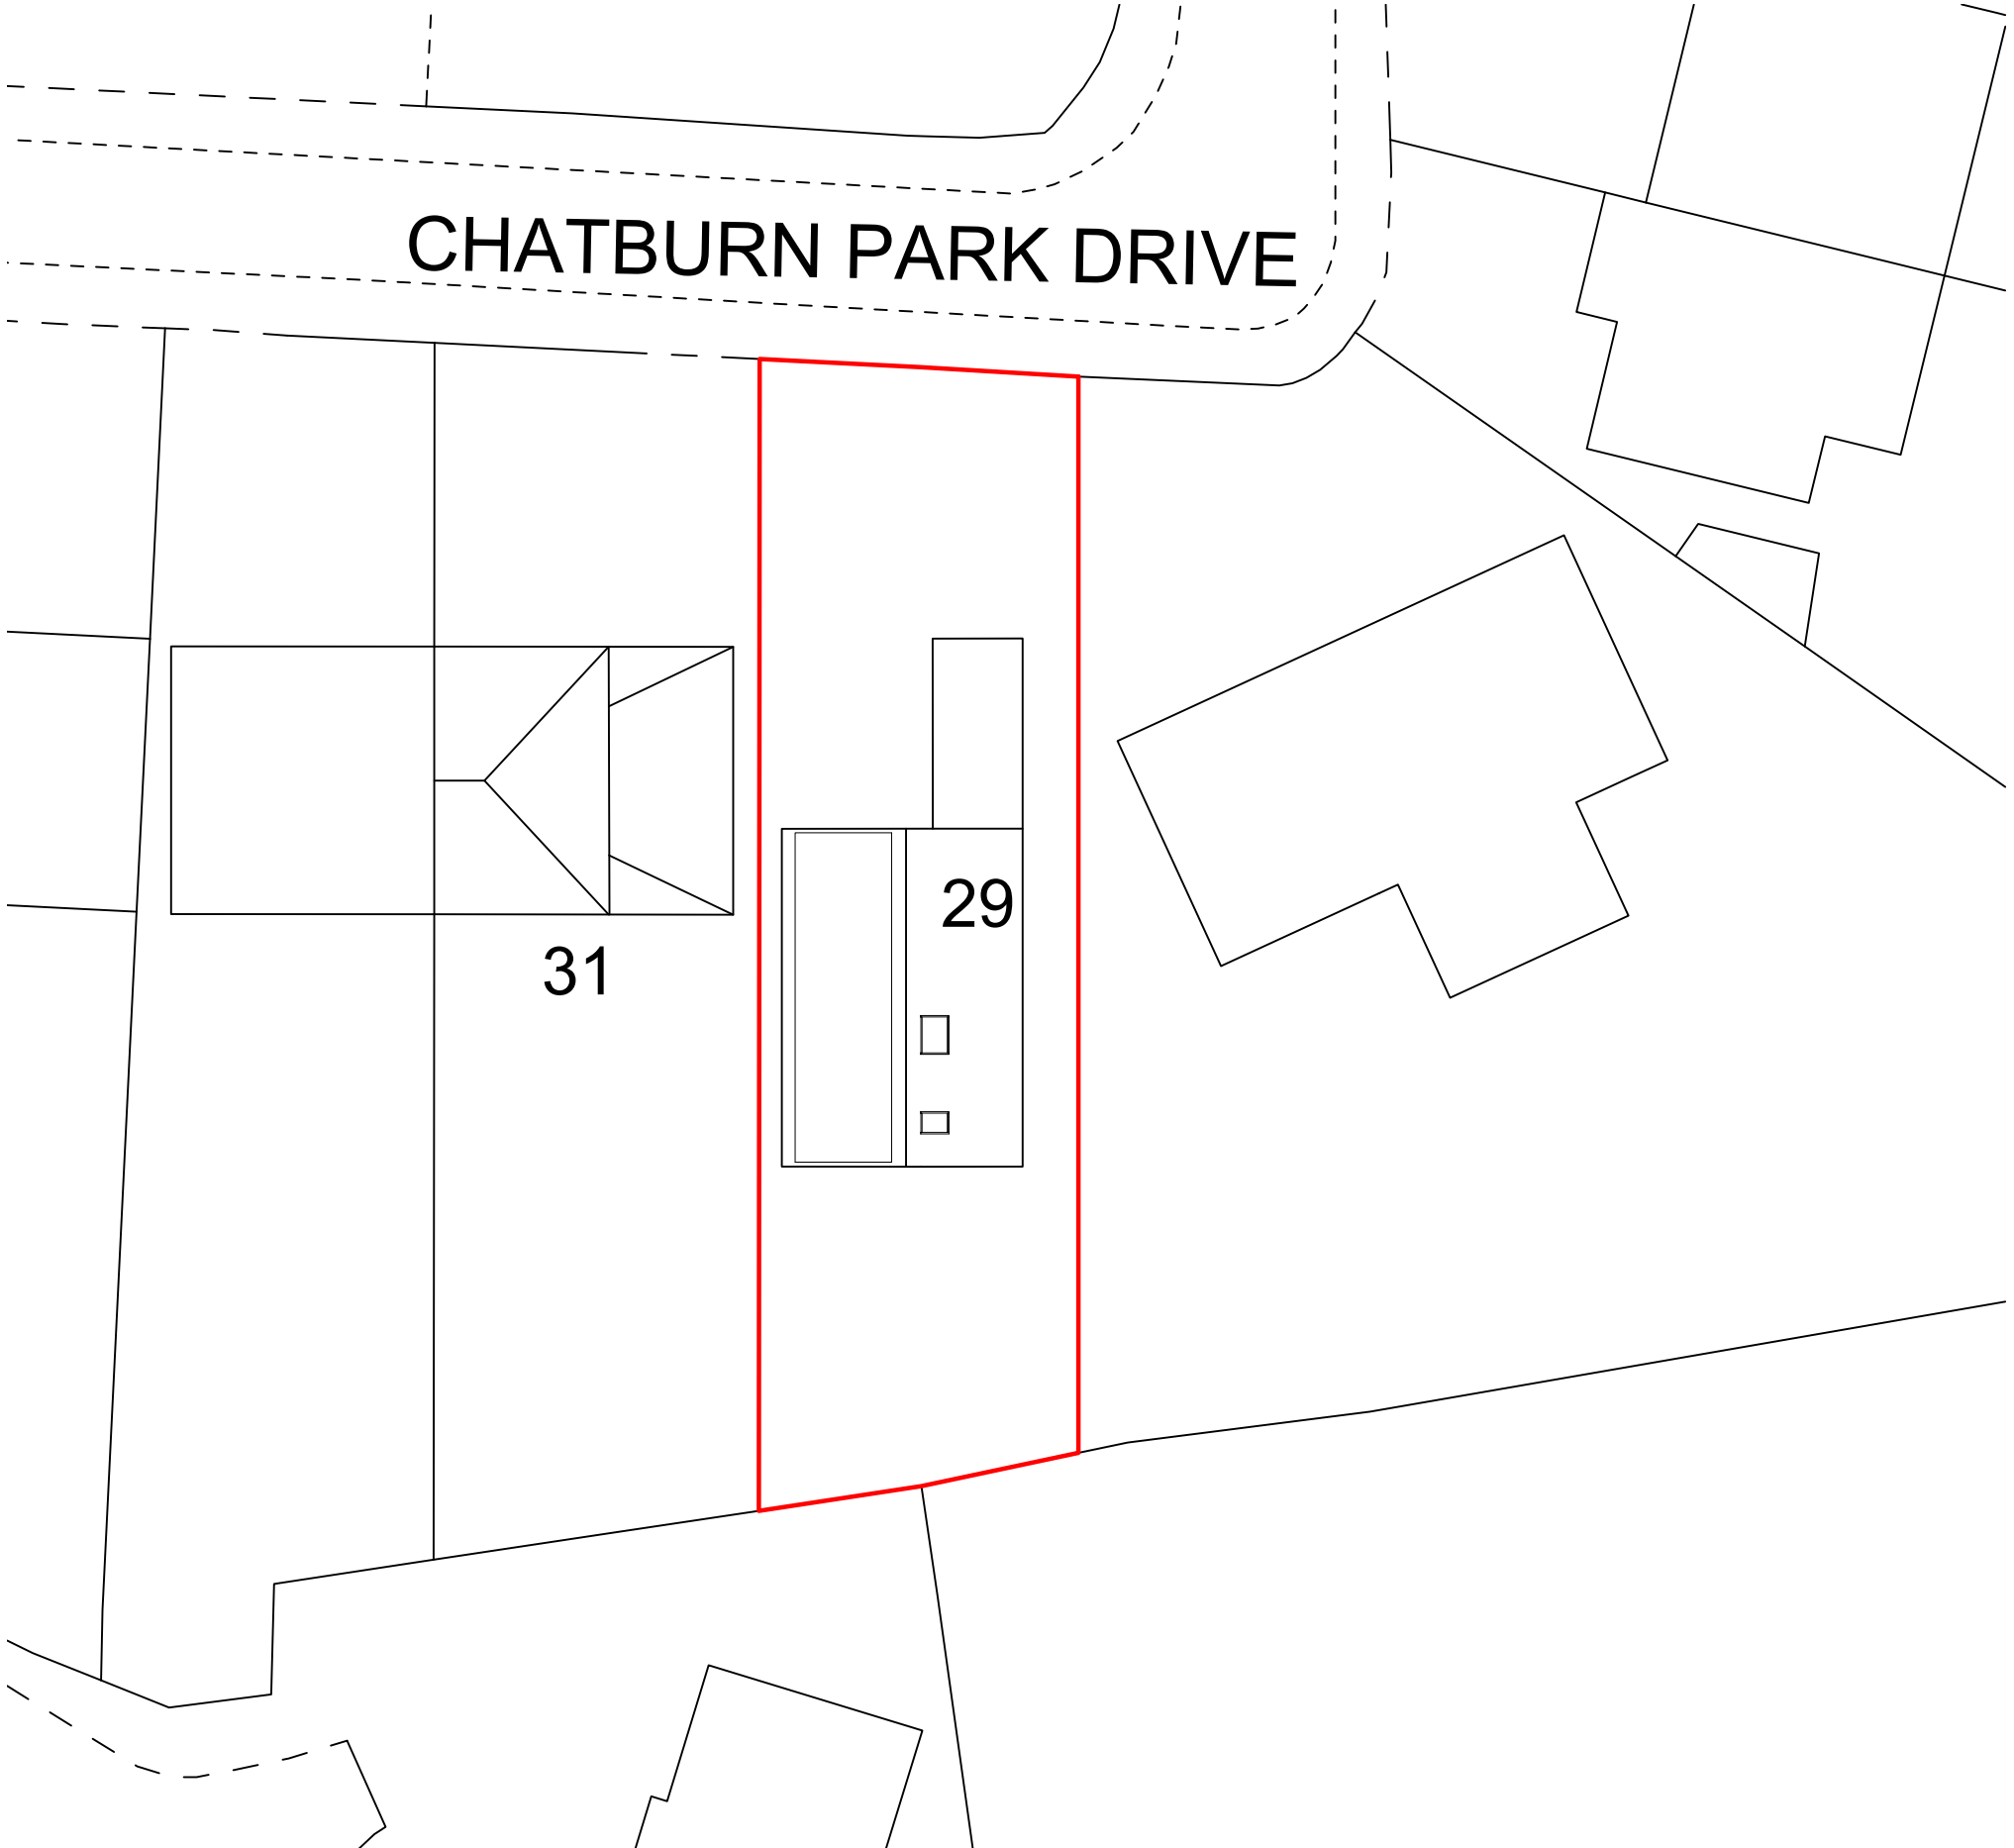

CHATBURN PARK DRIVE

31

29

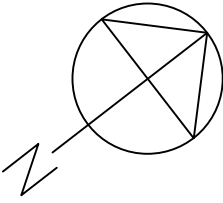

Notes.		
notes.		
Project .		
As-Built Dormer Windows and rooflights @ 29 Chatburn Park Drive, Clitheroe BB7 2AY		
Client.		
Mark Woodcock		
drawing title.		
As-Built SITE PLAN		
status.		
scale.		
1:250 AT A3		
Drawn by:	DH	checked PH
Date.		
11/08/26		
project no.	dra. no.	rev.
PHA/1161	A2.2	-