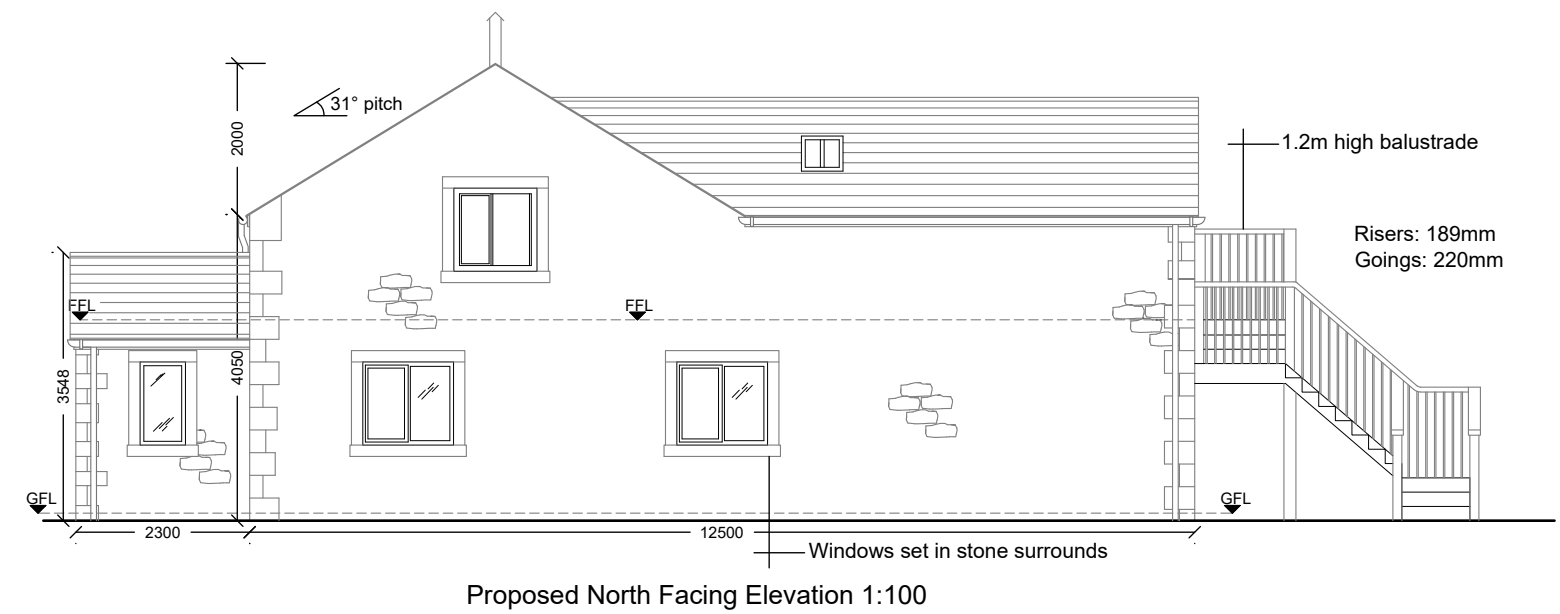
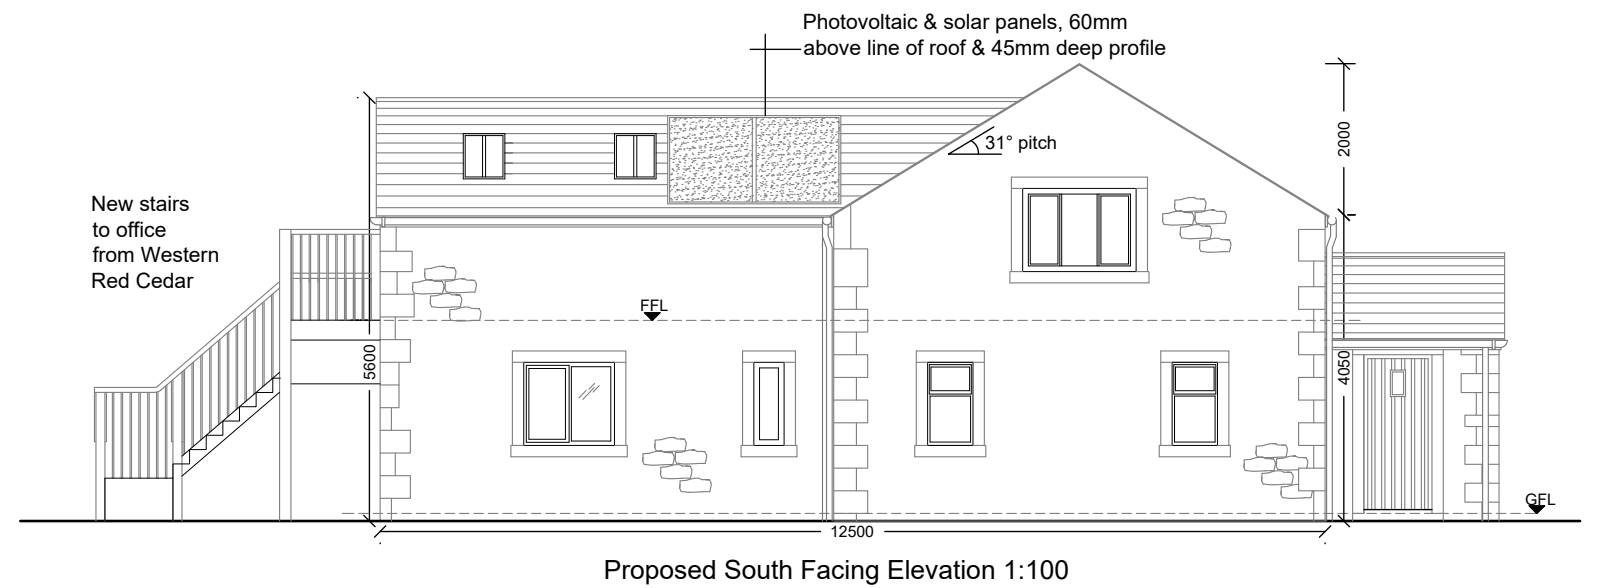
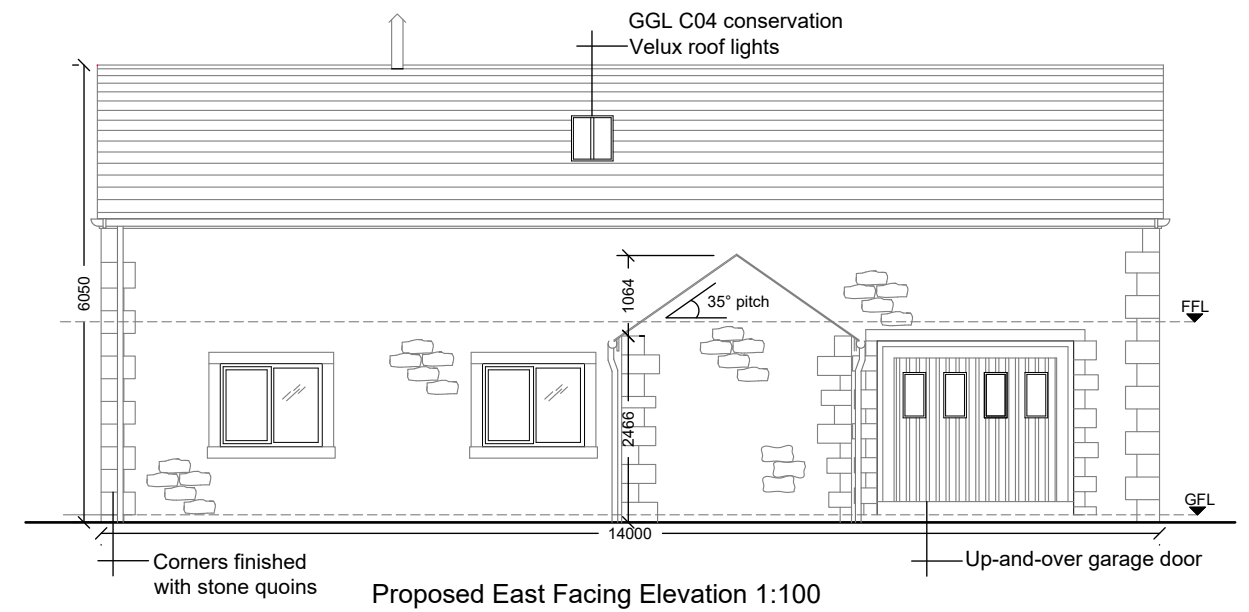
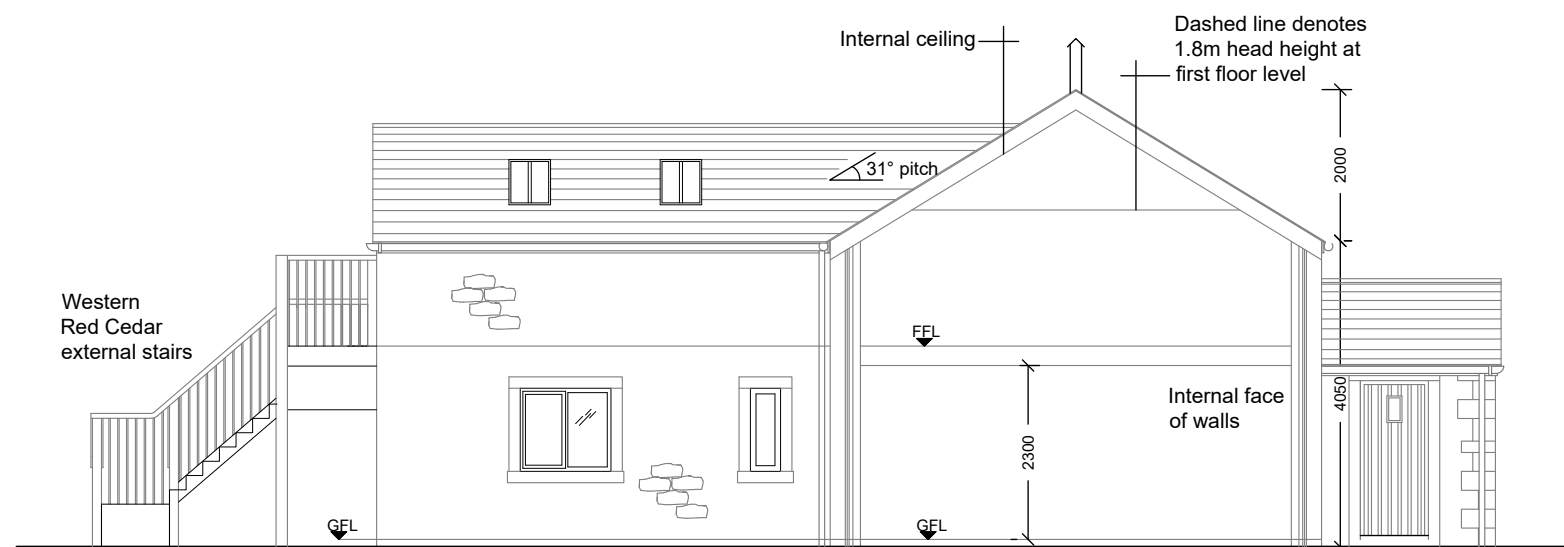
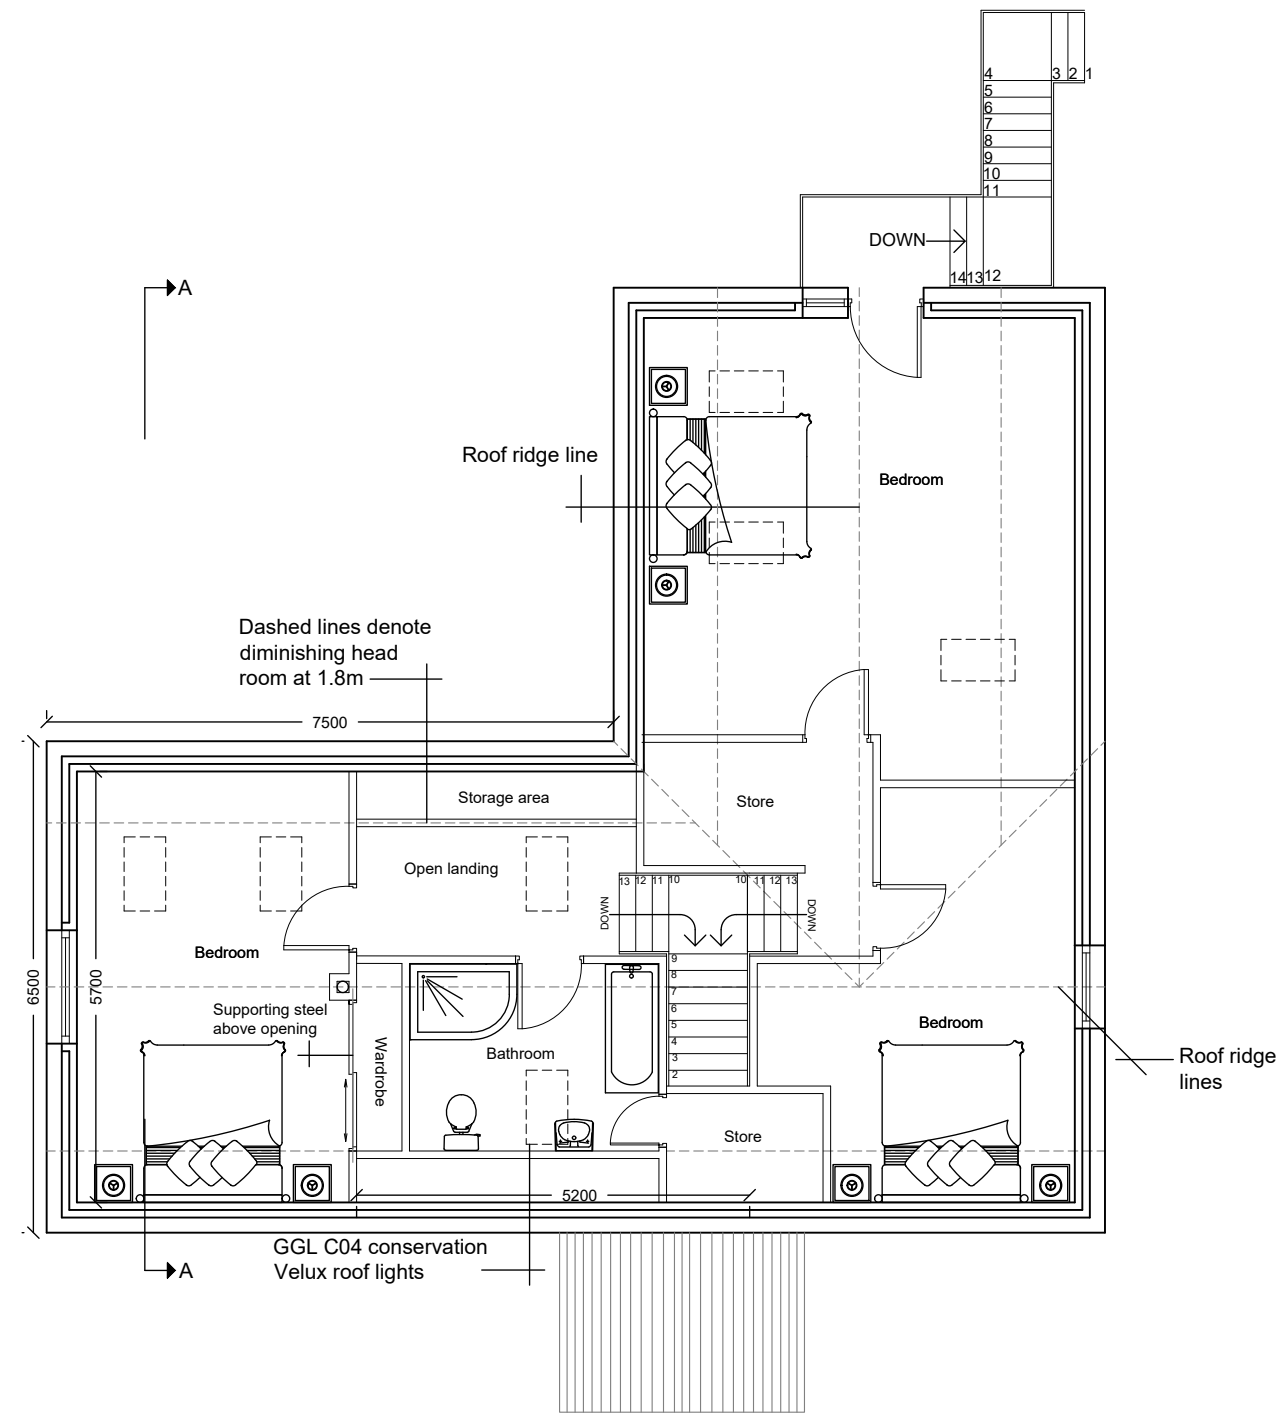
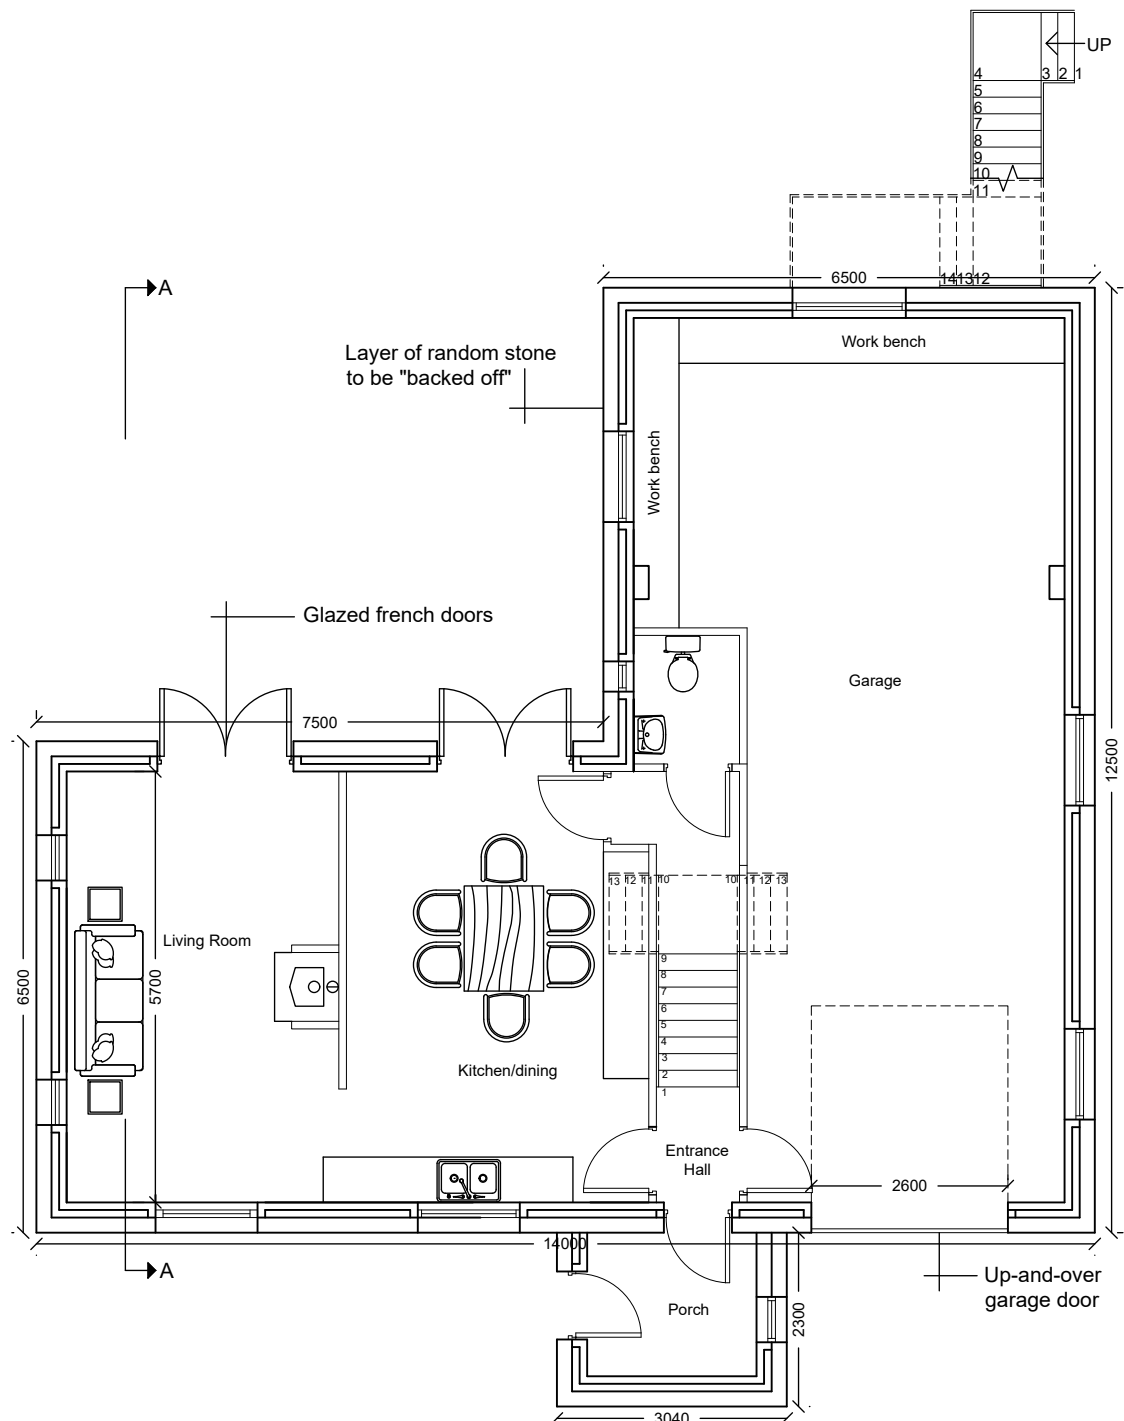


ORIGINAL DRAWINGS PRODUCED BY GARY HOERTY ASSOCIATES. DRAWINGS, NOTES AND DIMENSIONS NOT PRODUCED BY ZMA.