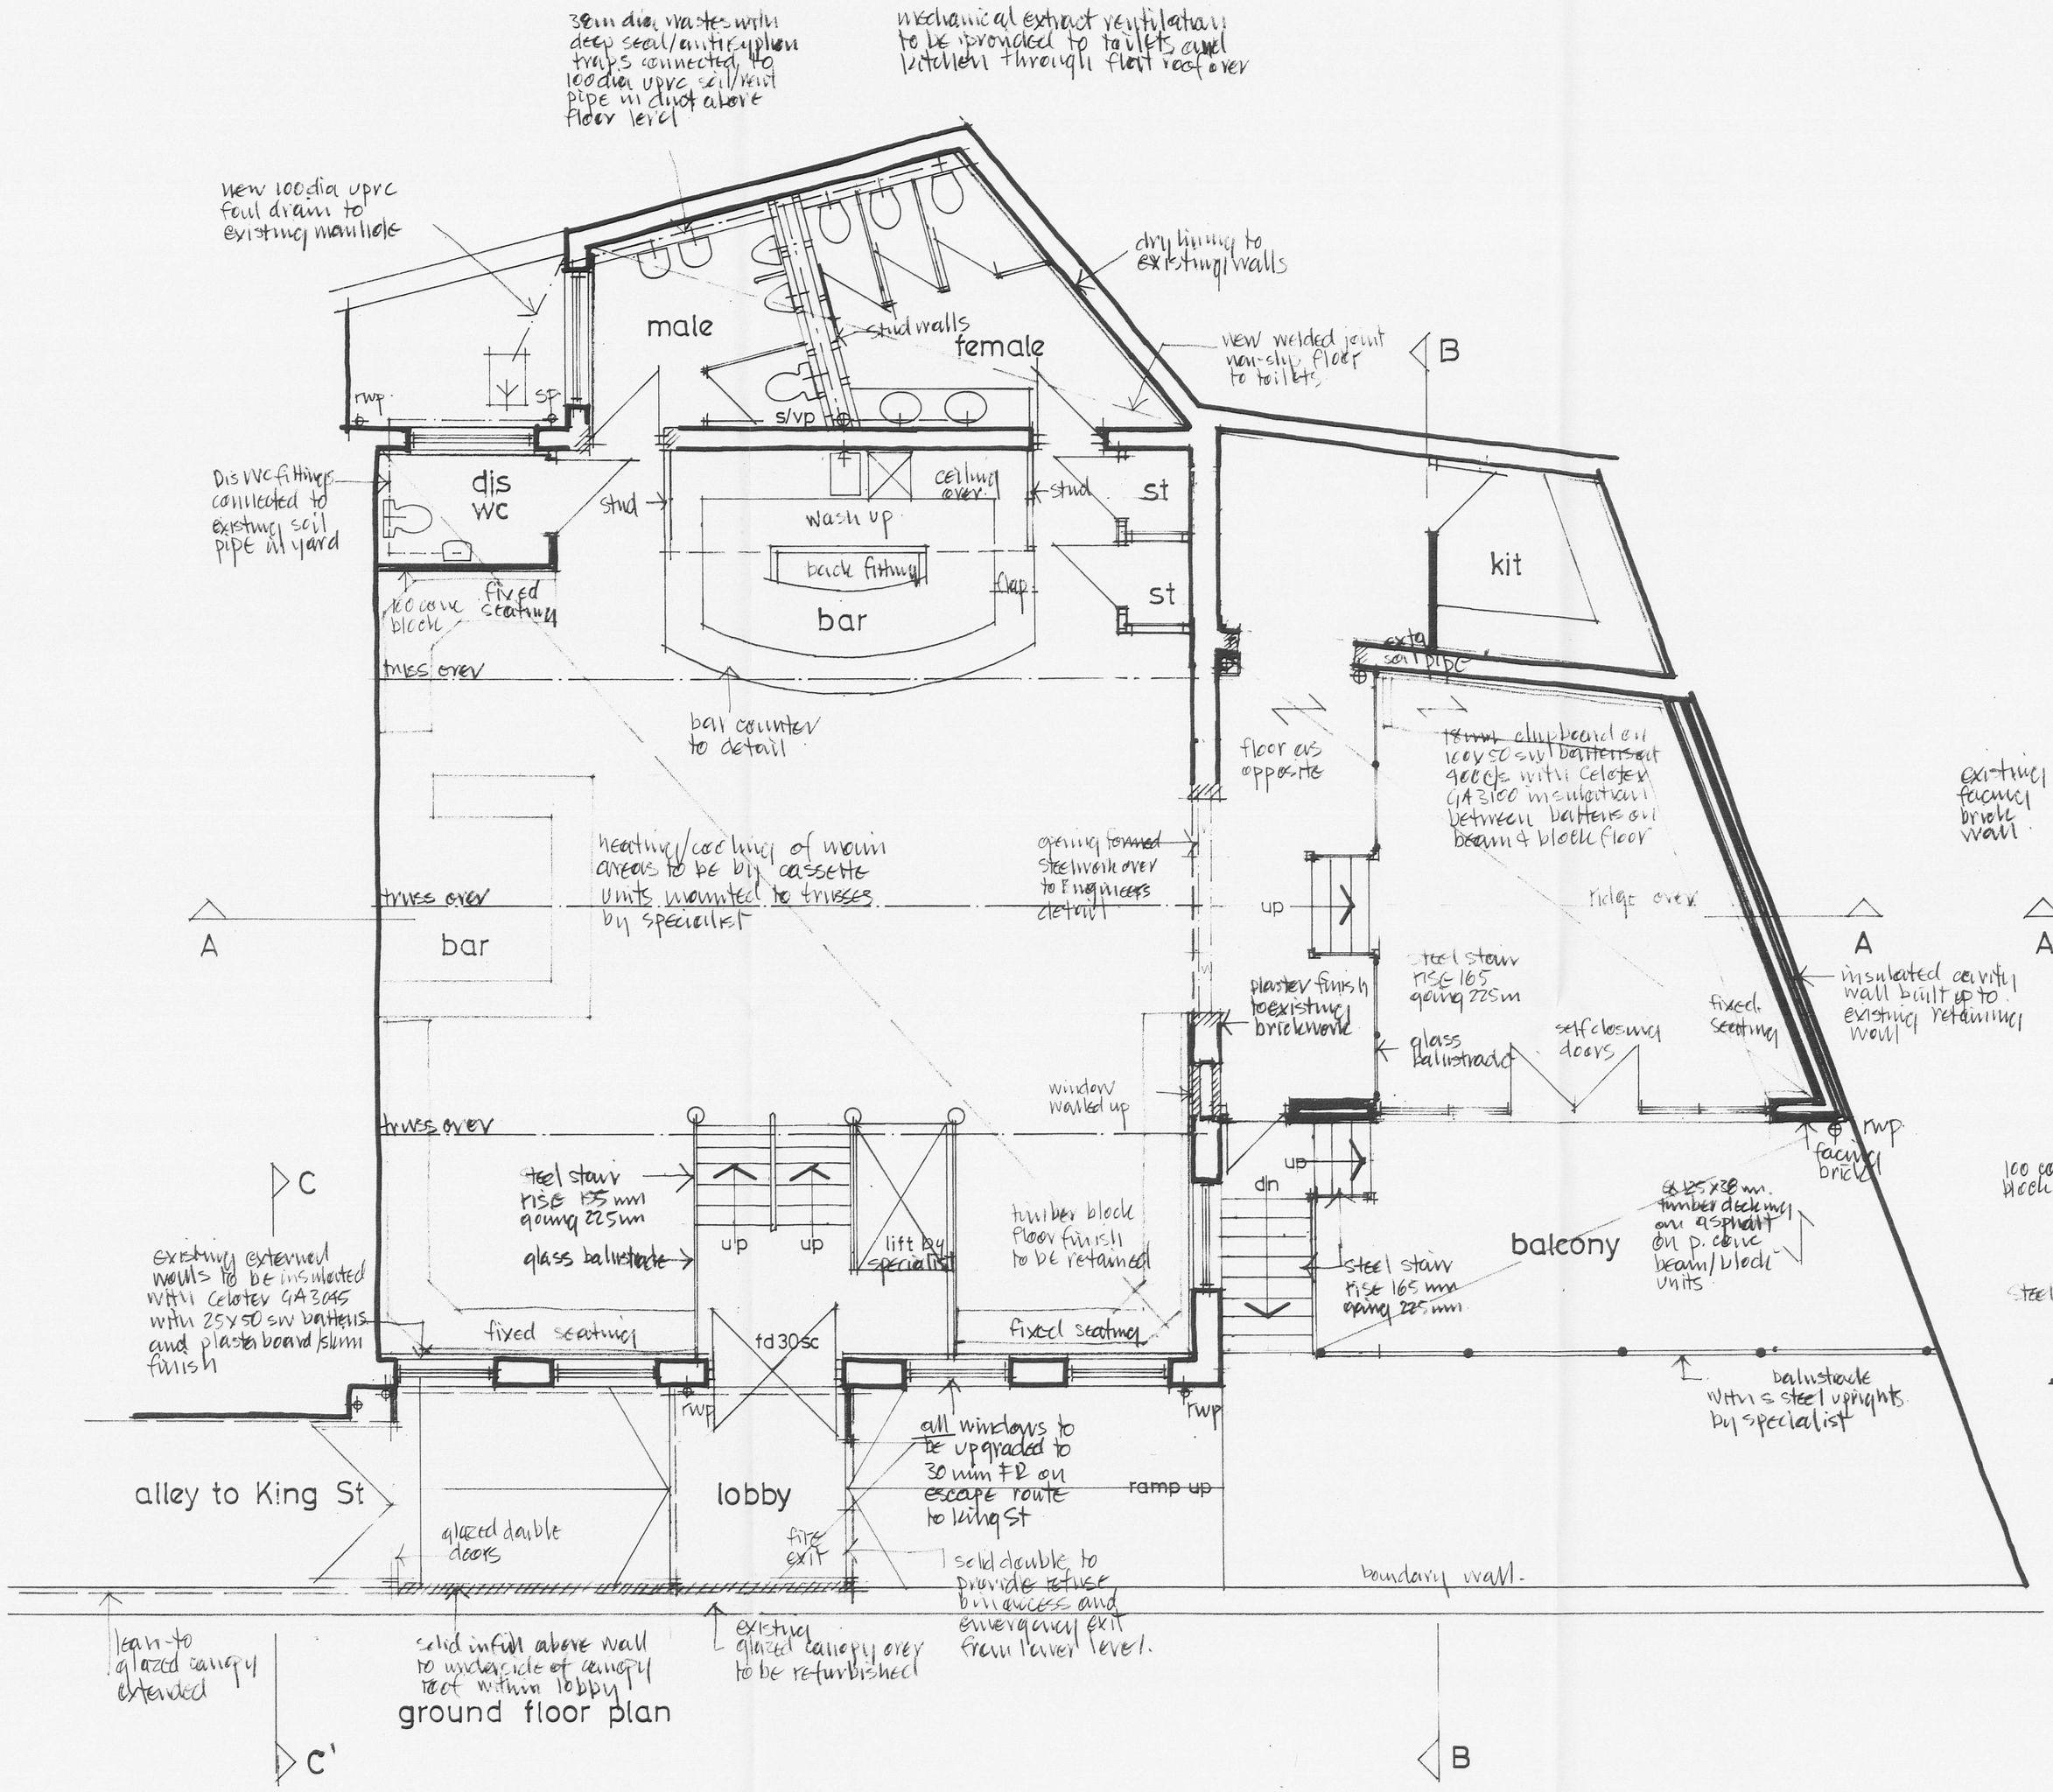



lower ground floor

3200707 21P

| | | |
|---|---|---|
| Revisions | B. Lobby added. Garage changed to General Store | 16/07/07 |
| | A. Updated to 'as built'. | 04/04/07 |
| | Not to be scaled | |
| Project | Conversion of Old Sorting Office to Sobar - Licensed premises King Street, Clitheroe | |
| | For Hamilton Associates | |
| Title | Floor plans | |
| Drawing number | 196.100B | 1:100 11/05 |


MICHAEL A. HARRISON
CHARTERED ARCHITECT
GREEN FARM
TATHAM
LANCASTER
LA2 8PJ

TEL: 015242 61571
MOB: 07973 861756