

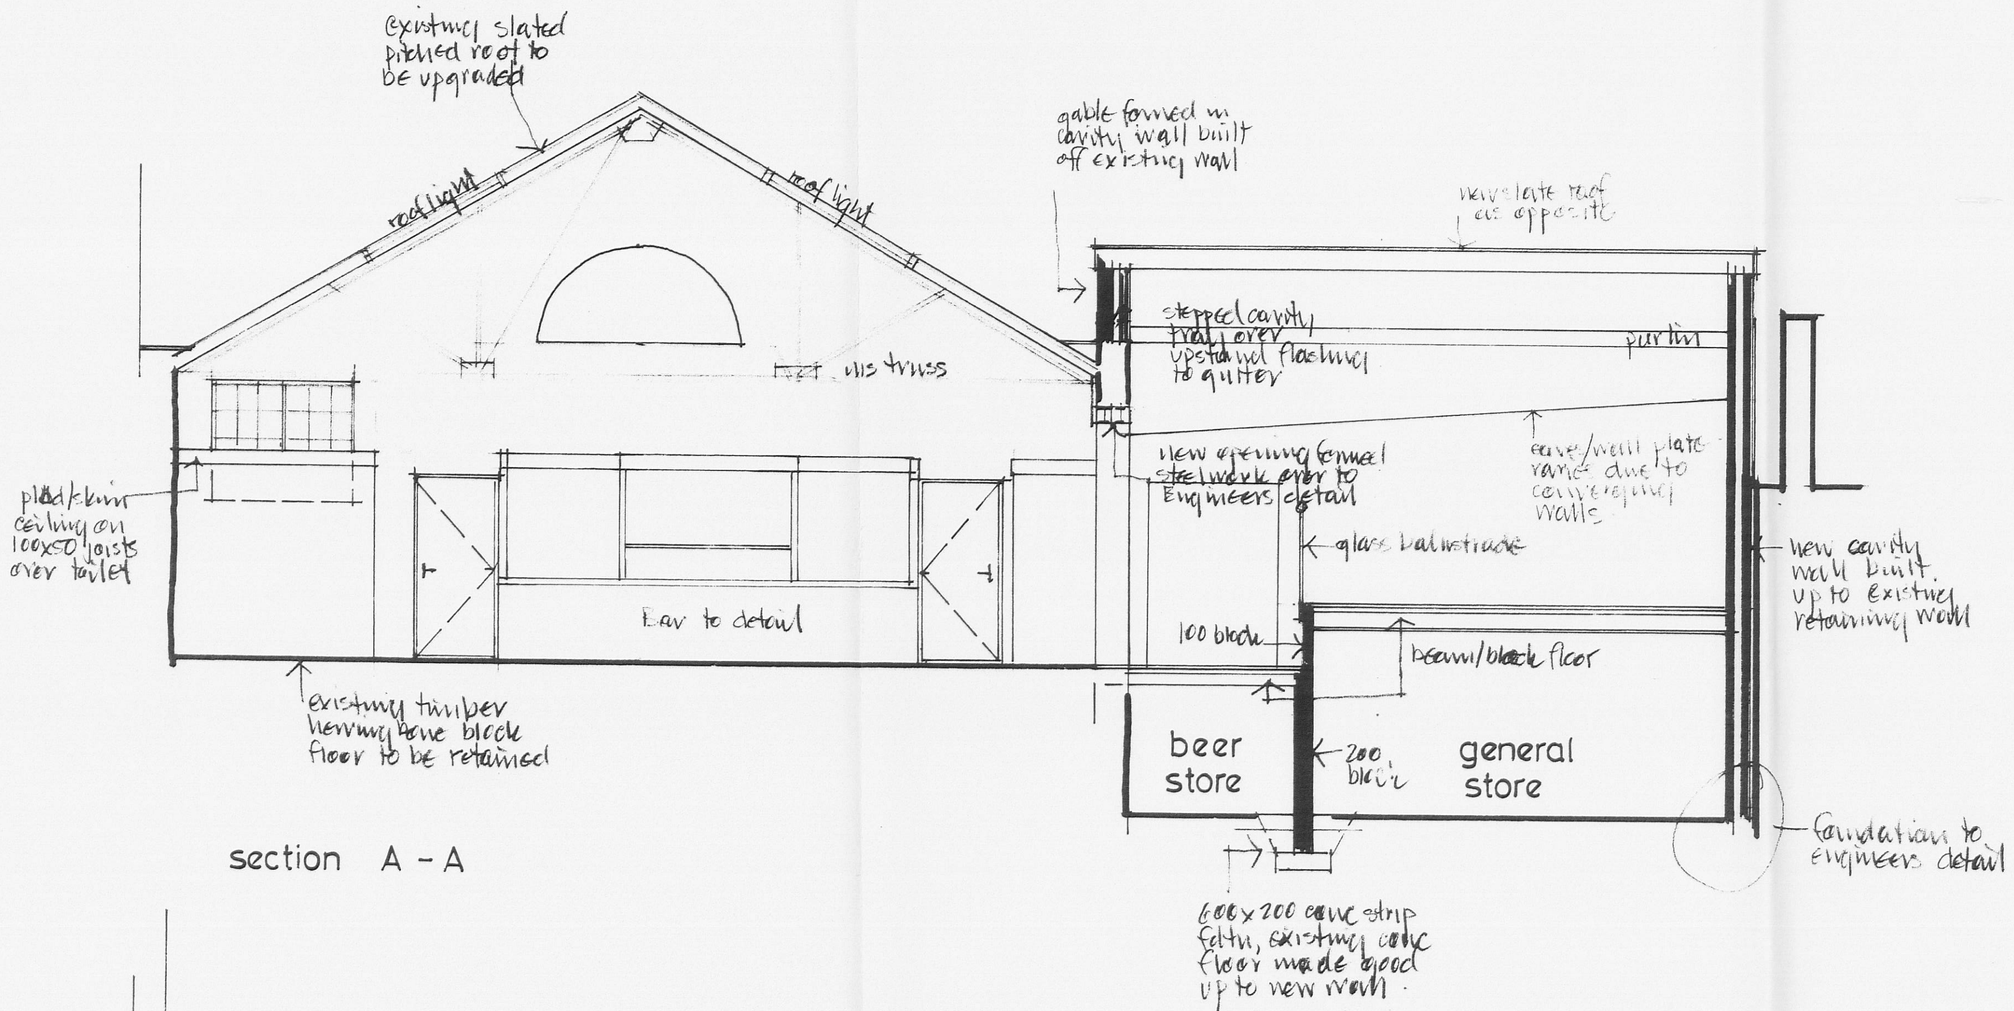


section A - A

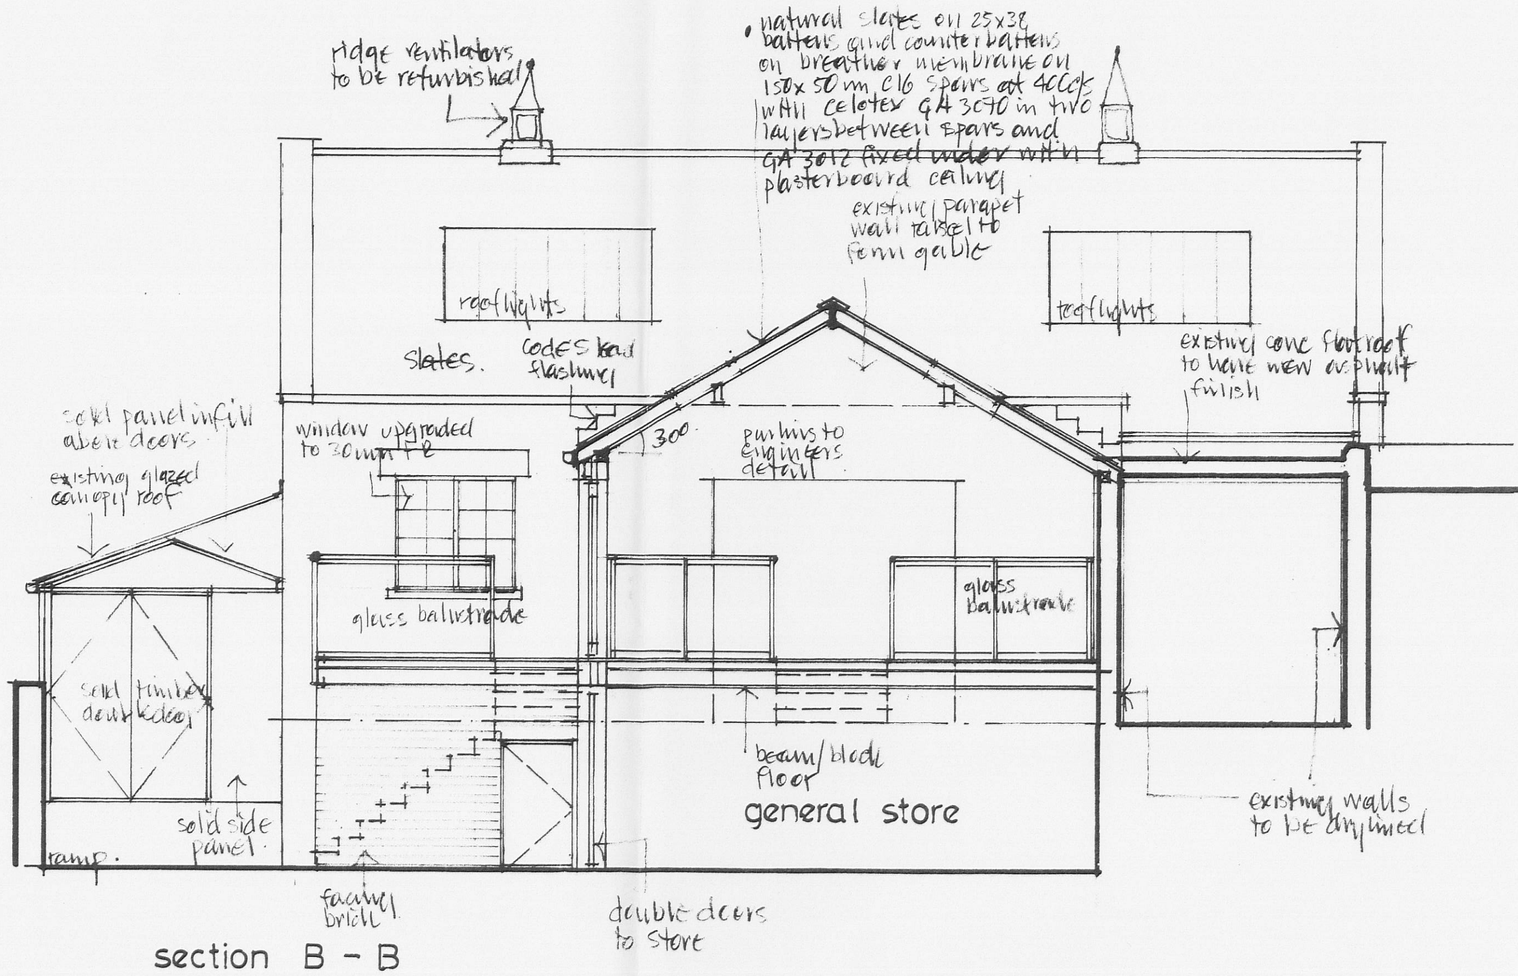


section B - B

- natural slates on 25x38 battens, grind counter battens on breather membrane on 150x50 mm C16 spars at 400c/c with celotex GA 3070 in two layers between spars and GA 3012 fixed under with plasterboard ceiling
- Existing concrete flat roofs to be upgraded as follows:- mastic asphalt on BS 747 type 4A roofing, membrane on sand/cement screed to falls min 65 mm thick on 500g polythene on celotex GA3090 on vapour barrier laid on thoroughly cleaned concrete
- Existing slate roof to be upgraded as follows:- celotex GA3070 fixed to existing spars through existing plaster ceiling with taped joints and plasterboard/skim finish
- Existing solid external walls to be upgraded as follows:- dry lining of celotex GA 3045 with taped joints, 25x50mm sw battens fixed through insulation with 12mm plasterboard and skim finish
- New external walls to be 100mm cavity block inner leaf, celotex CW3045, 50 cavity 100 cavity block or facing brick external leaf

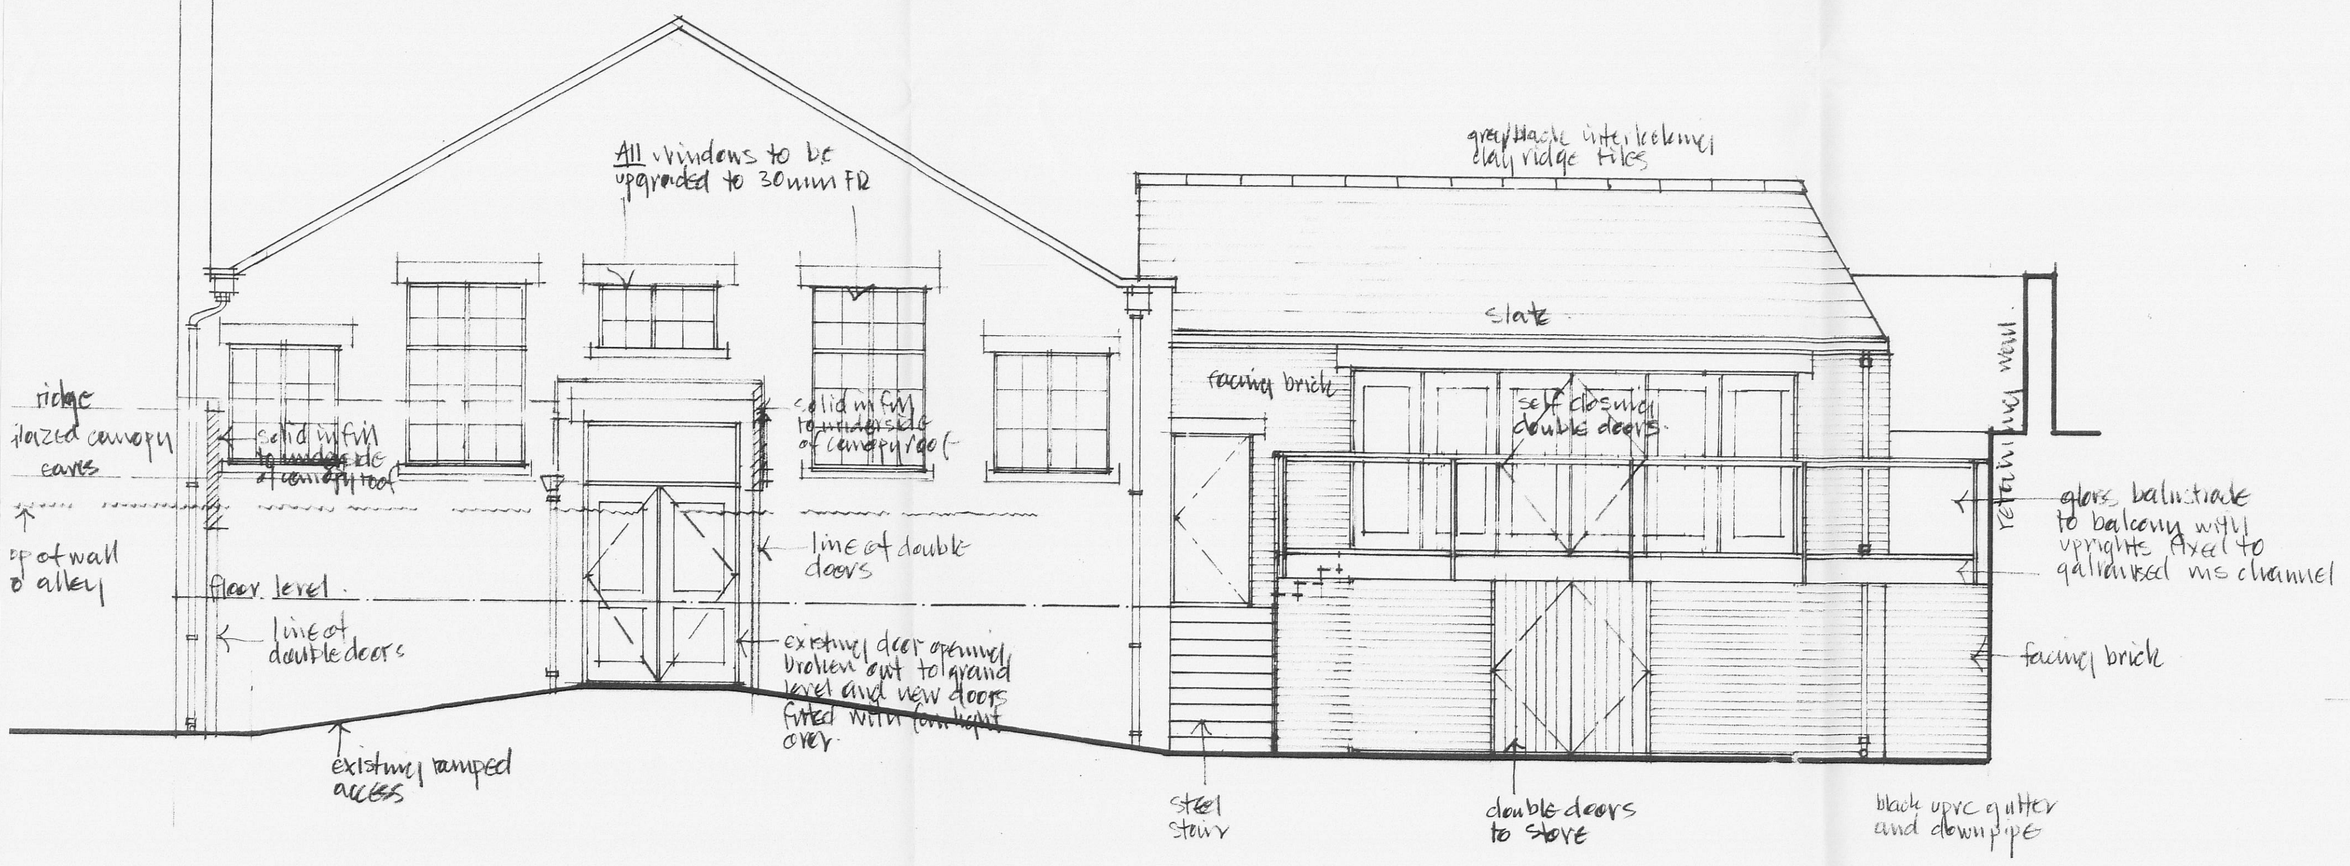

elevation to alley

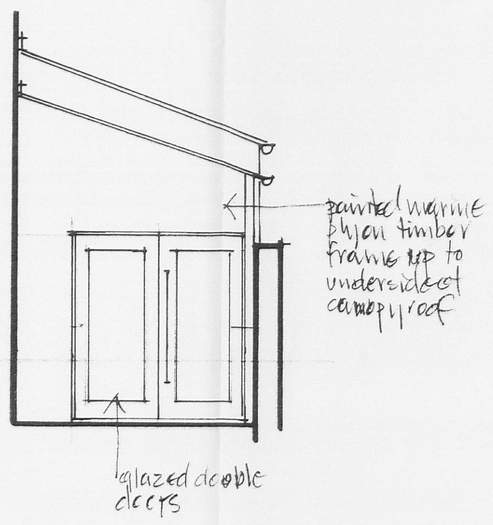

section C - C

320070721P

Revisions		
	B. Lobby added, garage changed to General Store	16/07/07
	A. Updated to 'as built'	04/04/07

Not to be scaled

Project: Conversion of Old Sorting Office to Licensed premises, King Street, Clitheroe

For Hamilton Associates

Title: Sections and elevations

Drawing number: 196.101B | 1:50 | 11/05

MICHAEL A. HARRISON
CHARTERED ARCHITECT
GREEN FARM
TATHAM
LANCASTER
LA2 8PJ

TEL: 015242 61571
MOB: 07973 861756