Notes:

All work is to be carried out to the latest current British standards Codes of Practice and recognised working practices.

All work and materials should comply with Health and Safety legislation and to be approved by the Local Authority Planning / Building Control Officer.

All dimensions are in millimetres unless where explicitly shown otherwise.

The contractor should check and clarify all dimensions as work proceeds and notify the design team of any discrepancies.

Do not scale off the drawings, if in doubt ask.

Avalon Chartered Town Planning are not liable for work undertaken prior to Full Planning Consent and/or Building Regulations Approval

Original Contour Line

As Built Contour Line

B-B

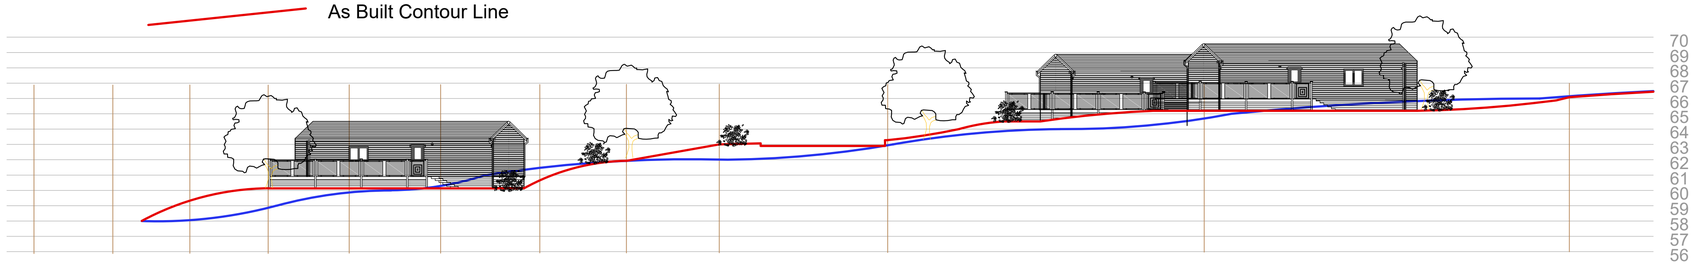

Original Contour Line

As Built Contour Line

A-A

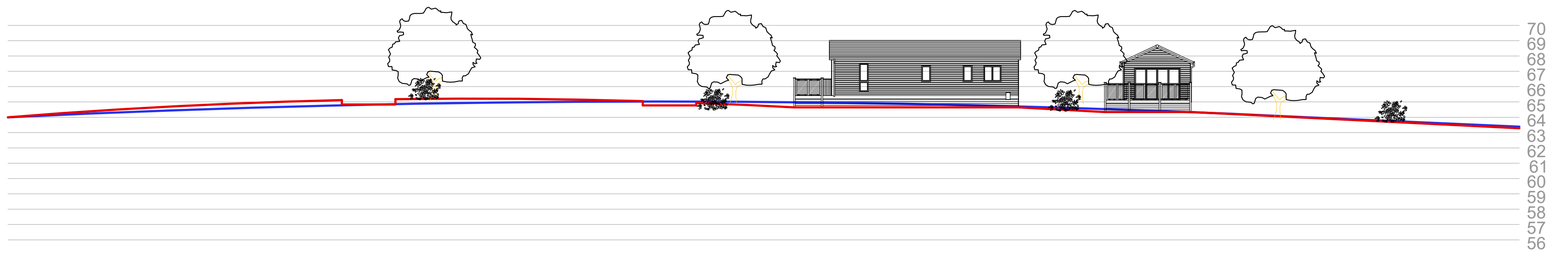

Avalon RTPI
Chartered Town Planning
Town Planning - Architectural Design - Building Regulations - Surveying
2 Reedley Business Centre, Redman Road, Burnley, Lancashire, BB10 2TY
Phone: 01282 834834
Email: brian@avalontownplanning.co.uk
darrell@avalontownplanning.co.uk
alex@avalontownplanning.co.uk

PROPOSED SECTIONS PLAN

Site: Proposed Development
Land at Aspinall Farm
Brockhall Village
Langho

Client: Ribble Valley Veiw

Date: 06.09.19 | **Scale:** 1:200 @ A1

Project No: SIMPS/01 Dwg 07 | **Drawn:** AxK

Amendments: