

# roof and site plan

Stanton Andrews do not accept liability for any loss or degradation of information held in the drawing resulting from the translation from the original file format to any other file format or from the recipient's reading of it in any other programme or on another version of the programme. Stanton Andrews accepts no liability for use of this drawing by parties other than the party for whom it was prepared or for purposes other than those for which it was prepared.

DWG issues - when this drawing is issued in DWG format it is an uncontrolled version and is provided to enable the recipient to prepare its own documents/drawings for which it is solely responsible. It is based on background information current at the time of issue. Stanton Andrews accepts no liability for any alterations, additions to or discrepancies arising out of changes to such background information which occur after it has been issued by Stanton Andrews.

This drawing must be printed in colour, if this text is not RED the drawing must be reprinted.

Do not scale, use figured dimensions only. All dimensions to be checked on site. This drawing should be printed and read at the original size, as stated in the block. Stanton Andrews accept no responsibility for errors that occur as a result of reviewing this drawing at any other size. Stanton Andrews to be notified of any discrepancies before proceeding.

Drawing is to be read in conjunction with all relevant consultants and specialist drawings. (As existing) drawings based on information provided by others - no measured survey of the property has been undertaken by the architect. This drawing is subject to copyright.

revision	date	note
A	19.07.2019	issued for pre-app
B	10.2020	submitted for planning
C	01.2021	amendments for highways
D	11.2021	amendments for highways

broken red line surrounding the garden centre buildings indicates extent of existing arrangement (including polytunnels)

staff and servicing/delivery access moved along worston road (broken red line indicates existing) to suit proposed extensions to garden centre

red hatch indicates 2.4x43m visibility splays to staff/servicing access

service yard to incorporate delivery bay to maintain possibility of two-way traffic

turning head sized to accommodate articulated vehicles (indicative vehicle tracking illustrated in grey) - turning head to operate as a holding area should it be necessary at busy periods

hatched area to service yard indicates storage area for goods delivered to site. broken lines indicate pallets/containers

existing hedge previously separating site (broken blue line) to be grubbed up and replanted along new boundary

customer vehicular access moved along clitheroe road (broken red line indicates existing) providing regularised parking arrangement and additional forecourt to sales area

red hatch indicates 2.4x43m visibility splays to customer access

site entrance landscaped to provide 'green' buffer whilst maintaining existing gas tank


parking arrangement reconfigured and orientated to face the garden centre - tree lined parking runs breaking up the hard surfacing - see drg.no.1859/PL10-11

arrows indicate principal entrance to garden centre along proposed 'market street' - entrance largely as existing (re-presented).

car parking beyond original hedge line (broken blue line) arranged to avoid disruption to existing tree root protection areas (broken magenta lines) - see drg.no.1859/PL11

tree canopy profile labelled 'trees removed' indicates grouping of low quality ash and hawthorn trees to be removed to suit arboricultural assessment/advice

proposed replacement tree planting to central island of overspill parking area

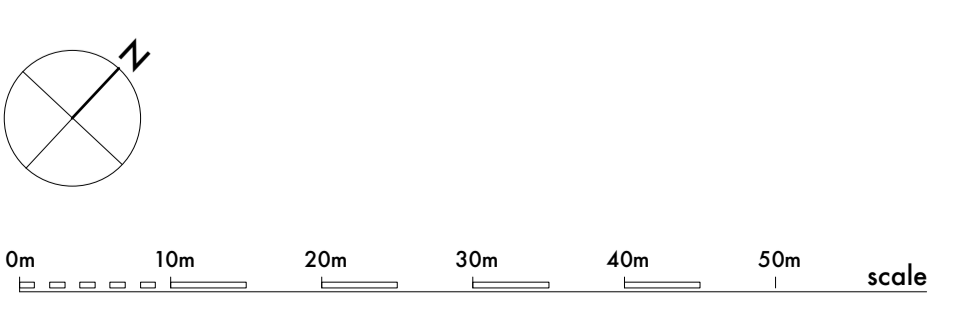

**stanton andrews**  
architects

44 york street clitheroe BB7 2DL  
t. 01200 444490 e. mail@stantonandrews.co.uk w. stantonandrews.co.uk

Chartered Practice

---

project  
**shackletons home & garden**

name  
**proposed site plan**

scale  
1 to 500 @ A1

project number  
**18.59**

date  
02.19

status  
planning

drawing number  
**PL.01**

revision  
D