

SURFACE WATER PRINCIPLES

NPPF HIERARCHY OF SURFACE WATER DRAINAGE

THE NATIONAL PLANNING PRACTICE GUIDANCE SETS OUT THE HIERARCHY OF DRAINAGE TO PROMOTE THE USE OF SUSTAINABLE DRAINAGE SYSTEMS, BY AUGMENTING MODERN DRAINAGE SYSTEMS WITH NATURAL WATER PROCESSES. THE AIM OF HIERARCHY OF DRAINAGE IS TO PROMOTE SURFACE WATER RUN-OFF AS SUSTAINABLE, AS REASONABLY PRACTICABLE.

AS STATED IN THE NATIONAL PLANNING PRACTICE GUIDANCE, THE AIM SHOULD BE TO DISCHARGE SURFACE WATER RUN-OFF AS HIGH UP THE DRAINAGE HIERARCHY, AS REASONABLY PRACTICABLE:

- INTO THE GROUND (INFILTRATION)
- TO A SURFACE WATER BODY
- TO A SURFACE WATER SEWER, HIGHWAY DRAIN, OR ANOTHER DRAINAGE SYSTEM
- TO A COMBINED SEWER

INFILTRATION

AN EXISTING SOMAWAY ON SITE CAN BE SEEN TO BE INEFFECTIVE DESPITE MAINTENANCE. THIS IS RESULTING IN WATER EMERGING AT THE SURFACE AND HAS FORMED ITS OWN CHANNEL THROUGH THE EXISTING CAR PARKING AREA TOWARDS THE RAILWAY. SOILSCAPERS HAVE PRESENTED THAT THE SOIL IN THE AREA OF THE PROPOSED DEVELOPMENT CAN BE FOUND AS SANDY AND CLAYEY. FURTHER DESKTOP STUDY WAS UNDERTAKEN ON BOSS BOREHOLES HAVE BEEN FOUND IN GIBBURN, WHICH PRESENTED SOFT TO FIRM BROWN SANDY SILTY CLAY. AS THESE ARE BOTH CONSISTENT, THIS WOULD EXPLAIN THE EXISTING SOMAWAY BEING INSTALLED.

WATERCOURSE

IF INFILTRATION HAS BEEN DISCOUNTED AS A VIABLE SOLUTION, THE NEXT METHOD IN PRIORITY SHOULD BE TO DISCHARGE TO WATERCOURSE OR SURFACE WATER BODY.

AN ASSESSMENT OF THE UK RIVER MAPS HAS IDENTIFIED THAT THERE ARE NO NEARBY WATERCOURSES.

SURFACE WATER SEWER

EXISTING SURFACE WATER FLOWS ARE CURRENTLY DIRECTED TOWARDS THE RAILWAY DUE TO THE FAILED EXISTING SOMAWAY. IT IS UNDERSTOOD THAT FLOWS ARE NOT ALLOWED TO BE DISCHARGED IN THE DIRECTION OF THE RAILWAY ASSET AND THEREFORE IS PROPOSED THAT ALL SURFACE WATER RUN-OFF IS COLLECTED BY RAIN WATER PIPES AND CHANNEL DRAININGS/GULLIES AND FLOWS ARE DIRECTED TOWARDS THE ATTENUATION TO LEAVE SITE AT A RESTRICTED RATE.

COMBINED SEWER

A REVIEW OF THE UNITED UTILITIES SEWER RECORDS SHOW A COMBINED SEWER OUTSIDE THE SITE WHICH WOULD BE PRACTICABLE TO CONNECT TO. HOWEVER GIVEN THE ABOVE INFORMATION REGARDING SURFACE WATER SEWERS, IT WOULD BE MUCH MORE VIABLE TO MAKE A CONNECTION TO AN EXISTING SURFACE WATER SEWER PROVIDING THE NPPF HIERARCHY OF SURFACE WATER DRAINAGE.

SURFACE WATER DESIGN

RUN-OFF RATES

A REVIEW OF THE EXISTING SITE TOPOGRAPHICAL SURVEY HAS IDENTIFIED THE PRESENCE OF A POSITIVELY DRAINED EXISTING BUILDING. HOWEVER, IN LINE WITH CURRENT GUIDANCE PROVIDED BY THE L1/A, IF THE EXISTING DRAINAGE SYSTEM IS NOT USED IN ITS ENTIRETY FOR THE PROPOSED DEVELOPMENT THE DISCHARGE RATE MUST REVERT TO GREENFIELD. CALCULATIONS HAVE BEEN UNDERTAKEN FOR THE EXISTING SITE AND THE DISCHARGE RATE HAS BEEN DETERMINED TO BE 2.77% WITH UNITED UTILITIES CURRENT GUIDANCE THE MINIMUM DISCHARGE RATE CONNECTING INTO A PUBLIC SEWER SHOULD BE 5%. THEREFORE THE PROPOSED DISCHARGE RATE FOR THE DEVELOPMENT SHOULD BE RESTRICTED TO 5%.

- REFER TO PWA CALCULATION 22045-00-XX-CA-C-1000 FOR GREEN FIELD ANALYSIS
- REFER TO PWA DRAWING 22045-00-XX-DR-C-1000 FOR EXISTING IMPERMEABLE AREA PLAN

PROPOSED DRAINAGE SYSTEM

TO RESTRICT PROPOSED FLOWS TO A RATE OF 5%, THE PROPOSED DRAINAGE SYSTEM SHOULD SEEK TO IMPLEMENT SOURCE CONTROL, SUDS METHODS WHERE POSSIBLE AND AN ATTENUATION SYSTEM TO STORE THE RESTRICTED FLOWS. OUR PROPOSED SYSTEM COMPRISES OF AN ATTENUATION STORAGE PIPE LOCATED AT THE NORTHERN SIDE OF THE PROPOSED UNIT. THE SURFACE WATER WILL BE PUMPED TOWARDS THE SITE ENTRANCE BY A RISING MAIN AT 5% BEFORE REACHING A SURFACE WATER MANHOLE WHICH ALLOWS THE SYSTEM TO FLOW BY GRAVITY INTO THE EXISTING SURFACE WATER SEWER. DUE TO THE RISING MAIN, PUMPING SURFACE WATER FLOWS TO 5%, THIS NEGATES THE NEED FOR A FLOW CONTROL MANHOLE BEFORE THE CONNECTION TO THE EXISTING SEWER.

BASED ON THE PROPOSED IMPERMEABLE AREAS, THE REQUIRED ATTENUATION FOR A 1 IN 100-YEAR STORM EVENT + 30% CLIMATE CHANGE IS CALCULATED AT 700m³.

- REFER TO PWA DRAWING 22045-00-XX-DR-C-1000 FOR PROPOSED IMPERMEABLE AREA
- REFER TO PWA CALCULATIONS 22045-00-XX-CA-C-1001 FOR ATTENUATION VOLUME ESTIMATE

PRELIMINARY ATTENUATION DESIGNS ARE BELOW:

MAN HOLES

3.0m dia = 7.069m²/m DEPTH
 2 no. 3.0m dia AT 2m DEPTH = 28.27m³

PIPE WORK

1.2m dia PIPEWORK = 1131m³/m DEPTH
 1.131m³/m x 49m = 55.419m³
 28.27m³ (MANHOLES) + 55.419m³ (PIPEWORK) = 83.688m³ OF ATTENUATION

FOUL WATER DESIGN


FOUL WATER STRATEGY

A REVIEW OF UNITED UTILITIES SEWER RECORDS IN THE SURROUNDED AREA SHOW THAT THERE ARE COMBINED SEWERS WITHIN THE LOCAL VICINITY OF SITE. ON SITE FOUL DRAINAGE IS ASSIGNED TO DISCHARGE TO THE COMBINED PUBLIC SEWER IN THE MAIN ROAD ADJACENT TO THE DEVELOPMENT. THEREFORE IT IS PROPOSED THAT THE FOUL WATER FROM THE PROPOSED DEVELOPMENT IS DISCHARGED INTO THE EXISTING FOUL WATER MANHOLE WITHIN SITE. A SECTION 106 SHOULD BE COMPLETED FOR THE INDIRECT CONNECTION.

ALL PROPOSED DRAINAGE IS SUBJECT TO DETAILED DESIGN AND AGREED CONNECTION LOCATIONS AND RATES

EXISTING IMPERMEABLE AREA - 1:1000

PROPOSED IMPERMEABLE AREA - 1:1000

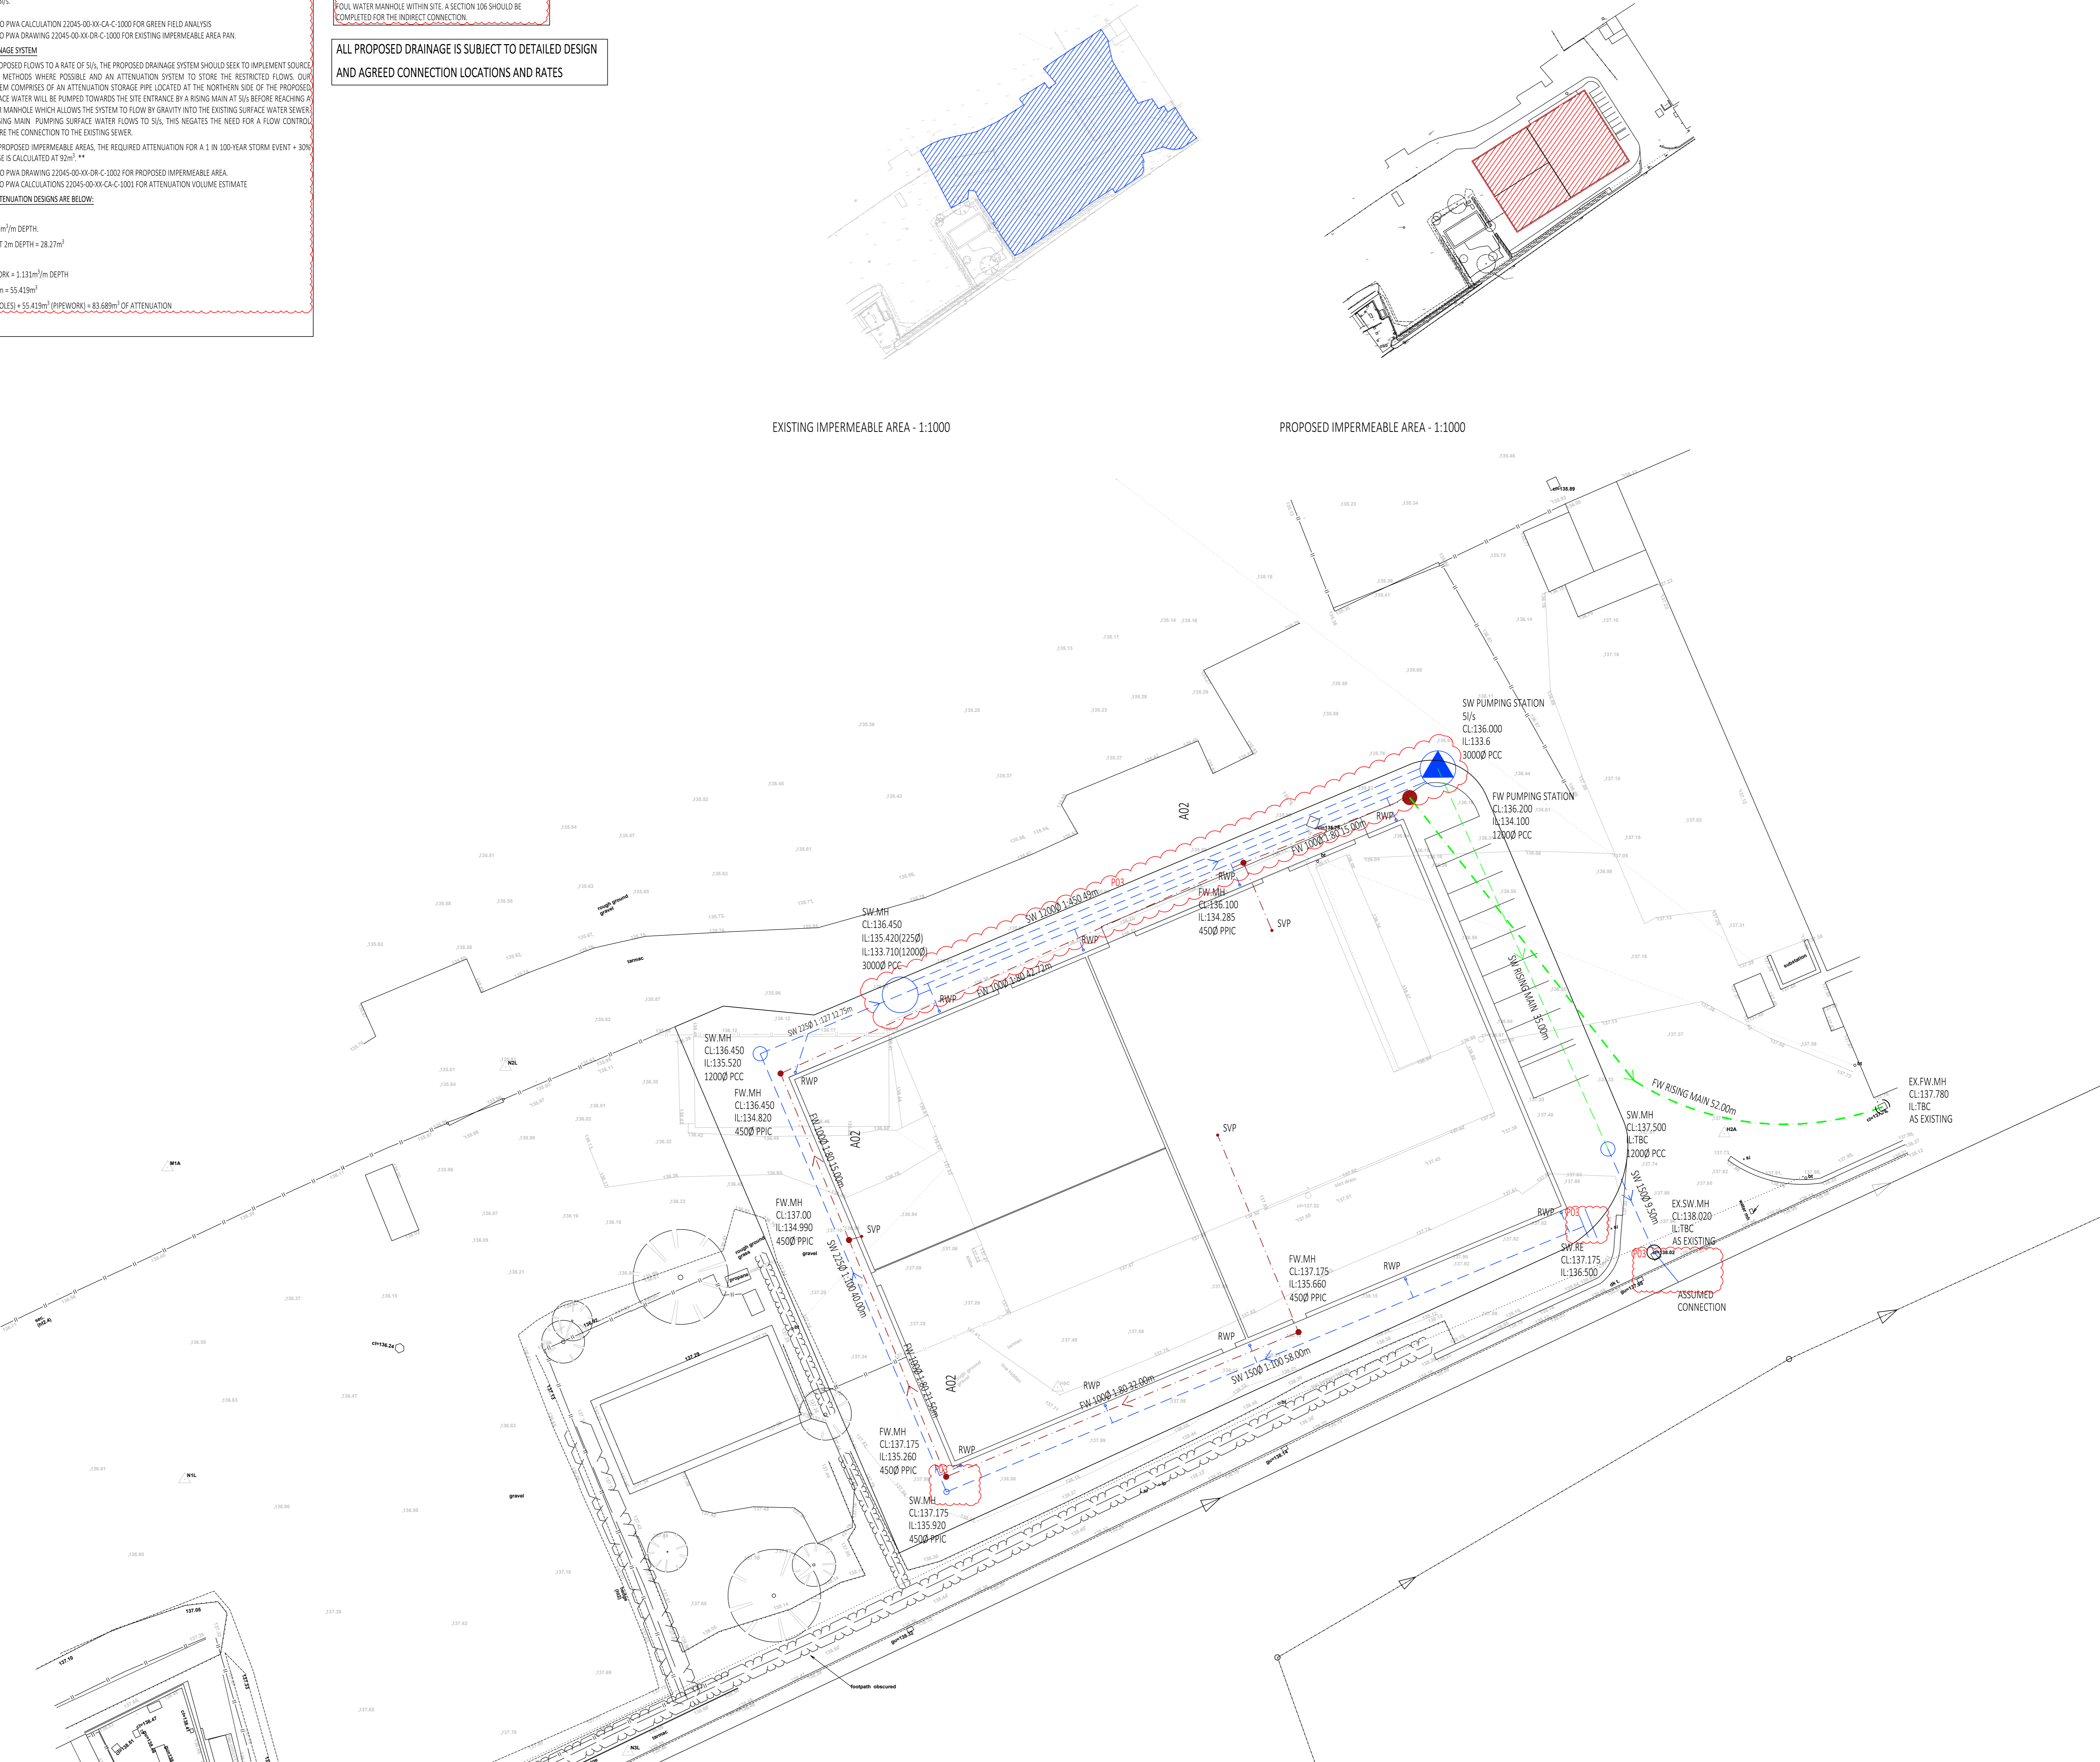

DRAINAGE STRATEGY - 1:200

NOTES

1. COPYRIGHT IN THIS DOCUMENT BELONGS TO PAUL WAITE ASSOCIATES LIMITED & ALL RIGHTS IN IT ARE RESERVED BY THE OWNER.
2. NO PART OF THIS DRAWING MAY BE COPIED, TRANSFERRED, OR MADE AVAILABLE TO USERS OTHER THAN THE ORIGINAL RECIPIENT, INCLUDING ELECTRONICALLY, WITHOUT PRIOR PERMISSION FROM PAUL WAITE ASSOCIATES LIMITED.
3. THIS DRAWING IS TO BE READ IN CONJUNCTION WITH ALL RELEVANT ARCHITECTS & ENGINEERS DRAWINGS & SPECIFICATIONS.
4. ALL DIMENSIONS ARE SHOWN IN MILLIMETRES.
5. NO DIMENSIONS ARE TO BE SCALED FROM THIS DRAWING.
6. ONLY POSITIVE COPIES OF DRAWINGS SHOULD BE REFERRED TO FOR CONSTRUCTION USE. THE USE OF AUTOCAD DRAWINGS SHOULD BE UNDERSTOOD ENTIRELY AT THE DEVELOPER'S RISK AND ALL DIMENSIONS AND SETTING OUT MUST BE CHECKED IN CONJUNCTION WITH THE ARCHITECT AND ENGINEER'S CONTROL DRAWINGS. ALL DRAWINGS SHOULD BE CONSIDERED AS LATEST ISSUES ON THE DOCUMENT. ISSUES PRIOR TO COMMENCEMENT OF WORKS AND SHOULD BE USED ONLY FOR THEIR DEFINED DRAWING STATUS. ANY DISCREPANCIES BETWEEN THE ARCHITECT AND ENGINEER DRAWINGS ARE TO BE IMMEDIATELY NOTICED TO ALL PARTIES.

GREENFIELD RUNOFF RATES.

STORM EVENT	DISCHARGE RATE
EXISTING PEAK	2.77 l/s
PROPOSED PEAK	5.00 l/s


UU GUIDANCE STATES A MINIMUM OF 5 l/s DISCHARGE TO A PUBLIC SEWER.

AREA	IMPERMEABLE CATCHMENT AREA, m ² (ha)
EXISTING IMPERMEABLE	4810m ² (0.481ha)
PROPOSED IMPERMEABLE	1988m ² (0.1.99ha)

*TOTALS FOR HECTARES (ha) AND METERS SQUARED (m²) DIFFER SLIGHTLY DUE TO ROUNDING AND ACCUMULATION OF INDIVIDUAL AREAS.

STORAGE REQUIREMENTS

STORM EVENT	STORAGE VOLUME
1 IN 100 YEAR	56m ³
1 IN 100 YEAR + CC	92m ³

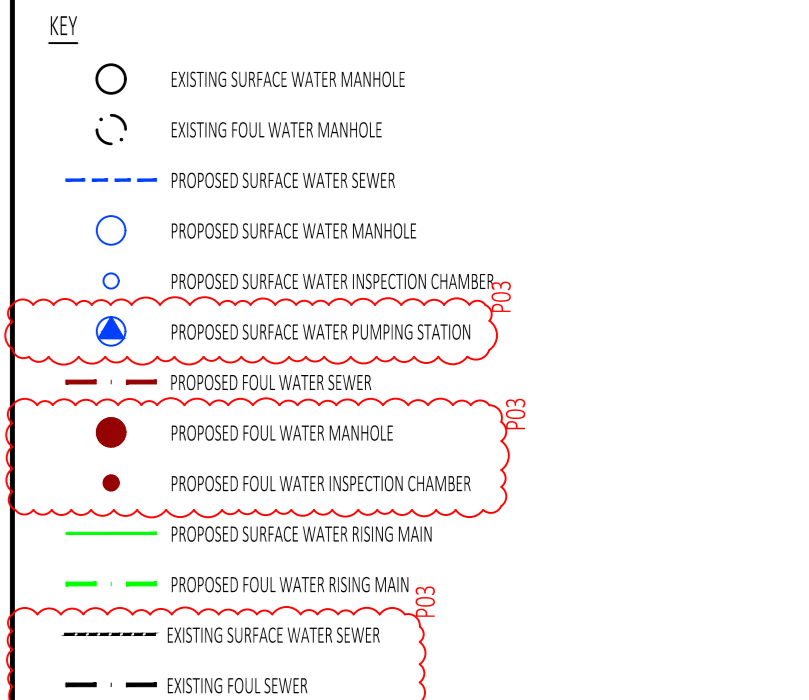


Paul Waite Associates **pwa**
 Geo-Environmental
 Consulting Civil, Structural & Geo-Environmental Engineers
 Summit House, Ryeon Way, The Crossings, Crawley, West Sussex, BN02 7BU
 T: 01293 633300 E: info@pwa.co.uk www.pwa.co.uk

Client		GIBBURN AUCTION MART	
Project		PROPOSED INDUSTRIAL DEVELOPMENT AT GIBBURN AUCTION MART LTD GIBBURN	
Task		PROPOSED DRAINAGE STRATEGY	
Date	22/06/2024	Prepared By	IB
Checked By	PMc	Decided By	JUN 22
Drawing Status: PRELIMINARY			
Job Number	22045 - PWA - 00 - XX - DR - C - 1001	Scale	PO3