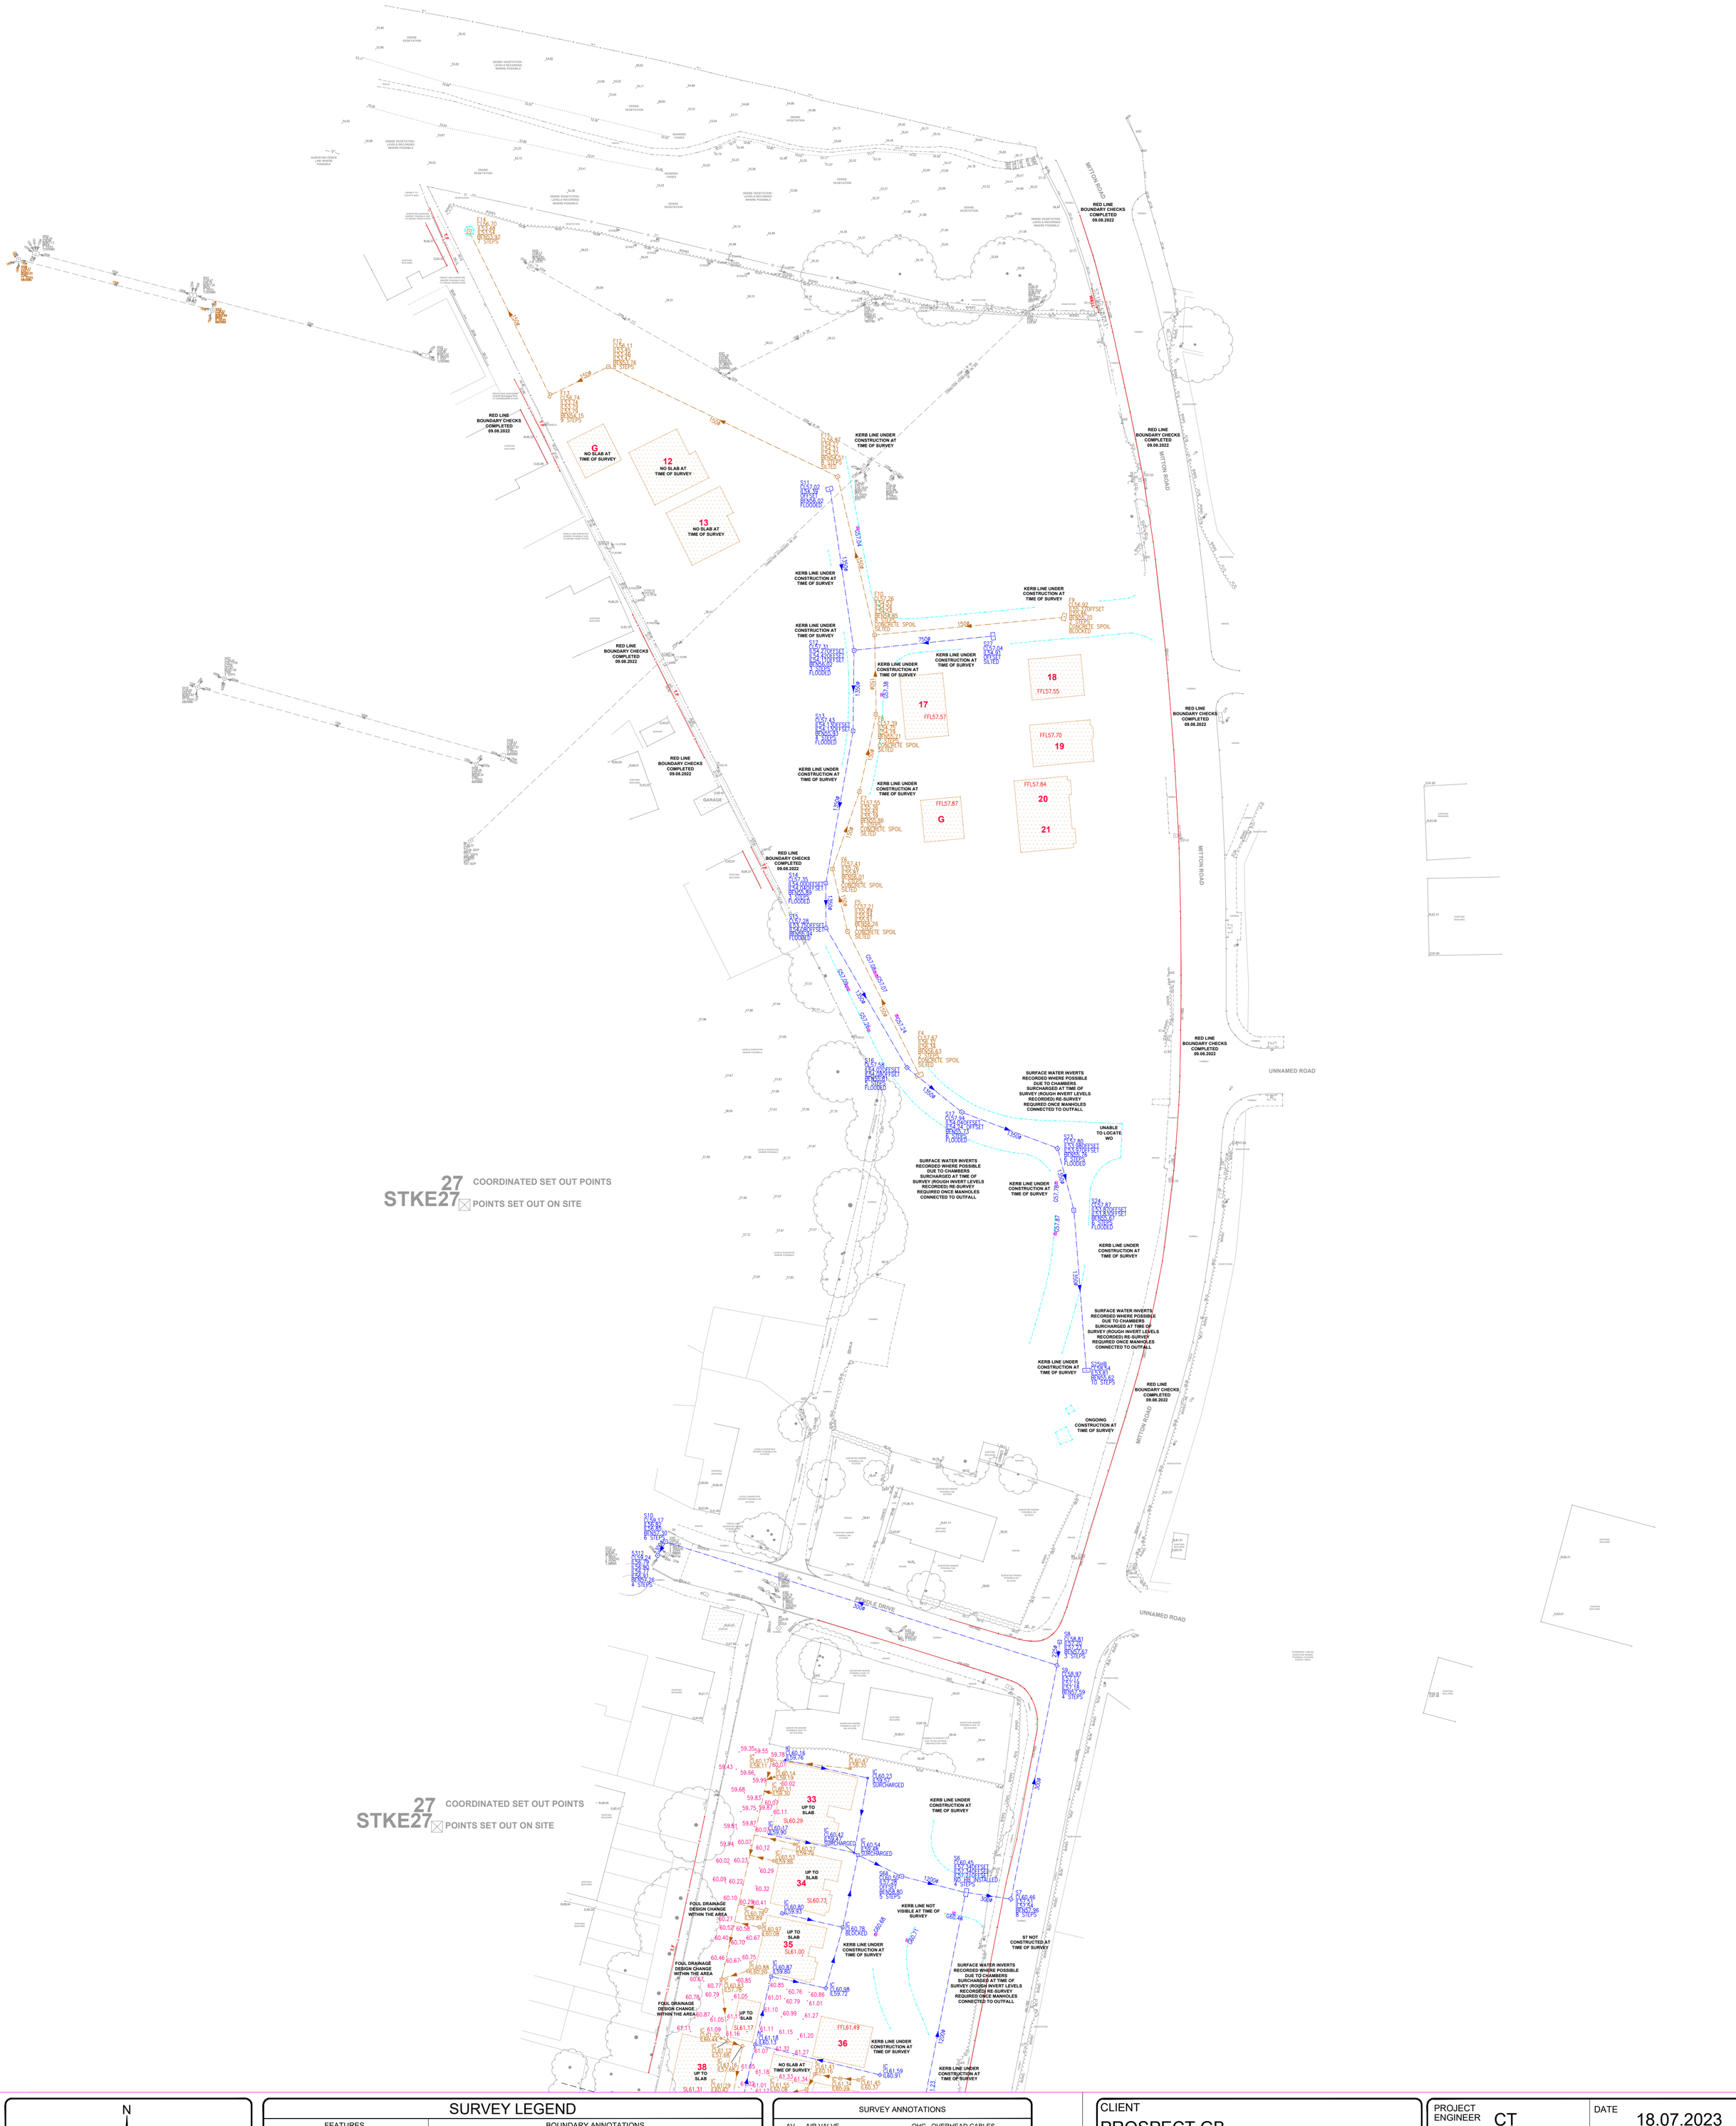

27 COORDINATED SET OUT POINTS

STKE27 POINTS SET OUT ON SITE

N

W E

S

SURVEY ORIENTATED TO OS GRID (OSGB36-15)

SURVEY NOTES

ALL LEVELS ARE RELATED TO O.S DATUM (OSGB36-15)
ESTABLISHED AT SE1 USING THE LEICA SMARTNET GPS NETWORK

ⓒ SurveyEng Limited 2023
Reproduction in whole or in part by any means is prohibited without the prior permission of SurveyEng Limited.

SURVEY LEGEND

FEATURES	BOUNDARY ANNOTATIONS			
TOP OF BANK	BARB WIRE FENCE	BW.F	SECURITY FENCE	SEC.F
BOTTOM OF BANK	CHAIN LINK FENCE	C/L.F	TIMBER FENCE	T.F
SURVEY STATION	CONC POST AND PANEL	CP&P.F	BRICK WALL	B.W
TREE	CONC POST TIMB PANEL	CP&TP.F	BLOCK WALL	BL.W
HEDGE	ELECTRIC FENCE	EL.F	CONCRETE WALL	C.W
TREE CANOPY	HERAS FENCE	HER.F	GABIEN WALL	G.W
BUSHES	IRON RAIL FENCE	IR.F	MISCELLANEOUS WALL	MISC.W
VEGETATION	KNEE RAIL FENCE	KR.F	RETAINING WALL	R.W
	MISCELLANEOUS FENCE	MISC.F	RETAINING LOG WALL	RL.W
	POST AND WIRE FENCE	P&W.F	STONE WALL	S.W
	RANCH STYLE FENCE	RS.F		

LEVEL PREFIX ANNOTATIONS

ASL	ARCH SPRING LEVEL	IL	INVERT LEVEL		
BL	BED LEVEL	PL	PARAPET LEVEL	TRH	TREE HEIGHT
BD	BACK DROP	RL	ROOF/RIDGE LEVEL	THR	THRESHOLD LEVEL
CL	COVER LEVEL	SL	SOFFIT LEVEL	WL	WATER LEVEL
DH	TOP OF DOOR	TOF	TOP OF FENCE	WS	WINDOW SILL
DTC	DEPTH TO CROWN	TOP	TOP OF PIPE	WSF	WINDOW SOFFIT
FFL	FINISHED FLOOR LEVEL	TOW	TOP OF WALL		

GEOTECHNICAL INFORMATION

TRIAL HOLE / PIT	TH
BORE HOLE	BH
WINDOW SAMPLE	WS
MONITORING POINT	MP

SURVEY ANNOTATIONS

AV	AIR VALVE	OHC	OVERHEAD CABLES
B	BOLLARD	PB	POST BOX
BS	BUS STOP	PM	PARKING METER
BT	BRITISH TELECOM IC	PS	POST
CPS	CONCRETE PAVING SLABS	PYL	ELECTRICITY PYLON
CP	CATCH PIT	RE	RODDING EYE
DR	DRAIN	RS	ROAD SIGN
EB	ELECTRIC CONTROL BOX	RWP	RAIN WATER PIPE
EL	ELECTRICAL IC	ST	STOP TAP
EP	ELECTRICITY POLE	SM	SERVICE MARKER
ER	EARTH ROD	SP	SIGN POST
FH	FIRE HYDRANT	SV	STOP VALVE / SLUICE VALVE
FP	FLAG POLE	SVP	SOIL VENT PIPE
G	GULLY	TB	TELEPHONE BOX
GH	GREENHOUSE	TL	TRAFFIC LIGHTS
GP	GATE POST	TM	TELEPHONE MAST
GV	GAS VALVE	TP	TELEGRAPH POLE
IC	INSPECTION COVER	TPS	TACTILE PAVING SLABS
JB	JUNCTION BOX	VP	VENT PIPE
JKW	JAPANESE KNOT WEED	WM	WATER METER
KO	KERB OUTLET	WO	WASH OUT
LH	LAMP HOLE	UTL	UNABLE TO LIFT
LP	LAMP POST/LIGHT COLUMN	UTS	UNABLE TO SURVEY
MH	MANHOLE		
MP	MONITOR POINT		
NP	NAME PLATE		

CLIENT
PROSPECT GB

PROJECT ENGINEER CT

DATE 18.07.2023

DRAWN DH

SCALE 1:500@A1

PROJECT TITLE
MITTON ROAD, WHALLEY

DESCRIPTION	REV	DATE	DRWN	APPR
MANHOLE SURVEY ADDED	A	29.09.23	DH	-

DRAWING DETAIL
AS BUILT SURVEY
SHEET 1 OF 2

DRAWING NUMBER PRO.AB.14

REVISION A

SurveyEng Ltd
Land Surveyors & Engineers
14 GREEN MILL
WESTHOUGHTON
BOLTON
LANCS
BL5 3GE
TEL/FAX: 0800 772 3040
MOB: 07850069993
info@surveyeng.co.uk