
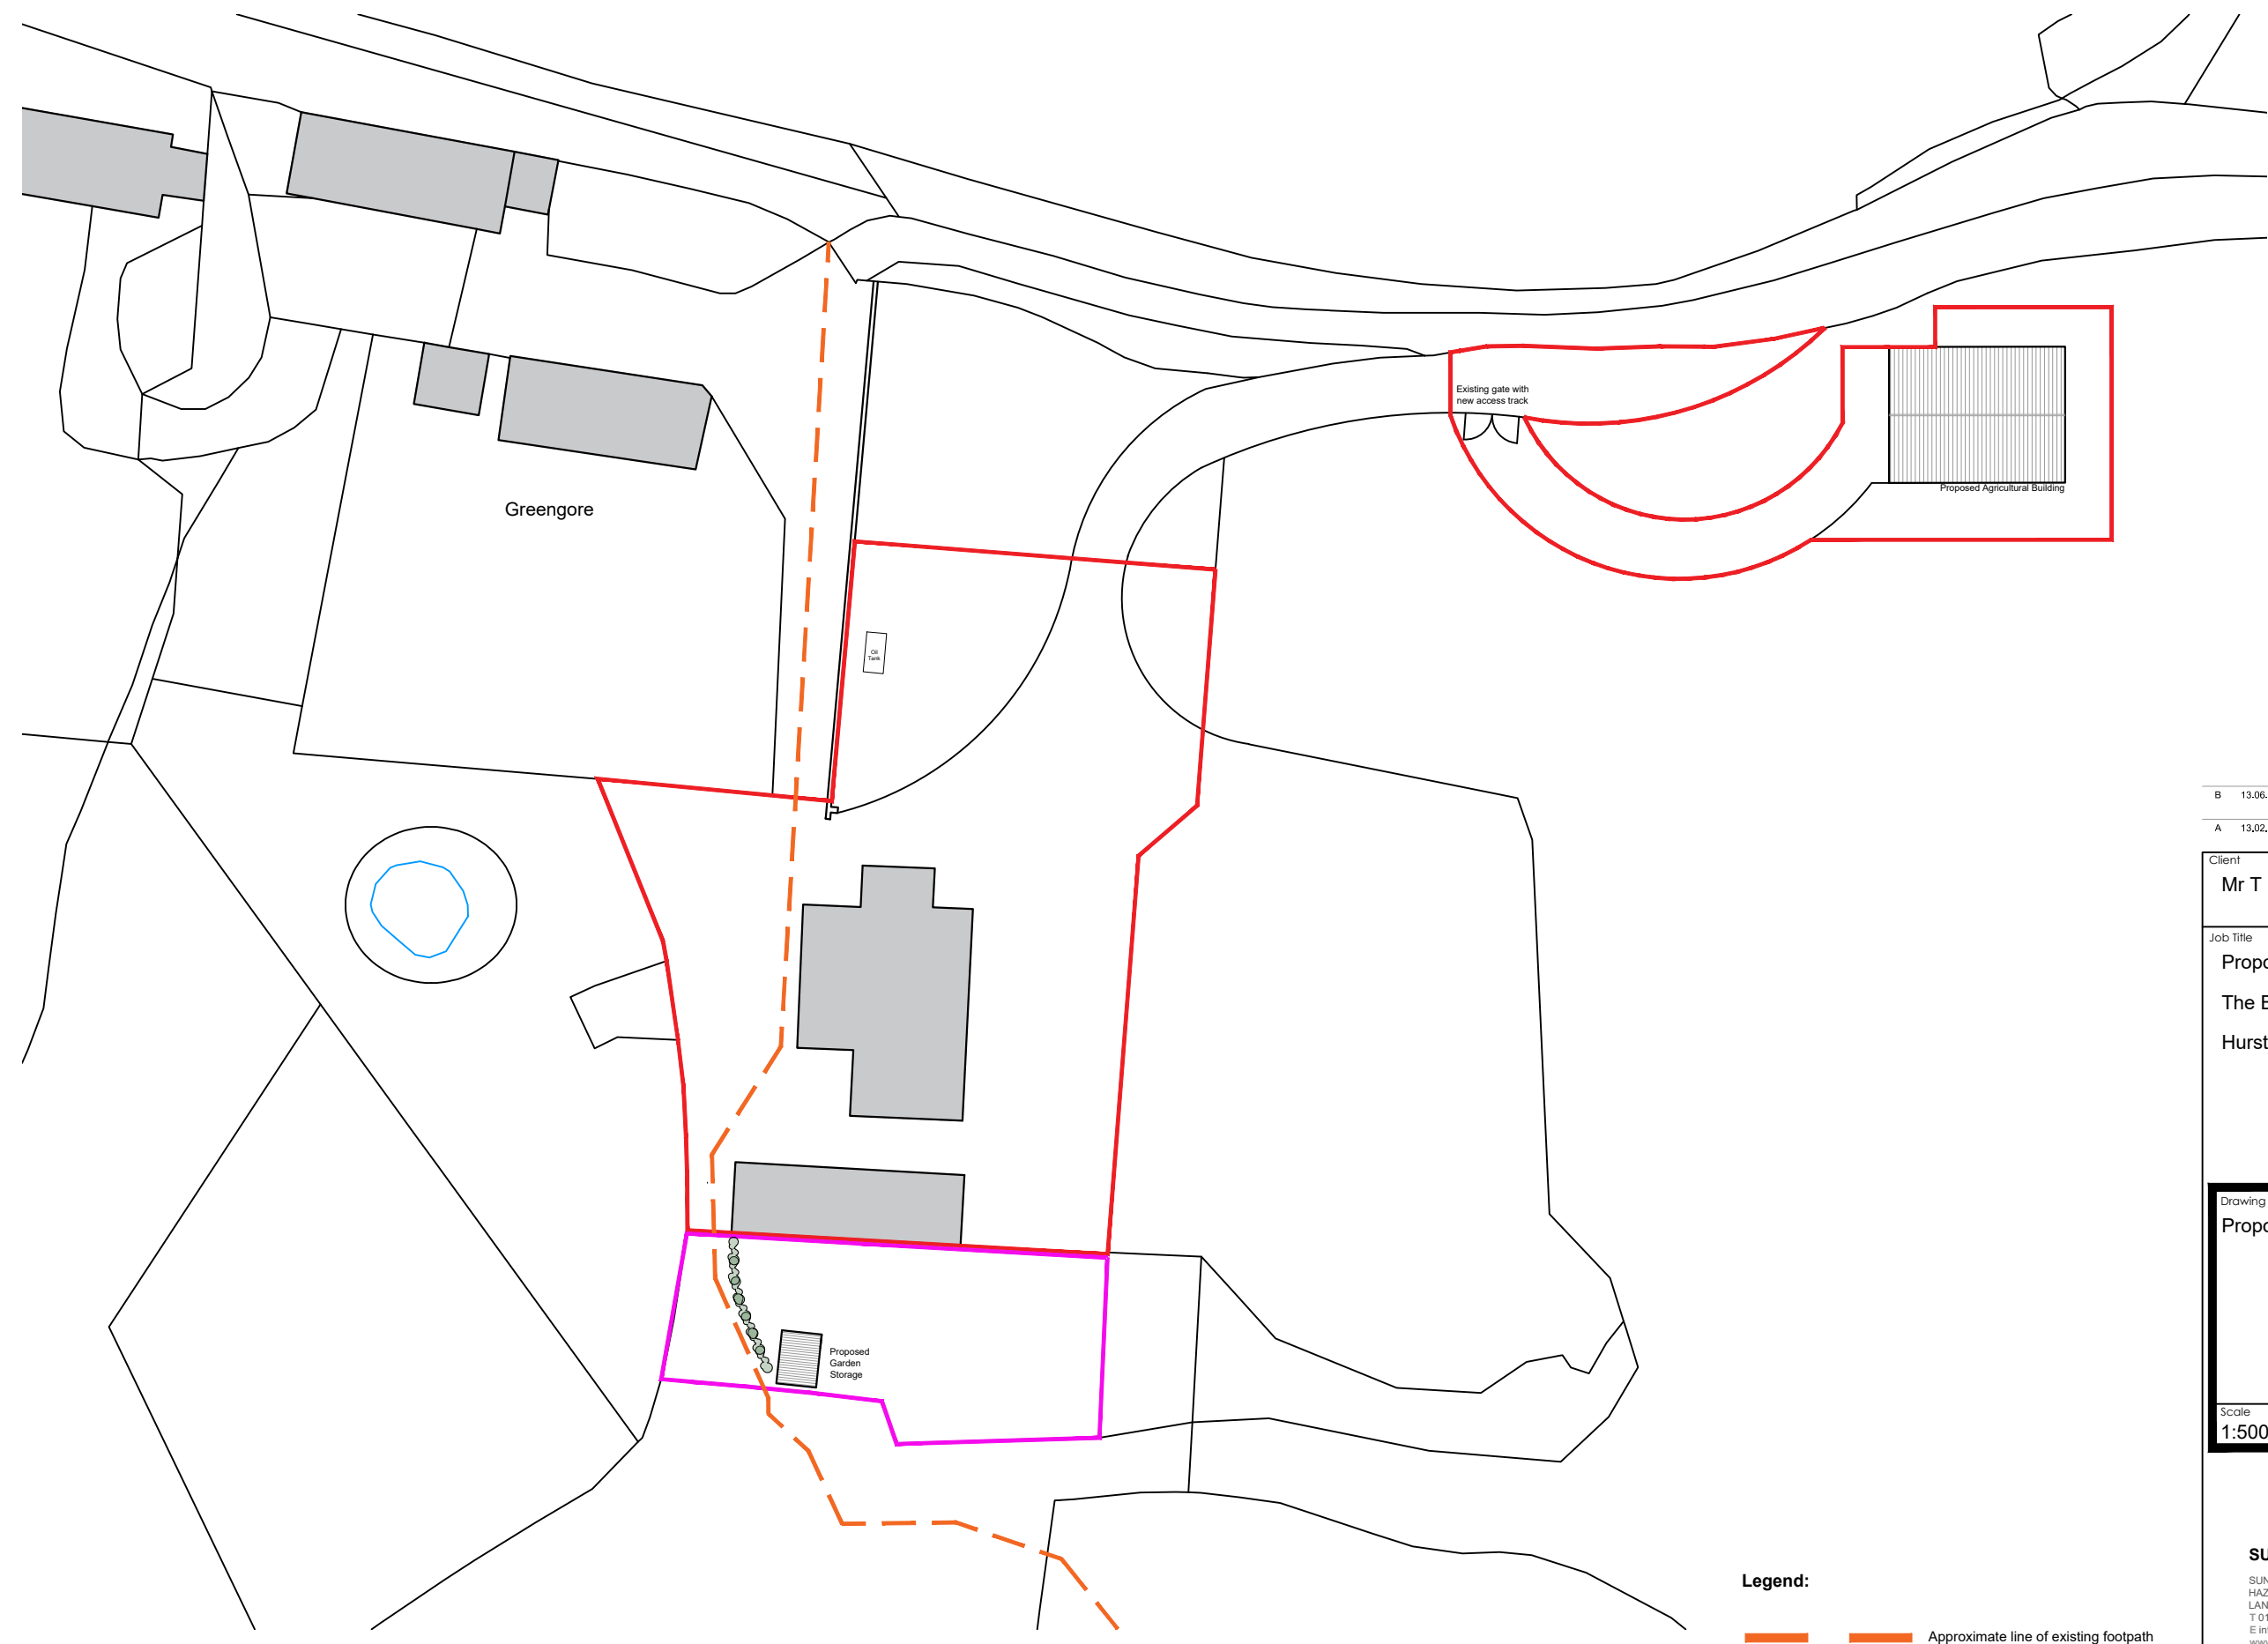


This drawing is to be read in conjunction with all relevant Architect, consultants' and specialists' drawings and specifications. The Architect is to be notified of any discrepancies before proceeding. Do not scale from this drawing. All dimensions and levels are to be checked on site. This drawing is subject to copyright. All work carried out before Planning and Building Permission has been granted is at the contractor/clients risk.
 Note: proposed drawing based on OS dwg information. All illustrated dimensions are approximate and all site dimensions are to be checked on site and subject to site survey.

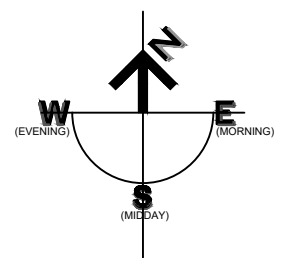

Proposed Site Plan Scale 1:500

- Legend:**
- Approximate line of existing footpath
 - Proposed residential curtilage

B	13.06.2025	Agricultural Building Reduced In Size.	CC
A	13.02.2025	Red Line Amended	BWT

Client
Mr T Bolton

Job Title
**Proposed Garage at
 The Barn at Greengore
 Hurst Green**

Drawing Title Proposed Site Plan		
Scale 1:500 @ A3	Date Dec 2024	Drawn CC

spa
 SUNDERLAND PEACOCK ARCHITECTS
 SUNDERLAND PEACOCK & ASSOCIATES LTD.
 HAZELMERE, PIMLICO ROAD, CLITHEROE
 LANCASHIRE, BB7 2AG
 T 01200 423178 F 01200 427328
 E info@sunderlandpeacock.com
 www.sunderlandpeacock.com



7042 -P01	REV B
------------------	-----------------