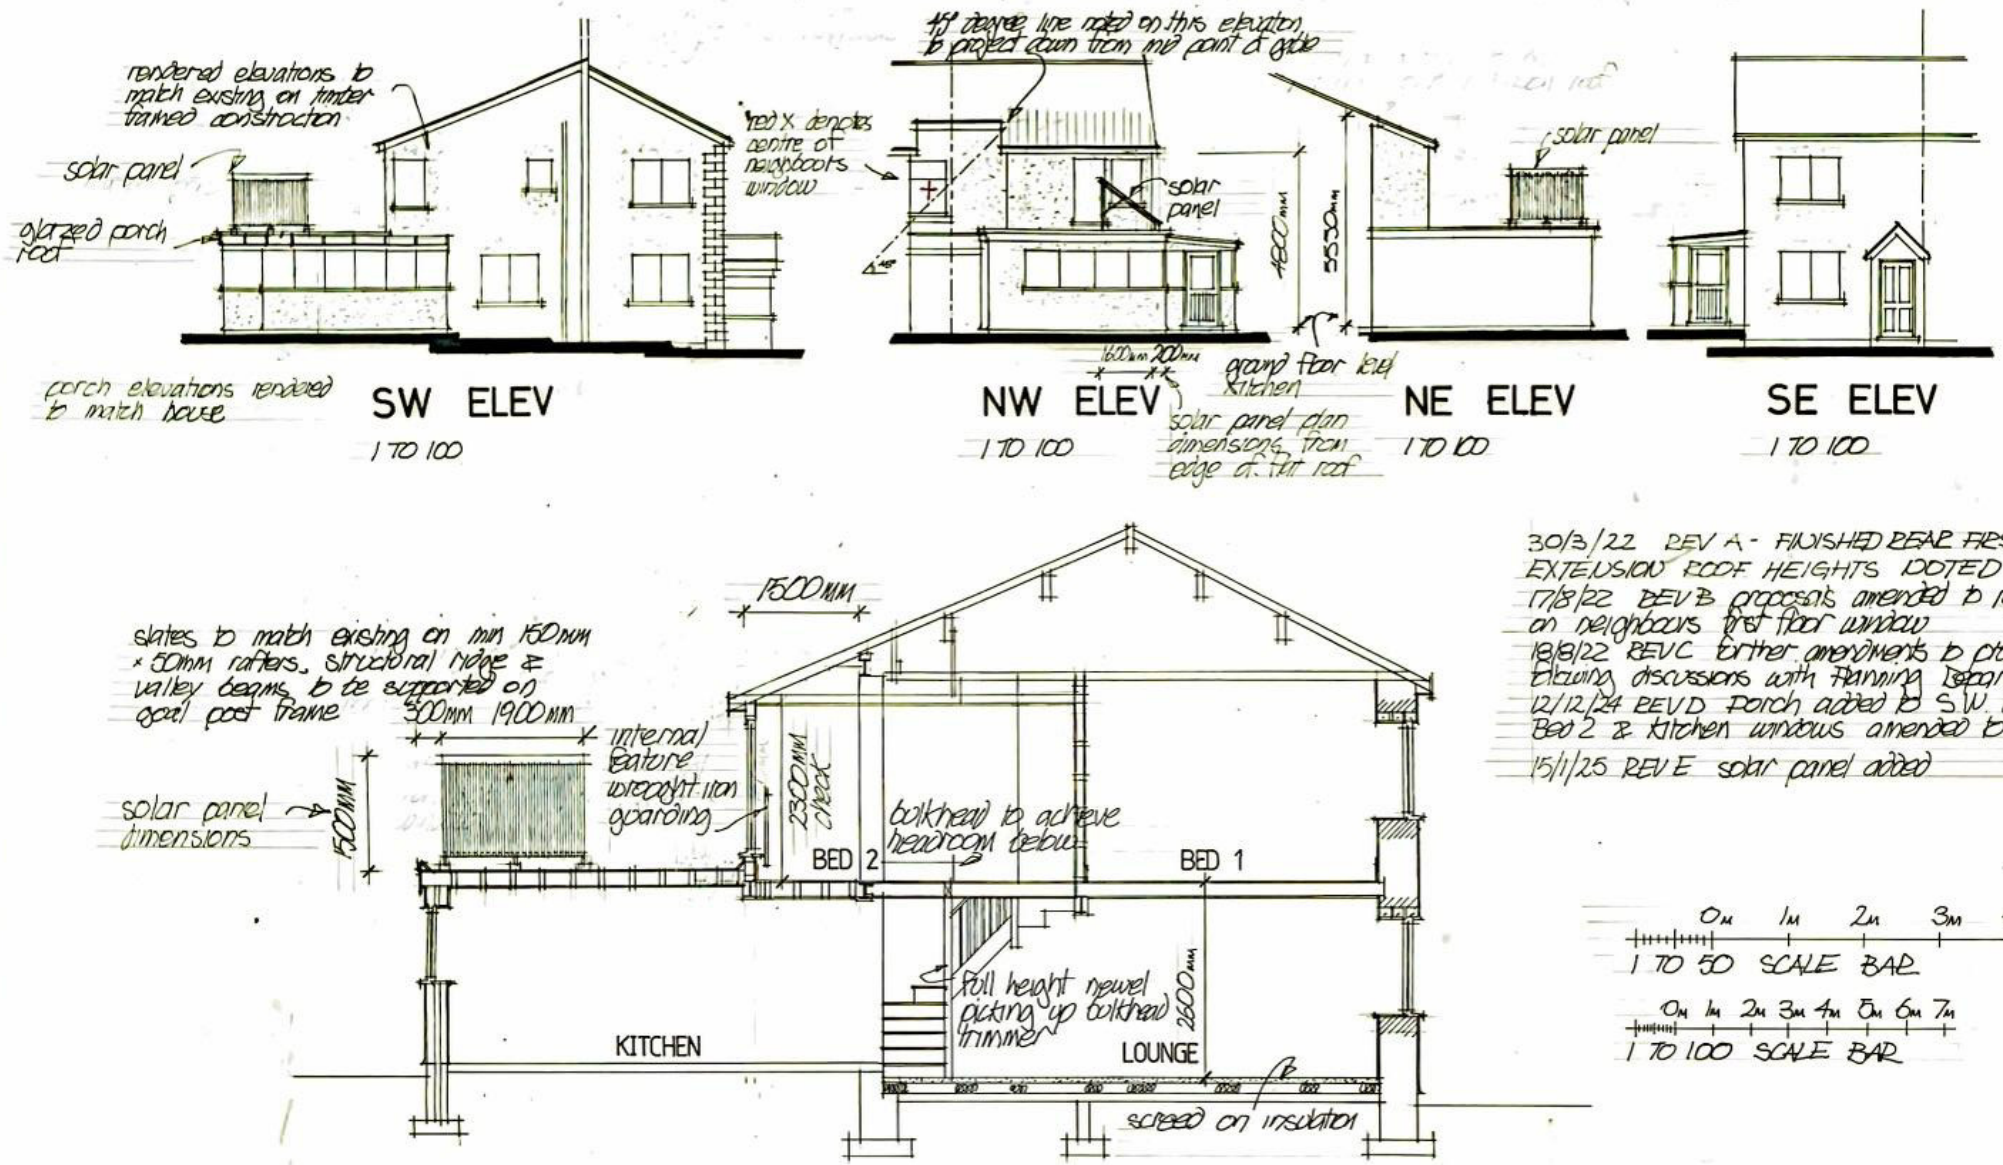

30/3/22 REV A - FINISHED REAR FIRST FLOOR EXTENSION ROOF HEIGHTS DOTTED ON ELEVS
17/8/22 REV B proposals amended to reduce impact on neighbours first floor window
18/8/22 REV C further amendments to proposals following discussions with Planning Department
12/12/24 REV D Porch added to S.W. elevation. Bed 2 & kitchen windows amended to as built
15/1/25 REV E solar panel added

0m 1m 2m 3m 4m 5m
1 TO 50 SCALE BAR

0m 1m 2m 3m 4m 5m 6m 7m
1 TO 100 SCALE BAR

proposed elevations, section

at IVY COTTAGE, FARSDOAGE RD, WILPSHIRE, BLACKPOOL BB1 4AG
for MR I. DONOGHO
scale 1 TO 50 & 1 TO 100 AT A2
date 2nd FEBRUARY 2022

DRG NO 4A/B/C/D/E